
ADDENDUM No. 6 – February 11, 2019

GENERAL

This addendum modifies, amends, and supplements designated parts of the Contract Documents for the above project and is hereby made part thereof by reference and shall be as binding as though inserted in locations designated hereunder.

It shall be the responsibility of the bidders to notify all subcontractors and suppliers he proposes to use for the various parts of the work for any changes or modifications contained in this addendum. No claim for additional compensation because of lack of knowledge of the contents of this addendum will be considered.

*****PLEASE NOTE THAT THE BID DUE DATE HAS BEEN EXTENDED TO WEDNESDAY, MARCH 6, 2019 (see below).**

***** As part of Addendum #6, all bidders are hereby being notified that there was a prior bid package referred to as “Site Enabling Bid Package #1”. Site Enabling Bid Package #1 documents (drawings and specifications) will be made available to all bidders for reference on the City of Worcester website: <http://bids.worcesterma.gov/>. Site Enabling Bid Package #1 addendum (Addendum #1 only) is included with this Addendum #6.**

SPECIFICATIONS

1. DOCUMENT 00 01 10 – TABLE OF CONTENTS (in each volume)

Page 1, DIVISION 00

Insert: “Document 00 91 11	Addendum Number 1 dated May 1, 2018 issued as part of the Site Enabling Bid Package #1 and included by reference herewith.
Document 00 91 12	Addendum Number 2 dated September 11, 2018 issued as part of the Early Site Bid Package #2 and included by reference herewith.
Document 00 91 13	Addendum Number 3 dated September 19, 2018 issued as part of the Early Site Bid Package #2 and included by reference herewith.
Document 00 91 14	Addendum Number 4 dated September 19, 2018 issued as part of the Early Site Bid Package #2 and included by reference herewith.
Document 00 91 15	Addendum Number 5 dated December 27, 2018 issued as part of the Early Structural Bid Package #3 and included by reference herewith.”

2. DOCUMENT 00 11 16 – INVITATION TO BID

Page 1, paragraph beginning with “SEALED FILED TRADE BIDS...”

Delete: “February 27, 2019”

Insert: “March 6, 2019”

3. SECTION 00 21 13 – INSTRUCTIONS TO BIDDERS

Page 3, SECTION 4, paragraph 4.5

Delete: "February 22, 2019"

Insert: "March 1, 2019"

DRAWINGS

1. None

ATTACHMENTS

DOCUMENTS:

1. Addendum #1 – Site Enabling Bid Package #1 (dated May 1, 2018): referred to in Final Bid Package Table of Contents and attached hereto.
2. Addendum #2 – Early Site Bid Package #2 (dated September 11, 2018): referred to in Final Bid Package Table of Contents and attached hereto.
3. Addendum #3 – Early Site Bid Package #2 (dated September 19, 2018): referred to in Final Bid Package Table of Contents and attached hereto.
4. Addendum #4 – Early Site Bid Package #2 (dated September 19, 2018): referred to in Final Bid Package Table of Contents and attached hereto.
5. Addendum #5 – Early Structural Bid Package #3 (dated December 27, 2018): referred to in Final Bid Package Table of Contents and attached hereto.

SKETCHES:

None

END OF ADDENDUM #6

S E-ADDENDUM No. 1 – May 1, 2018

GENERAL

This addendum modifies, amends, and supplements designated parts of the Contract Documents for the above project and is hereby made part thereof by reference and shall be as binding as though inserted in locations designated hereunder.

It shall be the responsibility of the bidders to notify all subcontractors and suppliers he proposes to use for the various parts of the work for any changes or modifications contained in this addendum. No claim for additional compensation because of lack of knowledge of the contents of this addendum will be considered.

PART 1 GENERAL

1. None

PART 2 SPECIFICATIONS

1. None

PART 3 DRAWINGS

1. Drawing EC3.0 Erosion and Sediment Control Plan has been revised based on Conservation Commission review comments, refer to the attached revised drawing.

PART 4 CM QUESTIONS AND RESPONSES

QUESTION # 1

A fencing sub would like to confirm that there are two rows of fencing along certain areas of the job. Referencing Sheet EC3.0, there appears to be a construction fence depicted with the erosion control barrier (ECB line type), around the perimeter of the site. However, there also appears to be other areas where additional fencing is called out, directly adjacent to the ECB. Could you try to clarify?

RESPONSE: Refer to the attached drawing EC3.0, revised as part of this Addendum.

QUESTION # 2

Please confirm what the limits are of the "Construction Access Road"? There are two details for asphalt paving, but only one shade on the L&M plan.

RESPONSE: All areas should be paved per the "Construction Access Road Hot Mix Asphalt Paving Detail" on EC-7.1.

QUESTION # 3

The retaining wall fencing that it will be permanent is called out, but the only details on the plans show construction fencing. Would this retaining wall fence be different in type and height?

RESPONSE: That fence will be 4 ft chain link and the details for it are in spec section 32 31 13. Details for the fence are also provided on EC7.1 in detail titled "Fence Connection Locations."

QUESTION # 4

Is sheet EP1 "Electrical Temporary Lighting Plan" part of the site work scope for the site enabling bid? If so, please provide a spec for the temporary lighting. If not, will the site contractor be responsible to provide assistance to the electrical subcontractor i.e. excavate and backfill trenches and installing bases?

RESPONSE: The actual electrical work will not be by the site contractor but they will be providing assistance as noted. There is also a request in the scope to provide a unit price for temp light poles.

QUESTION # 5

Bid Alternate #2 in the subcontractor scope of work states "remove and salvage existing lighting." The site demolition plan shows to maintain and protect existing lighting. Please clarify.

RESPONSE: Alternate two is for the small parking area at the Sullivan school and the note only applies to the poles in that area (2 total). Poles that are currently operating will be protected and the poles that are inoperable will be removed and disposed of

QUESTION # 6

There are three different details depicting construction fence on the plans (EC7.0); Chain Link Construction Fence, Temporary Chain Link Construction Fence With Ballast Bases, and Perimeter Erosion Control Barrier-Super Silt Fence. All three have differing heights and construction parameters (top rail/tension wire). Could you please confirm the following regarding the fencing:

- Unless noted differently, all temp construction fencing should be 6' in height.
- Top and center rails are only required on the ballasted fencing; tension wires on all other types.
- Temporary fence shall conform to spec section 015000.2.1A.

RESPONSE: Yes, confirmed.

PART 5 ATTACHMENTS

DOCUMENTS:

None

SKETCHES:

None

DRAWINGS:

EC3.0 Erosion and Sediment Control Plan

END OF ADDENDUM #1

ADDENDUM No. 2 – September 11, 2018

GENERAL

This addendum modifies, amends, and supplements designated parts of the Contract Documents for the above project and is hereby made part thereof by reference and shall be as binding as though inserted in locations designated hereunder.

It shall be the responsibility of the bidders to notify all subcontractors and suppliers he proposes to use for the various parts of the work for any changes or modifications contained in this addendum. No claim for additional compensation because of lack of knowledge of the contents of this addendum will be considered.

SPECIFICATIONS

1. DOCUMENT 00 01 10 – TABLE OF CONTENTS (in each volume)

Page 3, APPENDICES

Insert at end: "Appendix N Fontaine-W.T. Rich Phasing Plans (PH-2A, PH-3, PH-3A)"

2. APPENDIX A, B, C, D, E, F, G, H, I, J, K, L, M, N

Divider Cover, header

Delete: "Design Development Specifications"

Insert: "60% CD & Early Site Bid Package #2"

3. APPENDIX B

Divider Cover

Delete: "BORING LOGS AND LOCATIONS"

Insert: "NOT USED"

4. APPENDIX C

Divider Cover

Delete: "DOUBLE RING INFILTROMETER TESTS"

Insert: "NOT USED"

5. APPENDIX N – FONTAINE-W.T. RICH PHASING PLANS (PH-2A, PH-3, PH-3A)

Insert Entire Document (attached)

DRAWINGS

1. DRAWING C6.2 – Roadway Signage & Striping Plan

A. Refer to sketch ADD2/C-001

2. DRAWING C6.3 – Roadway Signage & Striping Plan

A. Refer to sketch ADD2/C-002

3. DRAWING C8.0 – Site Utility Plan

- A. Refer to sketch ADD2/C-003
- B. Refer to sketch ADD2/C-004

4. DRAWING C8.1 – Site Utility Plan

A. Refer to sketch ADD2/C-005

5. DRAWING C8.2 – Site Utility Plan

A. Refer to sketch ADD2/C-006

6. DRAWING C8.3 – Site Utility Plan

- A. Refer to sketch ADD2/C-007
- B. Refer to sketch ADD2/C-008

7. DRAWING C9.0 – Site Drainage Plan

- A. Refer to sketch ADD2/C-010
- B. Refer to sketch ADD2/C-014

8. DRAWING C9.1 – Site Drainage Plan

- A. Refer to sketch ADD2/C-010
- B. Refer to sketch ADD2/C-012
- C. Refer to sketch ADD2/C-013

9. DRAWING C9.2 – Site Drainage Plan

A. Refer to sketch ADD2/C-011

10. DRAWING C11.2 – Civil Details

- A. Refer to sketch ADD2/C-015
- B. Refer to sketch ADD2/C-016
- C. Refer to sketch ADD2/C-017
- D. Refer to sketch ADD2/C-018
- E. Refer to sketch ADD2/C-019

11. DRAWING L2.4 – Materials & Lighting

A. Refer to sketch ADD2/L-002

12. DRAWING L4.0 – Planting

- A. Refer to sketch ADD2/L-001

13. DRAWING L4.1 – Planting

- A. Refer to sketch ADD2/L-001

14. DRAWING L4.2 – Planting

- A. Refer to sketch ADD2/L-001

ATTACHMENTS

DOCUMENTS:

1. Appendix N- Fontaine-W.T. Rich Phasing Plan PH-2A
2. Appendix N- Fontaine-W.T. Rich Phasing Plan PH-3
3. Appendix N- Fontaine-W.T. Rich Phasing Plan PH-3A

SKETCHES:

CIVIL

1. ADD-2/C-001 Roadway Signage and Striping Plan Sketch
2. ADD-2/C-002 Roadway Signage and Striping Plan Sketch
3. ADD-2/C-003 Site Utility Plan Sketch
4. ADD-2/C-004 Site Utility Plan Sketch
5. ADD-2/C-005 Site Utility Plan Sketch
6. ADD-2/C-006 Site Utility Plan Sketch
7. ADD-2/C-007 Site Utility Plan Sketch
8. ADD-2/C-008 Site Utility Plan Sketch
9. ADD-2/C-009 Site Drainage Plan Sketch
10. ADD-2/C-010 Site Drainage Plan Sketch
11. ADD-2/C-011 Site Drainage Plan Sketch
12. ADD-2/C-012 Site Drainage Plan Sketch
13. ADD-2/C-013 Site Drainage Plan Sketch
14. ADD-2/C-014 Site Drainage Plan Sketch
15. ADD-2/C-015 Civil Detail Sketch
16. ADD-2/C-016 Civil Detail Sketch
17. ADD-2/C-017 Civil Detail Sketch
18. ADD-2/C-018 Civil Detail Sketch
19. ADD-2/C-019 Civil Detail Sketch

LANDSCAPE


1. ADD-2/L-001 Courtyard Trees
2. ADD-2/L-002 Tennis Equipment Callouts

END OF ADDENDUM #2

APPENDIX N

FONTAINE – WT RICH PHASING PLANS

(PH-2A, PH-3, PH-3A)

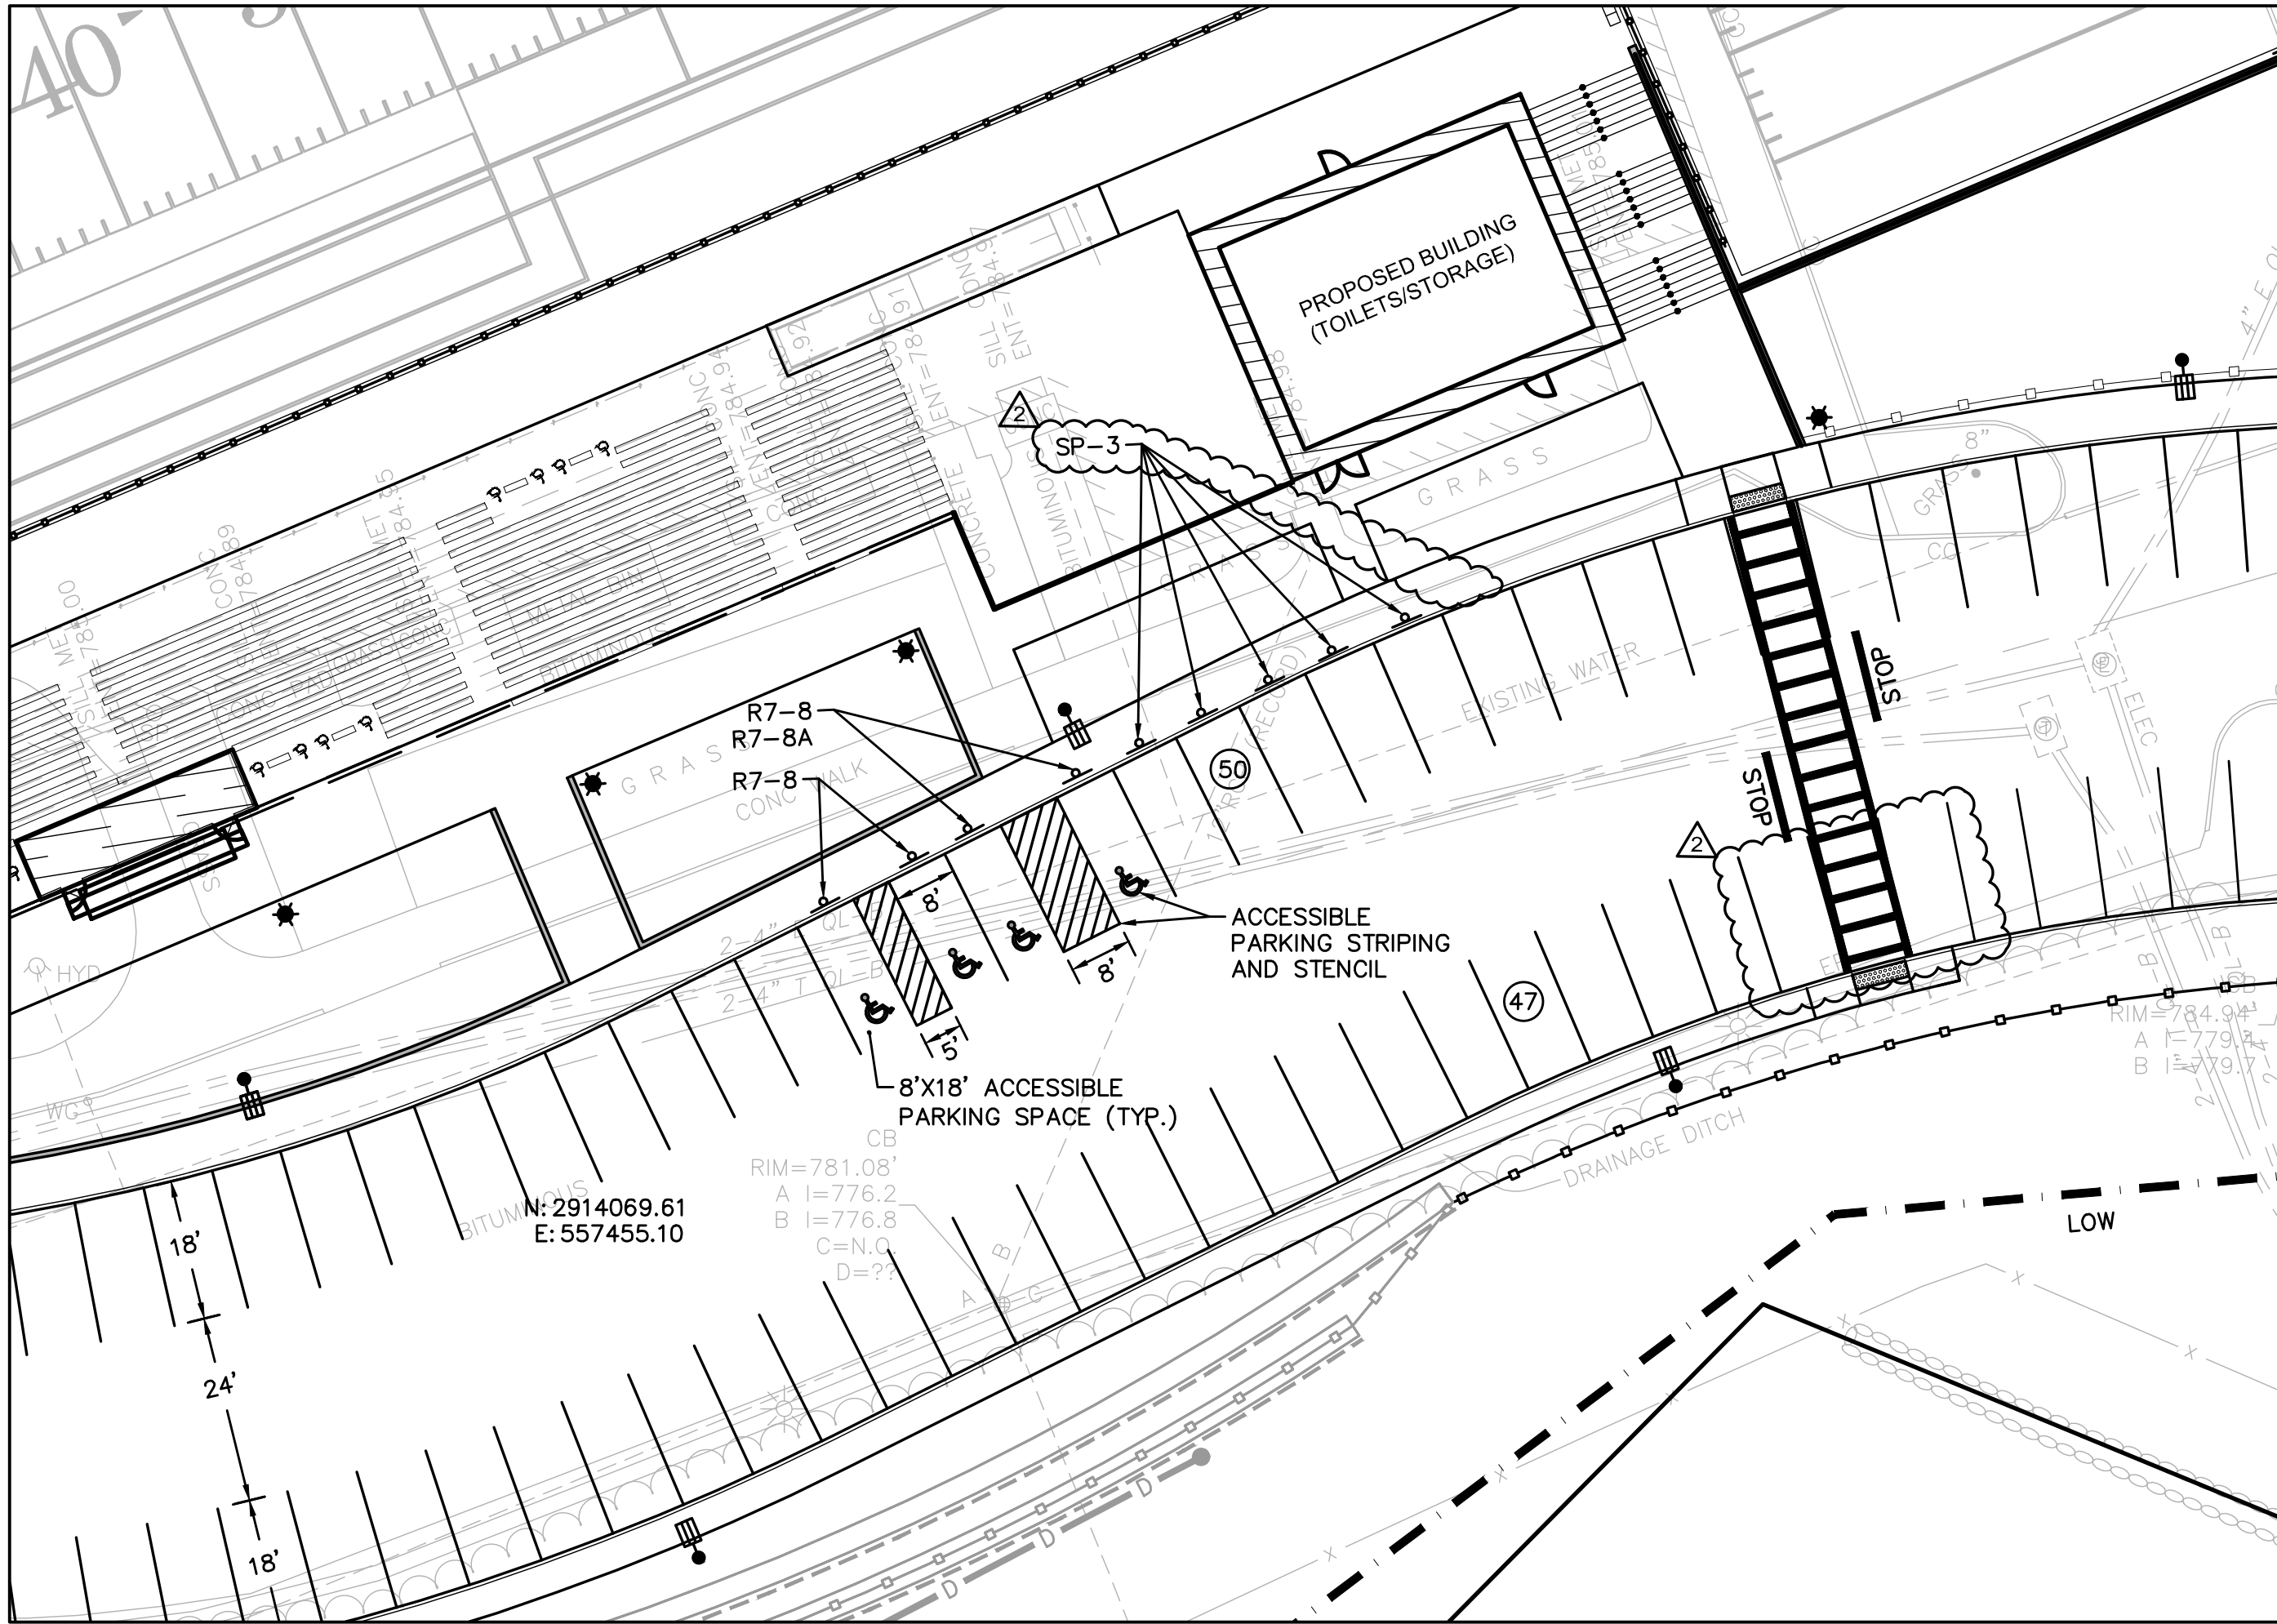

DRAWING NAME: Roadway Signage and Striping Plan Sketch	SHEET REF. NO. C6.2
	DRAWING NUMBER: ADD-2 C-001
DATE: 09/11/18	SCALE: 1"=20'

PROJECT TITLE:
EARLY SITE BID PACKAGE #2
South High Community School
170 Apricot Street, Worcester, MA 01603


CLIENT INFORMATION:
Worcester Public Schools



City of Worcester
Massachusetts, 01605

MEMBER OF
THE AMERICAN INSTITUTE OF ARCHITECTS

LANOURELLA PACIANO
ASSOCIATES, ARCHITECTS
108 GARDEN STREET, SUITE 400
WORCESTER, MASSACHUSETTS 01605

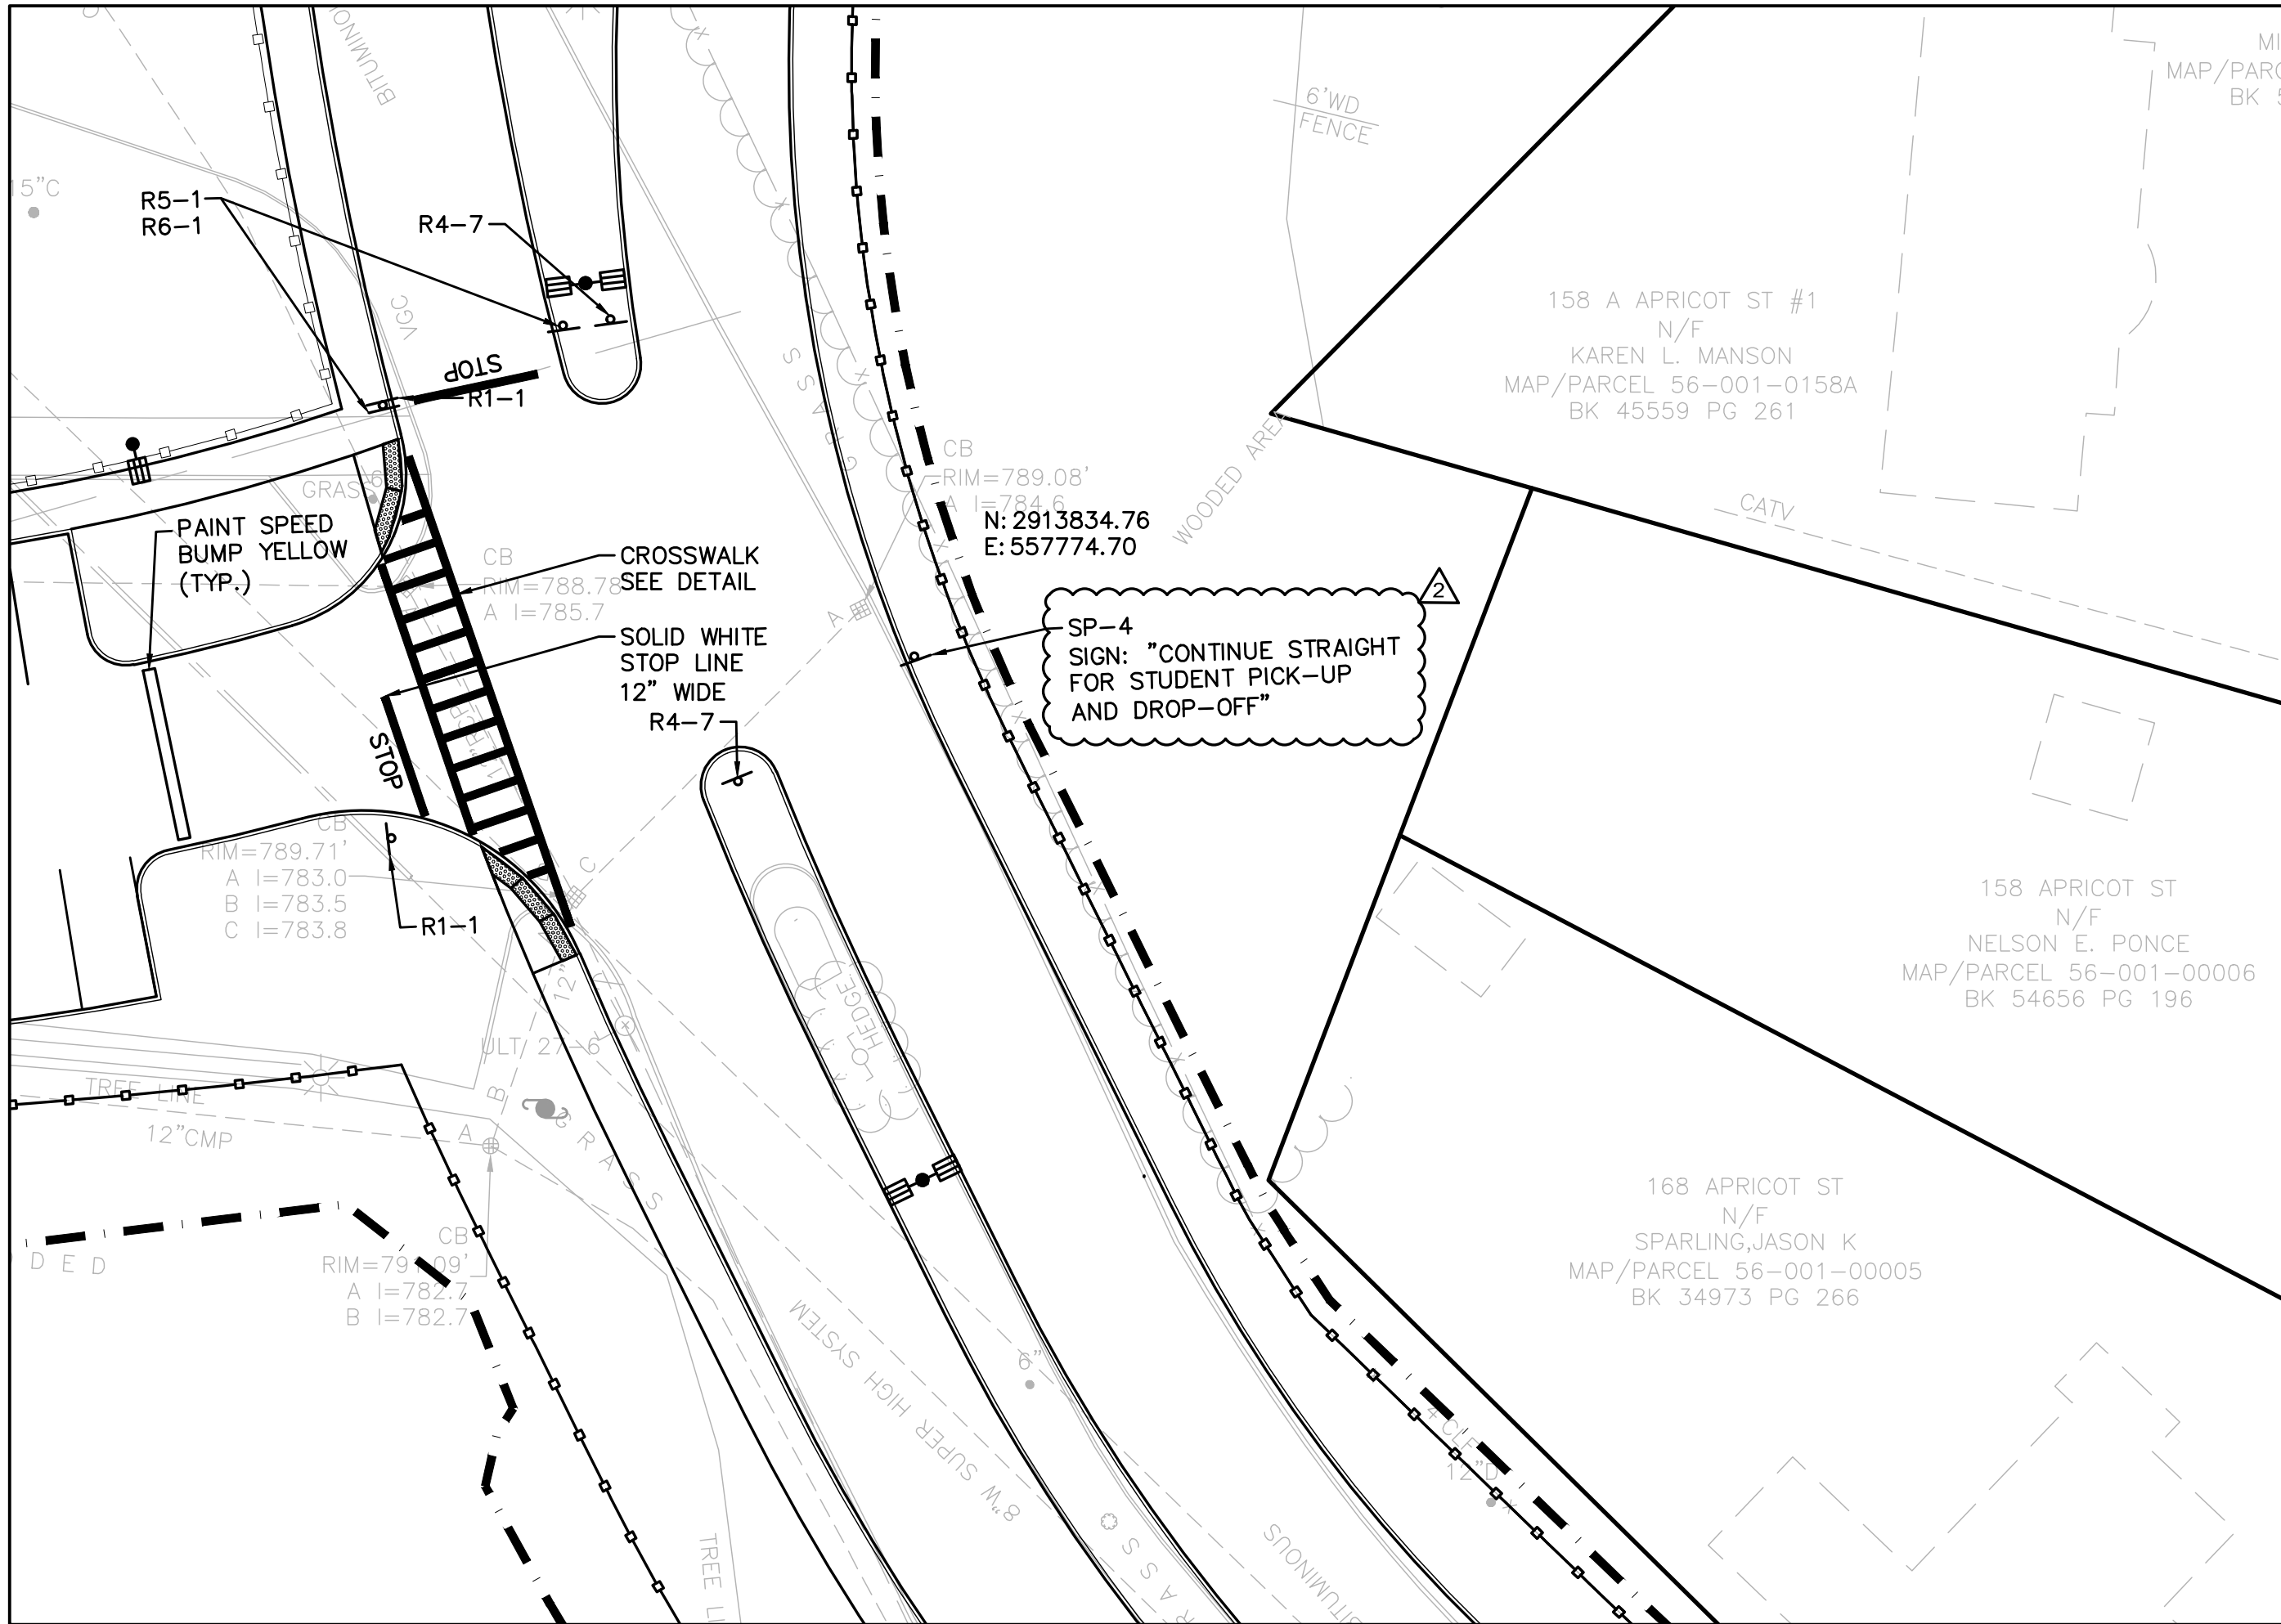

DRAWING NAME: Roadway Signage and Striping Plan Sketch	SHEET REF. NO. C6.3
	DRAWING NUMBER: ADD-2 C-002
DATE: 09/11/18	SCALE: 1"=20'

PROJECT TITLE:
EARLY SITE BID PACKAGE #2

South High Community School
170 Apricot Street, Worcester, MA 01603

CLIENT INFORMATION:
Worcester Public Schools



City of Worcester
Massachusetts, 01603



LANSLOWNE PACINO
ASSOCIATES ARCHITECTS
105 BRIDGE STREET, SUITE 200
WORCESTER, MASSACHUSETTS 01603

MEMBER OF
THE AMERICAN INSTITUTE OF ARCHITECTS

158 A APRICOT ST #1
N/F
KAREN L. MANSON
MAP/PARCEL 56-001-0158A
BK 45559 PG 261

158 APRICOT ST
N/F
NELSON E. PONCE
MAP/PARCEL 56-001-00006
BK 54656 PG 196

168 APRICOT ST
N/F
SPARLING, JASON K
MAP/PARCEL 56-001-00005
BK 34973 PG 266

SP-4
SIGN: "CONTINUE STRAIGHT
FOR STUDENT PICK-UP
AND DROP-OFF"

PAINT SPEED BUMP YELLOW
(TYP.)

SOLID WHITE STOP LINE
12" WIDE

CROSSWALK
SEE DETAIL

RIM=789.71'
A I=783.0
B I=783.5
C I=783.8

RIM=791.09'
A I=782.7
B I=782.7

CB
RIM=789.08'
A I=784.6
N: 2913834.76
E: 557774.70

MIC
MAP/PARCEL
BK 5

5"C

6"WD
FENCE

CATV

WOODED AREA

8" W SUPER HIGH SYSTEM

TREE LINE

GRASS

VGC

BTUMINOUS

TREE LINE

12" CMP


D E D

ULT/27-16

RACCS

SASS

BTUMINOUS

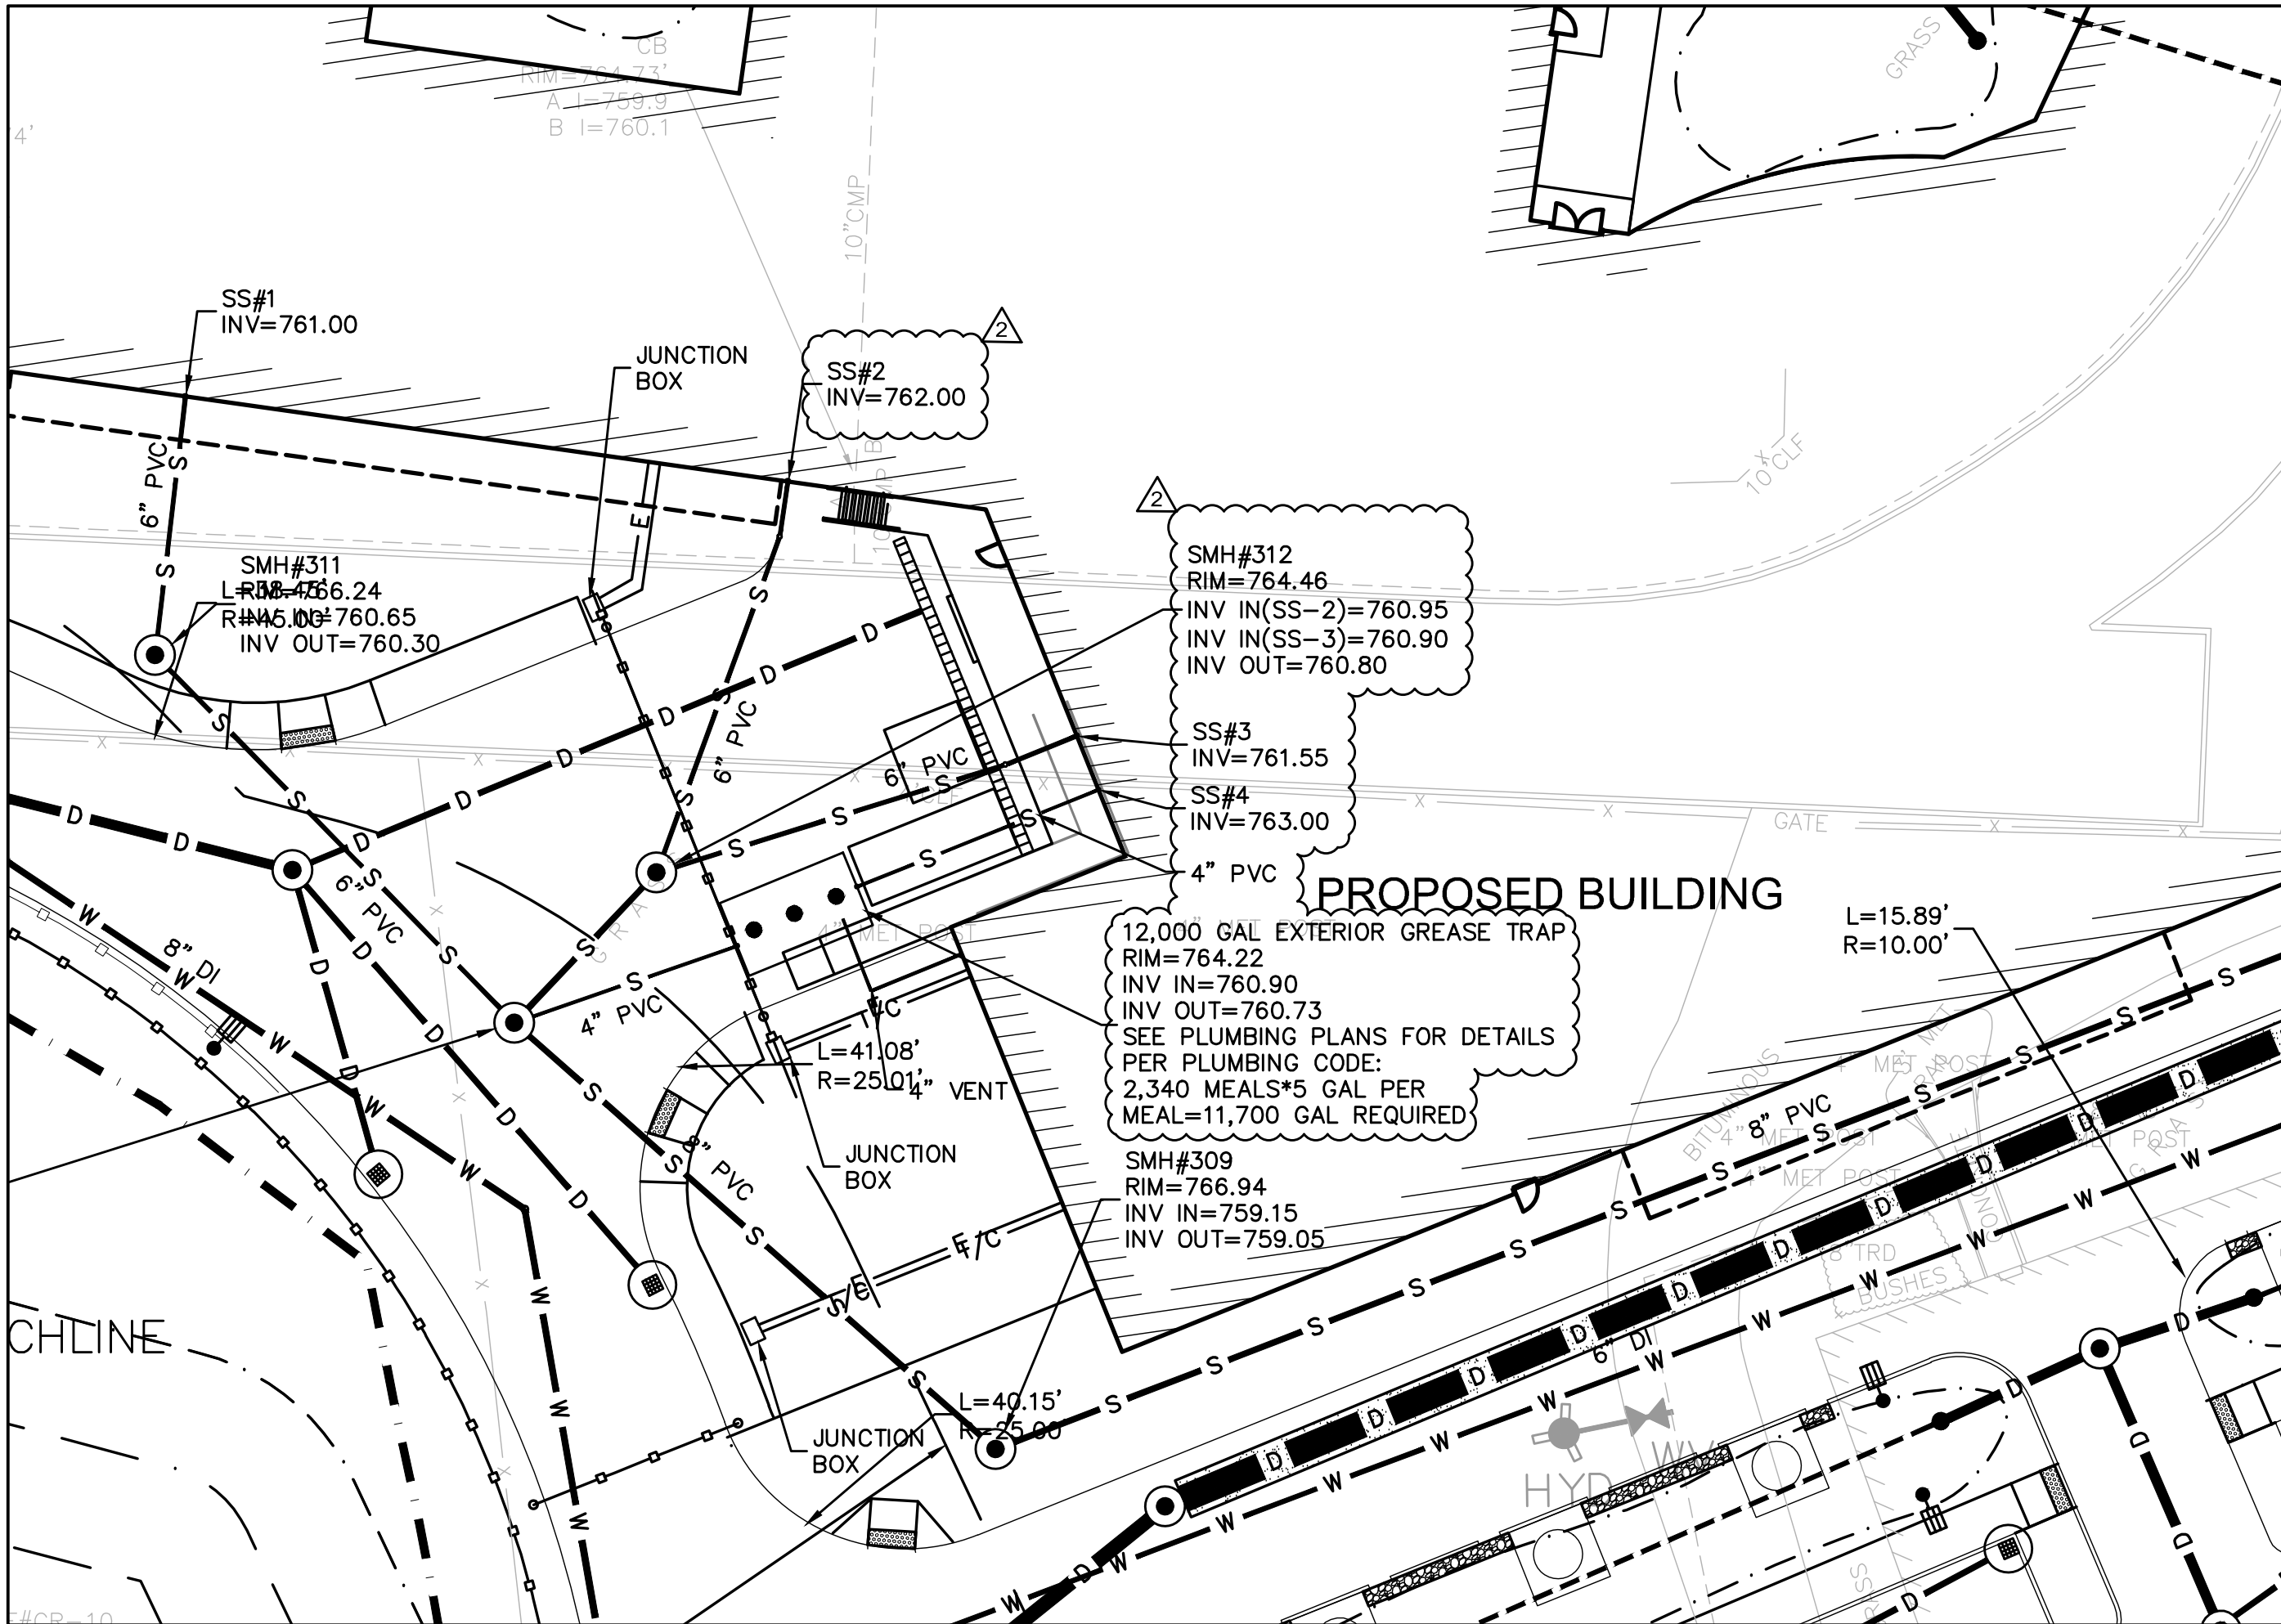


SHEET REF. NO.	C8.0
DRAWING NUMBER:	ADD-2 C-003
DRAWING NAME:	Site Utility Plan Sketch
DATE:	09/11/18
SCALE:	1" = 20'

PROJECT TITLE:
EARLY SITE BID PACKAGE #2
South High Community School

CLIENT INFORMATION:
 Worcester Public Schools



ARCHITECT:
 TOWNSEND PACANO ASSOCIATES ARCHITECTS
 WORCESTER, MASSACHUSETTS 01605



SMH#312
 RIM=764.46
 INV IN(SS-2)=760.95
 INV IN(SS-3)=760.90
 INV OUT=760.80

SS#3
 INV=761.55
 SS#4
 INV=763.00

12,000 GAL EXTERIOR GREASE TRAP
 RIM=764.22
 INV IN=760.90
 INV OUT=760.73
 SEE PLUMBING PLANS FOR DETAILS
 PER PLUMBING CODE:
 2,340 MEALS*5 GAL PER
 MEAL=11,700 GAL REQUIRED

SMH#309
 RIM=766.94
 INV IN=759.15
 INV OUT=759.05

SS#1
 INV=761.00

SS#2
 INV=762.00

SMH#311
 L=45.00'
 R=45.00'
 INV OUT=760.30

L=41.08'
 R=25.01"
 4" VENT

L=40.15'
 R=25.00"

L=15.89'
 R=10.00'

PROPOSED BUILDING

CHLINE

#CB-10

CB
 RIM=764.73'
 A I=759.9
 B I=760.1

10" CMP

10" CLF


GATE

BITUMINOUS
 4" 8" PVC

5 TRD
 BUSHES

HYD

GRASS

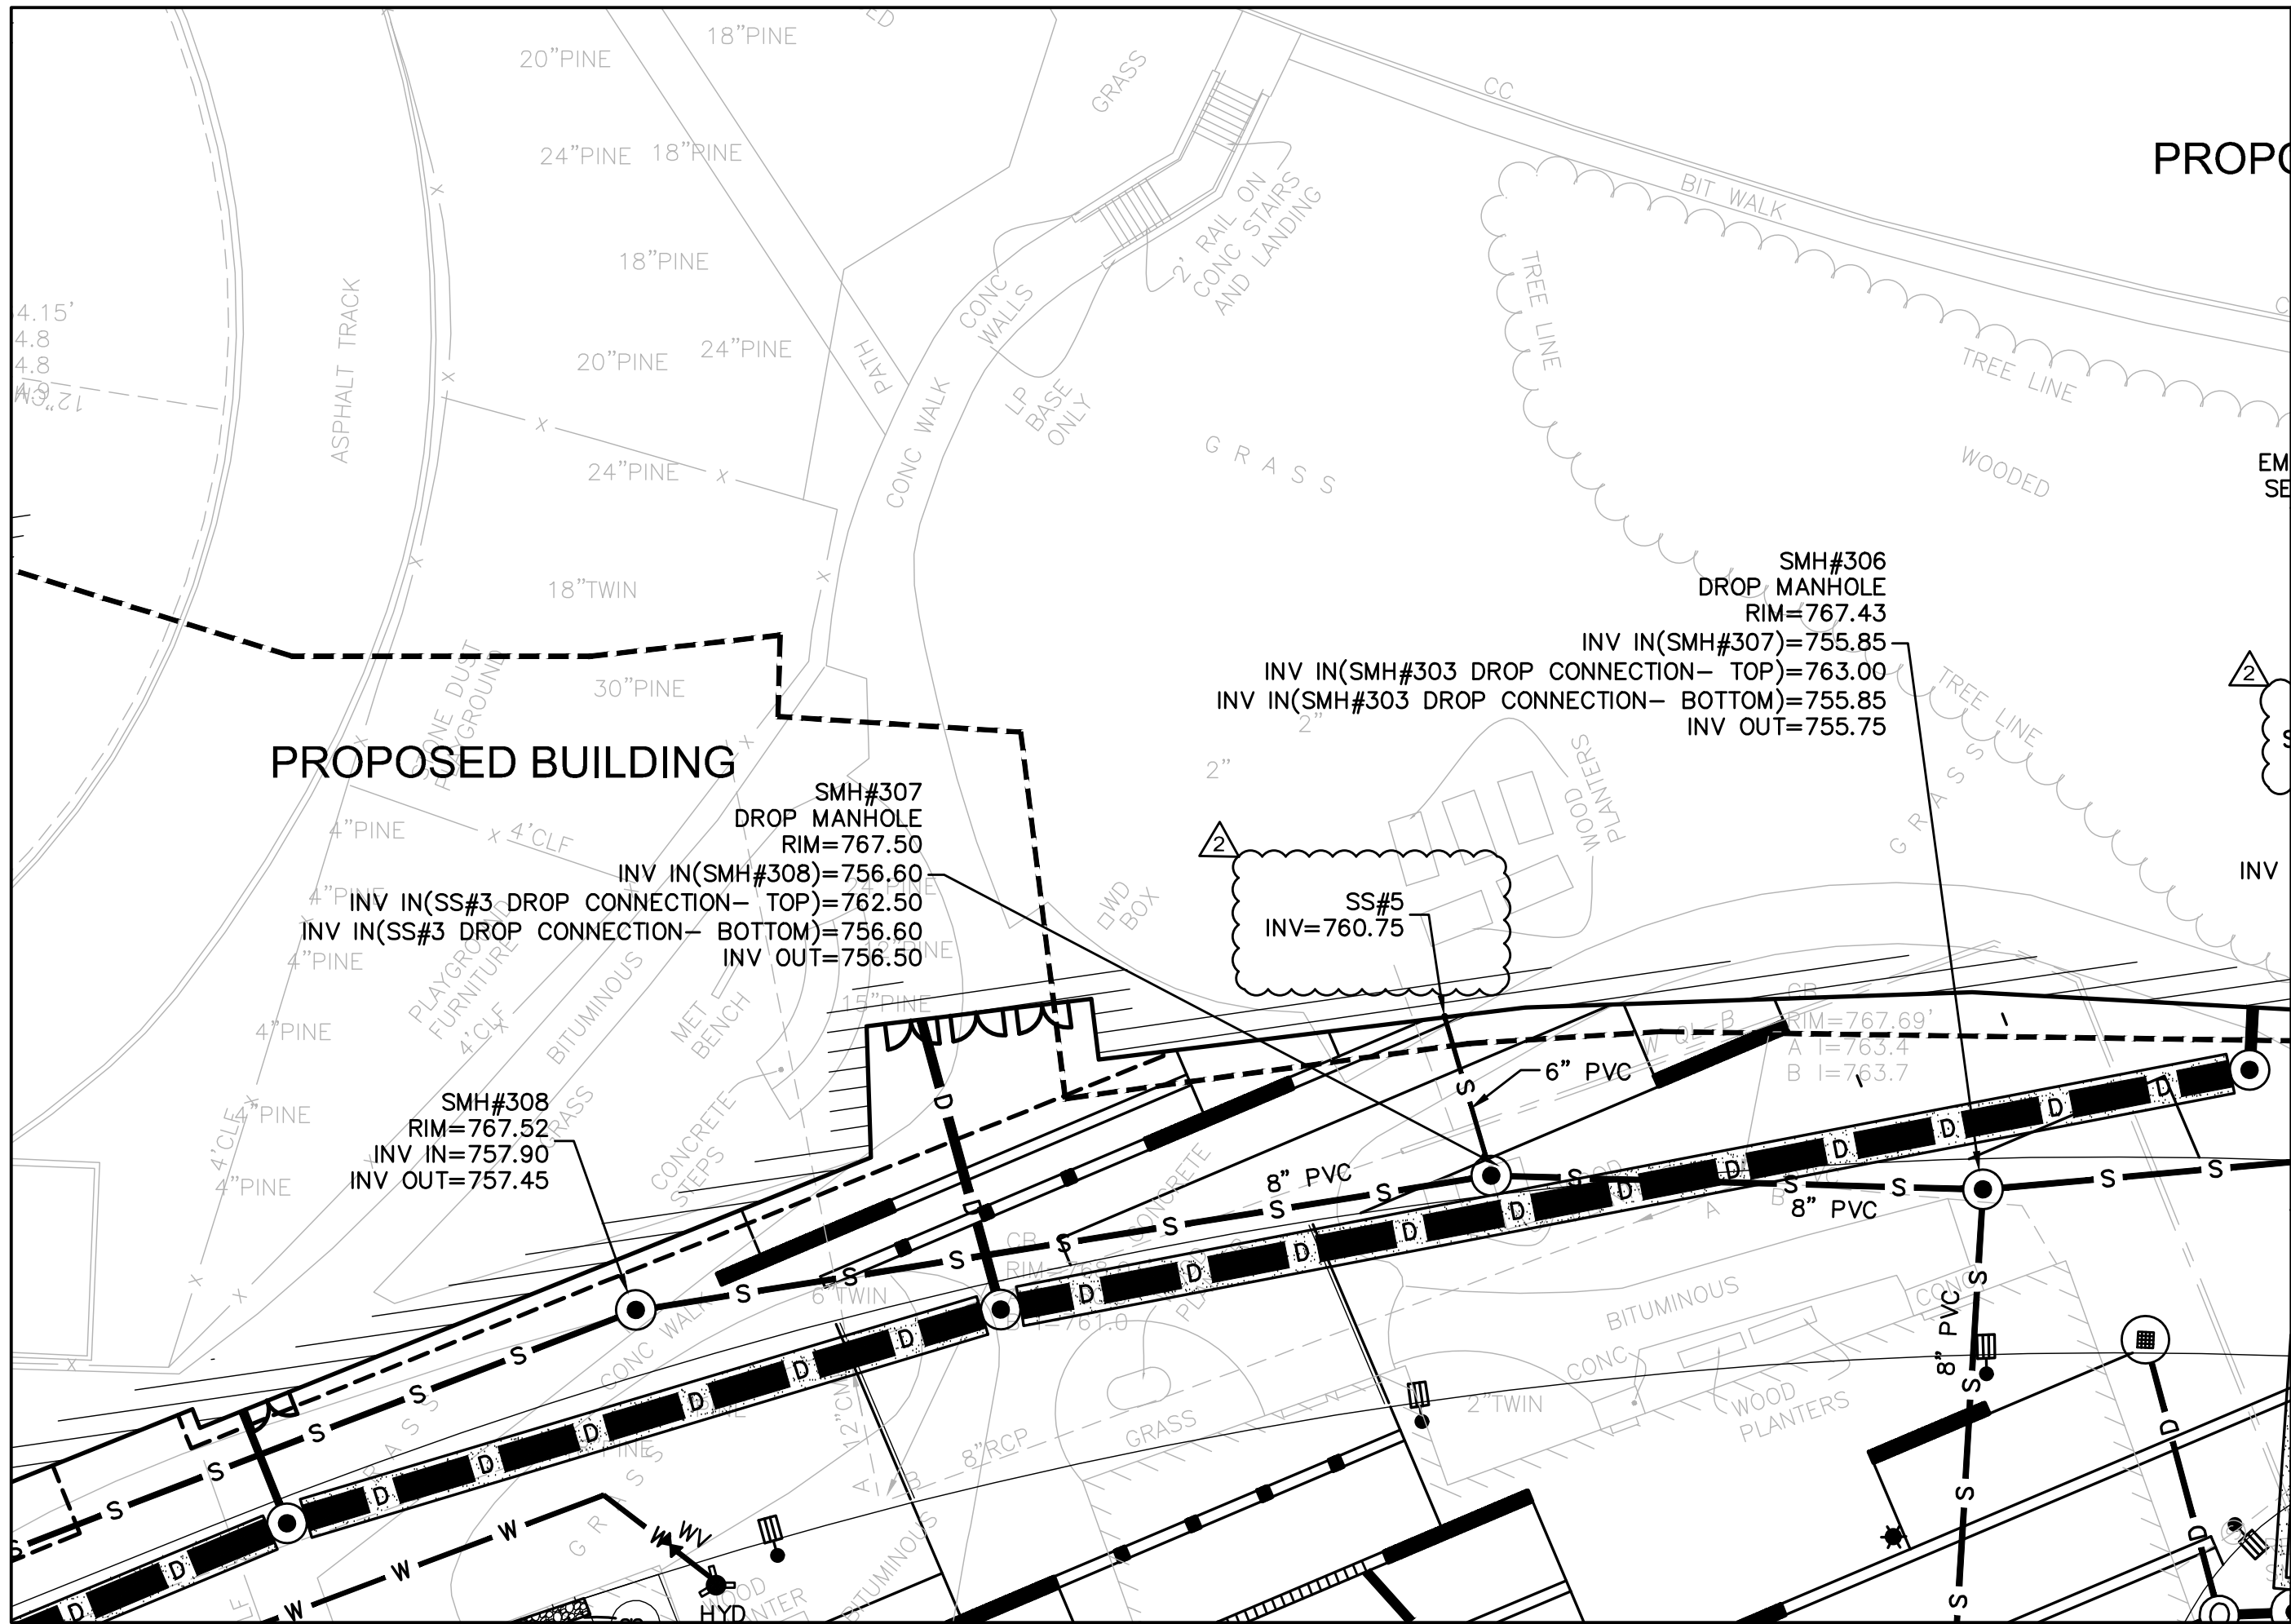

PROPOSED BUILDING

SMH#307
 DROP MANHOLE
 RIM=767.50
 INV IN(SMH#308)=756.60
 INV IN(SS#3 DROP CONNECTION- TOP)=762.50
 INV IN(SS#3 DROP CONNECTION- BOTTOM)=756.60
 INV OUT=756.50

SMH#308
 RIM=767.52
 INV IN=757.90
 INV OUT=757.45


SMH#306
 DROP MANHOLE
 RIM=767.43
 INV IN(SMH#307)=755.85
 INV IN(SMH#303 DROP CONNECTION- TOP)=763.00
 INV IN(SMH#303 DROP CONNECTION- BOTTOM)=755.85
 INV OUT=755.75

SS#5
 INV=760.75


SHEET REF. NO.	C8.0
DRAWING NUMBER:	ADD-2 C-001
DRAWING NAME:	Site Utility Plan Sketch
DATE:	09/11/18
SCALE:	1"=20'

PROJECT TITLE:
 EARLY SITE BID PACKAGE #2
 South High Community School

CLIENT INFORMATION:
 Worcester Public Schools

THOMAS PACANO
 ASSOCIATES ARCHITECTS
 WORCESTER, MASSACHUSETTS 01605

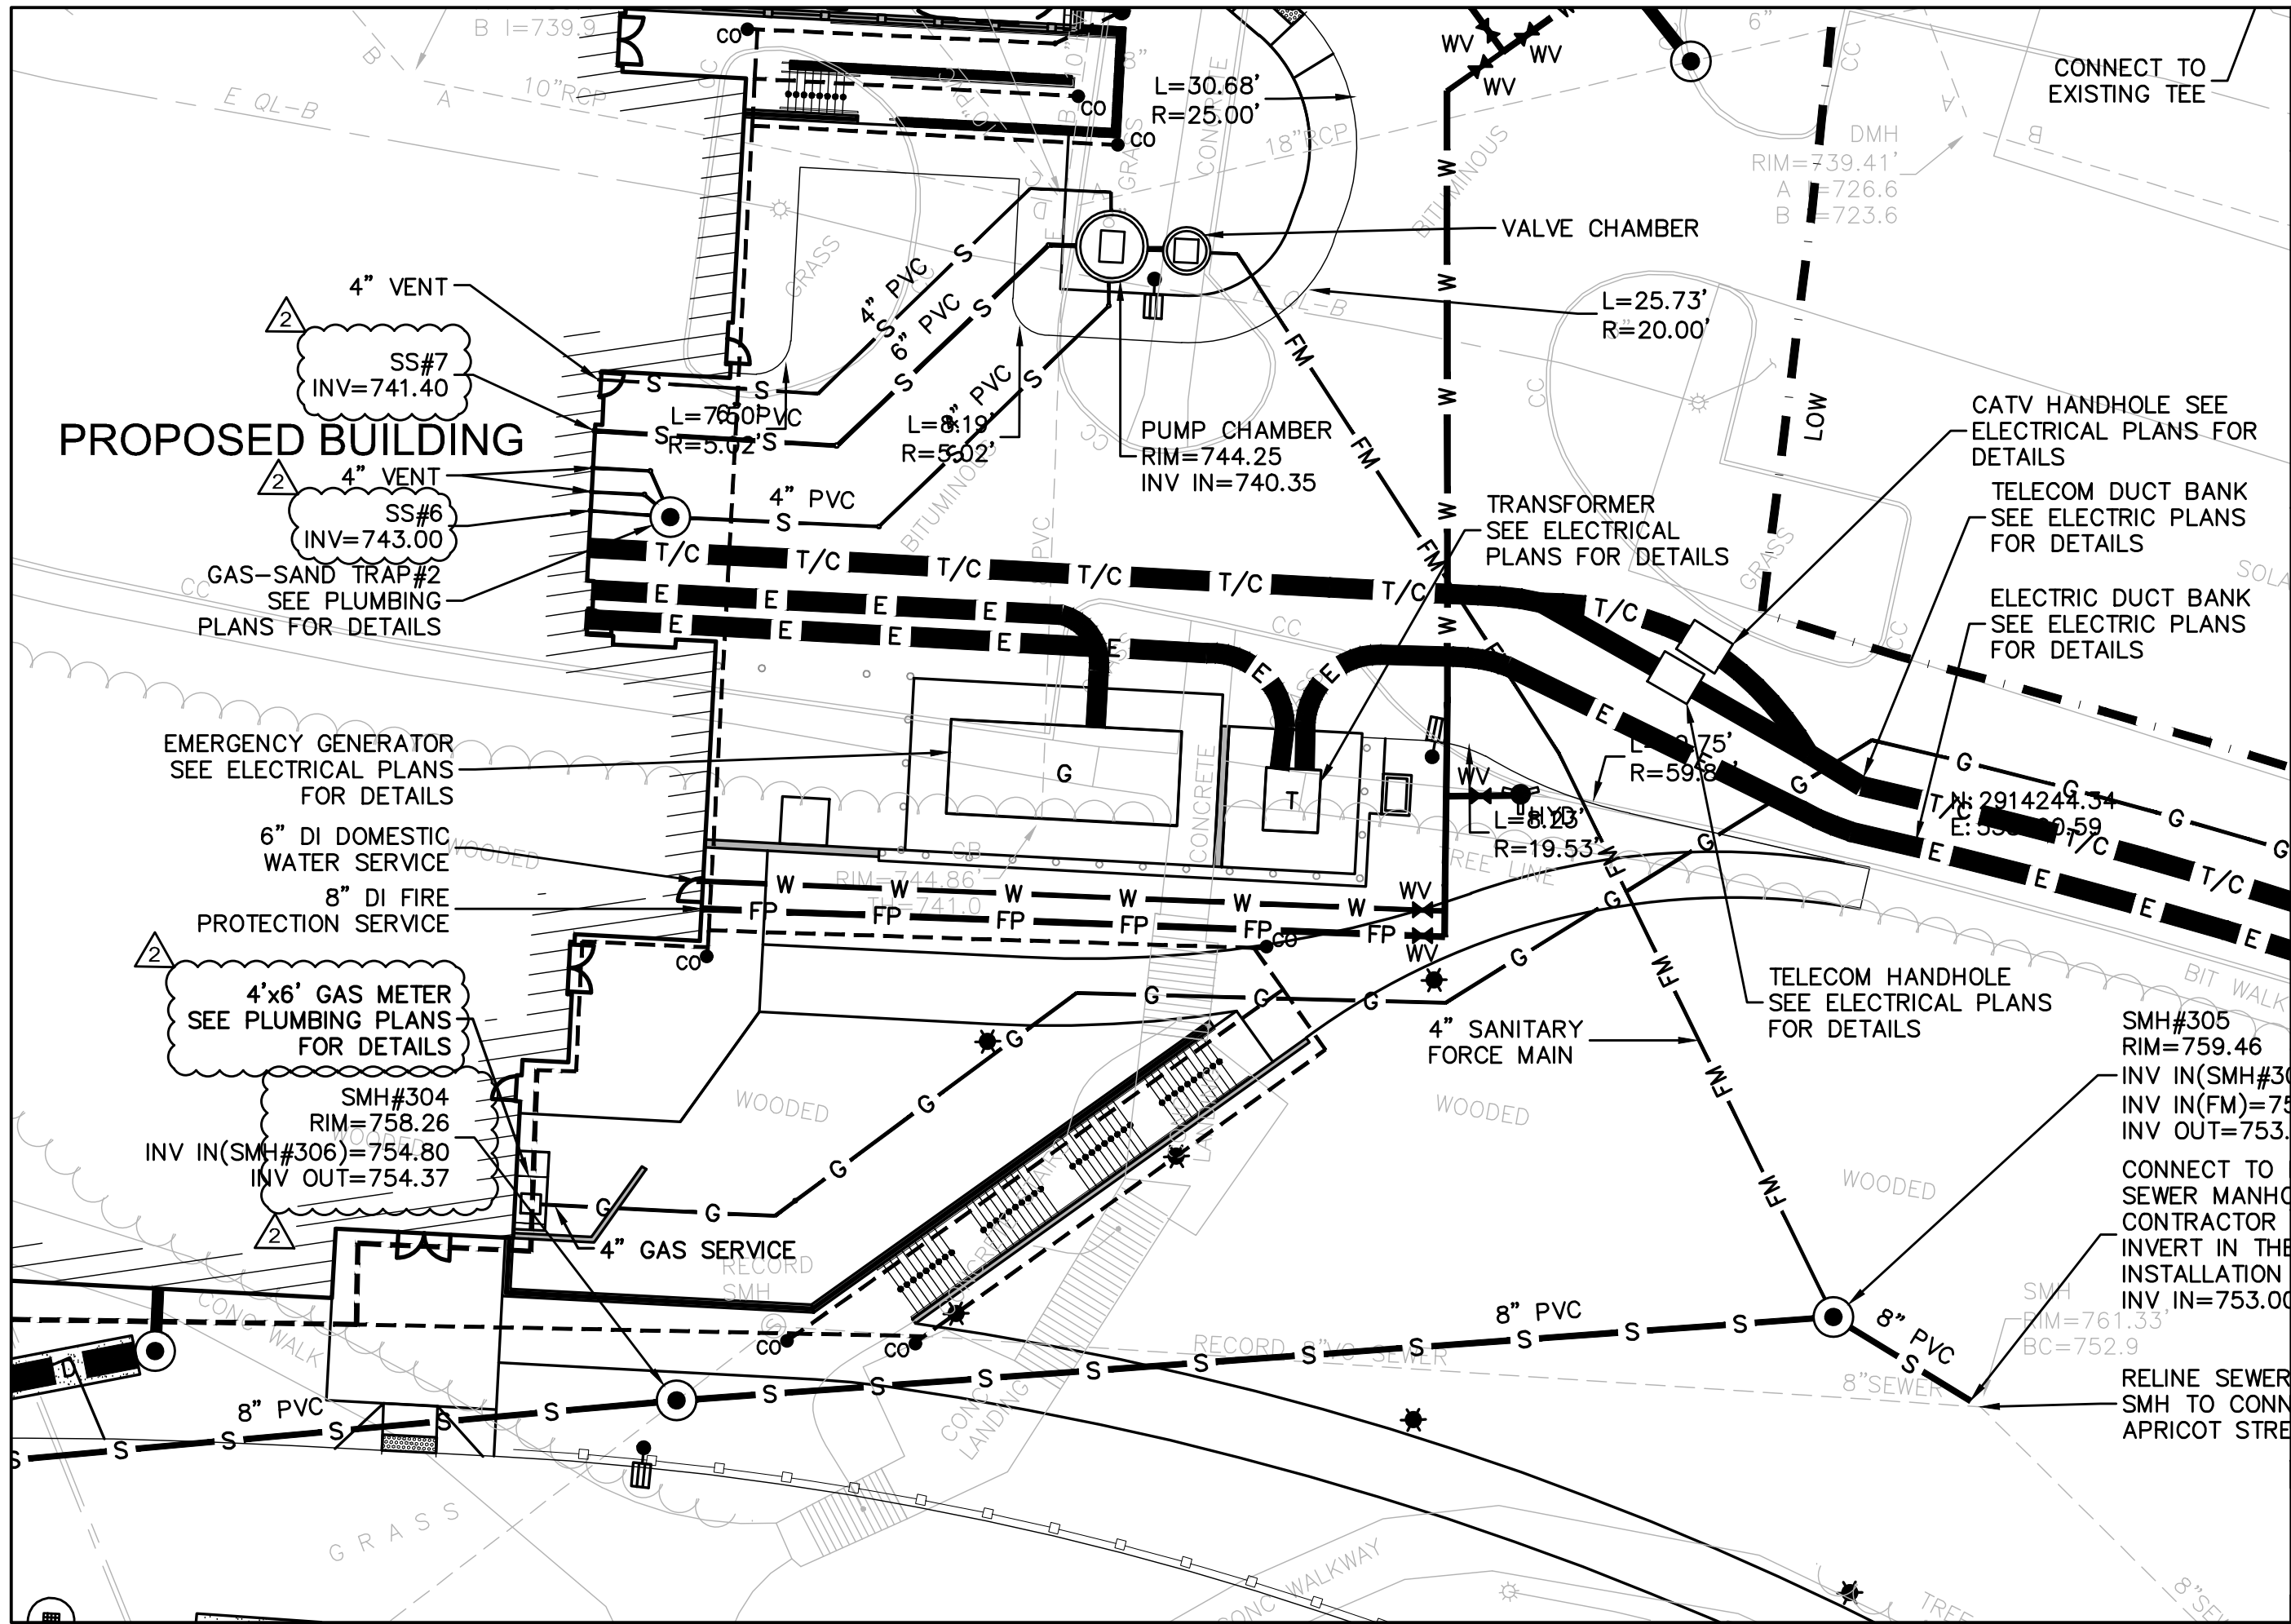

PROPOSED BUILDING

SS#7
INV=741.40

SS#6
INV=743.00

GAS-SAND TRAP #2
SEE PLUMBING
PLANS FOR DETAILS

EMERGENCY GENERATOR
SEE ELECTRICAL PLANS
FOR DETAILS

6" DI DOMESTIC
WATER SERVICE

8" DI FIRE
PROTECTION SERVICE

4'x6' GAS METER
SEE PLUMBING PLANS
FOR DETAILS

SMH#304
RIM=758.26
INV IN(SMH#306)=754.80
INV OUT=754.37

PUMP CHAMBER
RIM=744.25
INV IN=740.35

TRANSFORMER
SEE ELECTRICAL
PLANS FOR DETAILS

CATV HANDHOLE SEE
ELECTRICAL PLANS FOR
DETAILS

TELECOM DUCT BANK
SEE ELECTRIC PLANS
FOR DETAILS

ELECTRIC DUCT BANK
SEE ELECTRIC PLANS
FOR DETAILS

TELECOM HANDHOLE
SEE ELECTRICAL PLANS
FOR DETAILS

SMH#305
RIM=759.46
INV IN(SMH#306)=754.80
INV OUT=753.37

CONNECT TO
SEWER MANHOLE
CONTRACTOR
INVERT IN THE
INSTALLATION
INV IN=753.00

RELINE SEWER
SMH TO CONN
APRICOT STRE

SHEET REF. NO.	C8.1
DRAWING NUMBER:	ADD-2
DATE:	09/11/18
SCALE:	1"=20'

DRAWING NAME:
Site Utility Plan Sketch

PROJECT TITLE:
EARLY SITE BID PACKAGE #2


CLIENT INFORMATION:
Worcester Public Schools



THOMAS PACANO
ASSOCIATES ARCHITECTS
WORCESTER, MASSACHUSETTS 01605

ADD-2

South High Community School

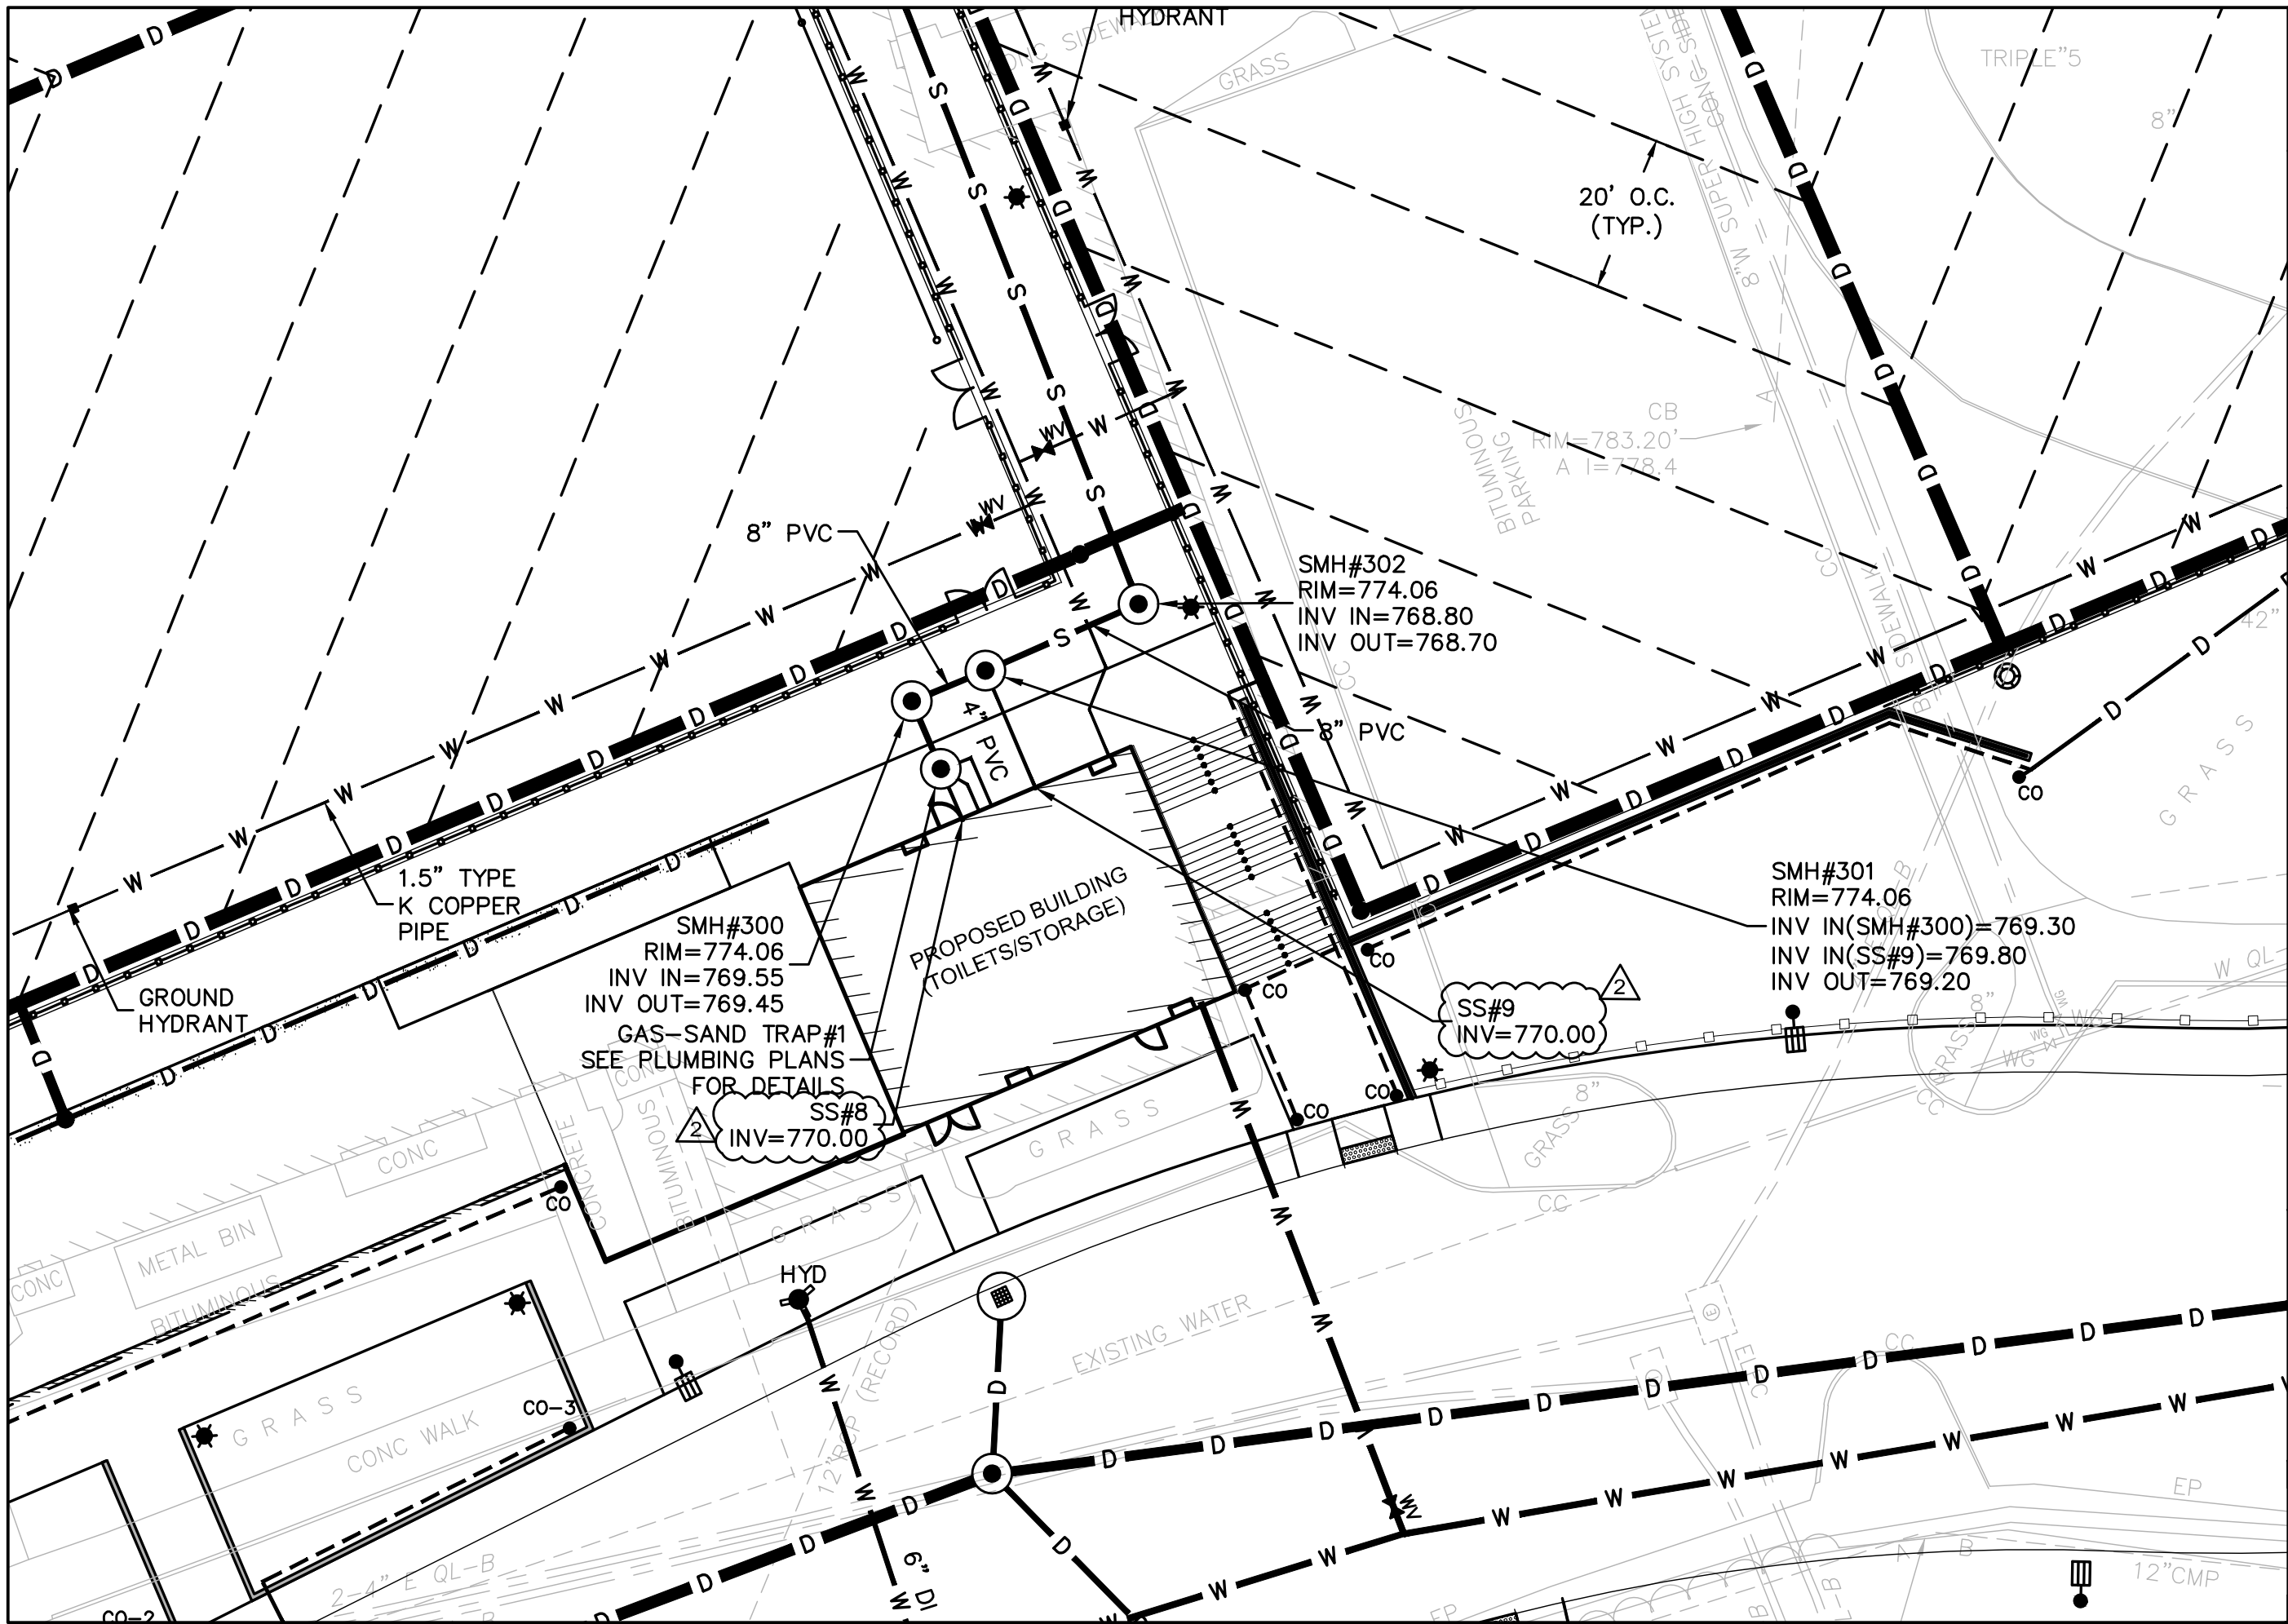


DRAWING NAME: Site Utility Plan Sketch		SHEET REF. NO. C8.2
DATE: 09/11/18		DRAWING NUMBER: ADD-2
SCALE: 1" = 20'		C.M.C.

PROJECT TITLE:
EARLY SITE BID PACKAGE #2

South High Community School

CLIENT INFORMATION:
Worcester Public Schools

THOMAS PACANO
ASSOCIATES ARCHITECTS
WORCESTER, MASSACHUSETTS 01605

SMH#300
RIM=774.06
INV IN=769.55
INV OUT=769.45
GAS-SAND TRAP#1
SEE PLUMBING PLANS
FOR DETAILS

SMH#302
RIM=774.06
INV IN=768.80
INV OUT=768.70

SMH#301
RIM=774.06
INV IN(SMH#300)=769.30
INV IN(SS#9)=769.80
INV OUT=769.20

SS#9
INV=770.00

SS#8
INV=770.00

PROPOSED BUILDING
(TOILETS/STORAGE)

20' O.C.
(TYP.)

CB
RIM=783.20'
A I=778.4

TRIPLE"5
8"

GRASS

EXISTING WATER

12" CMP

1.5" TYPE
K COPPER
PIPE

8" PVC

4" PVC

8" PVC

GROUND
HYDRANT

METAL BIN

CONC WALK

GRASS

GRASS 8"

EP

GRASS

CONC

GRASS

GRASS

GRASS 8"

GRASS

GRASS


CONC

GRASS

GRASS

GRASS 8"

GRASS

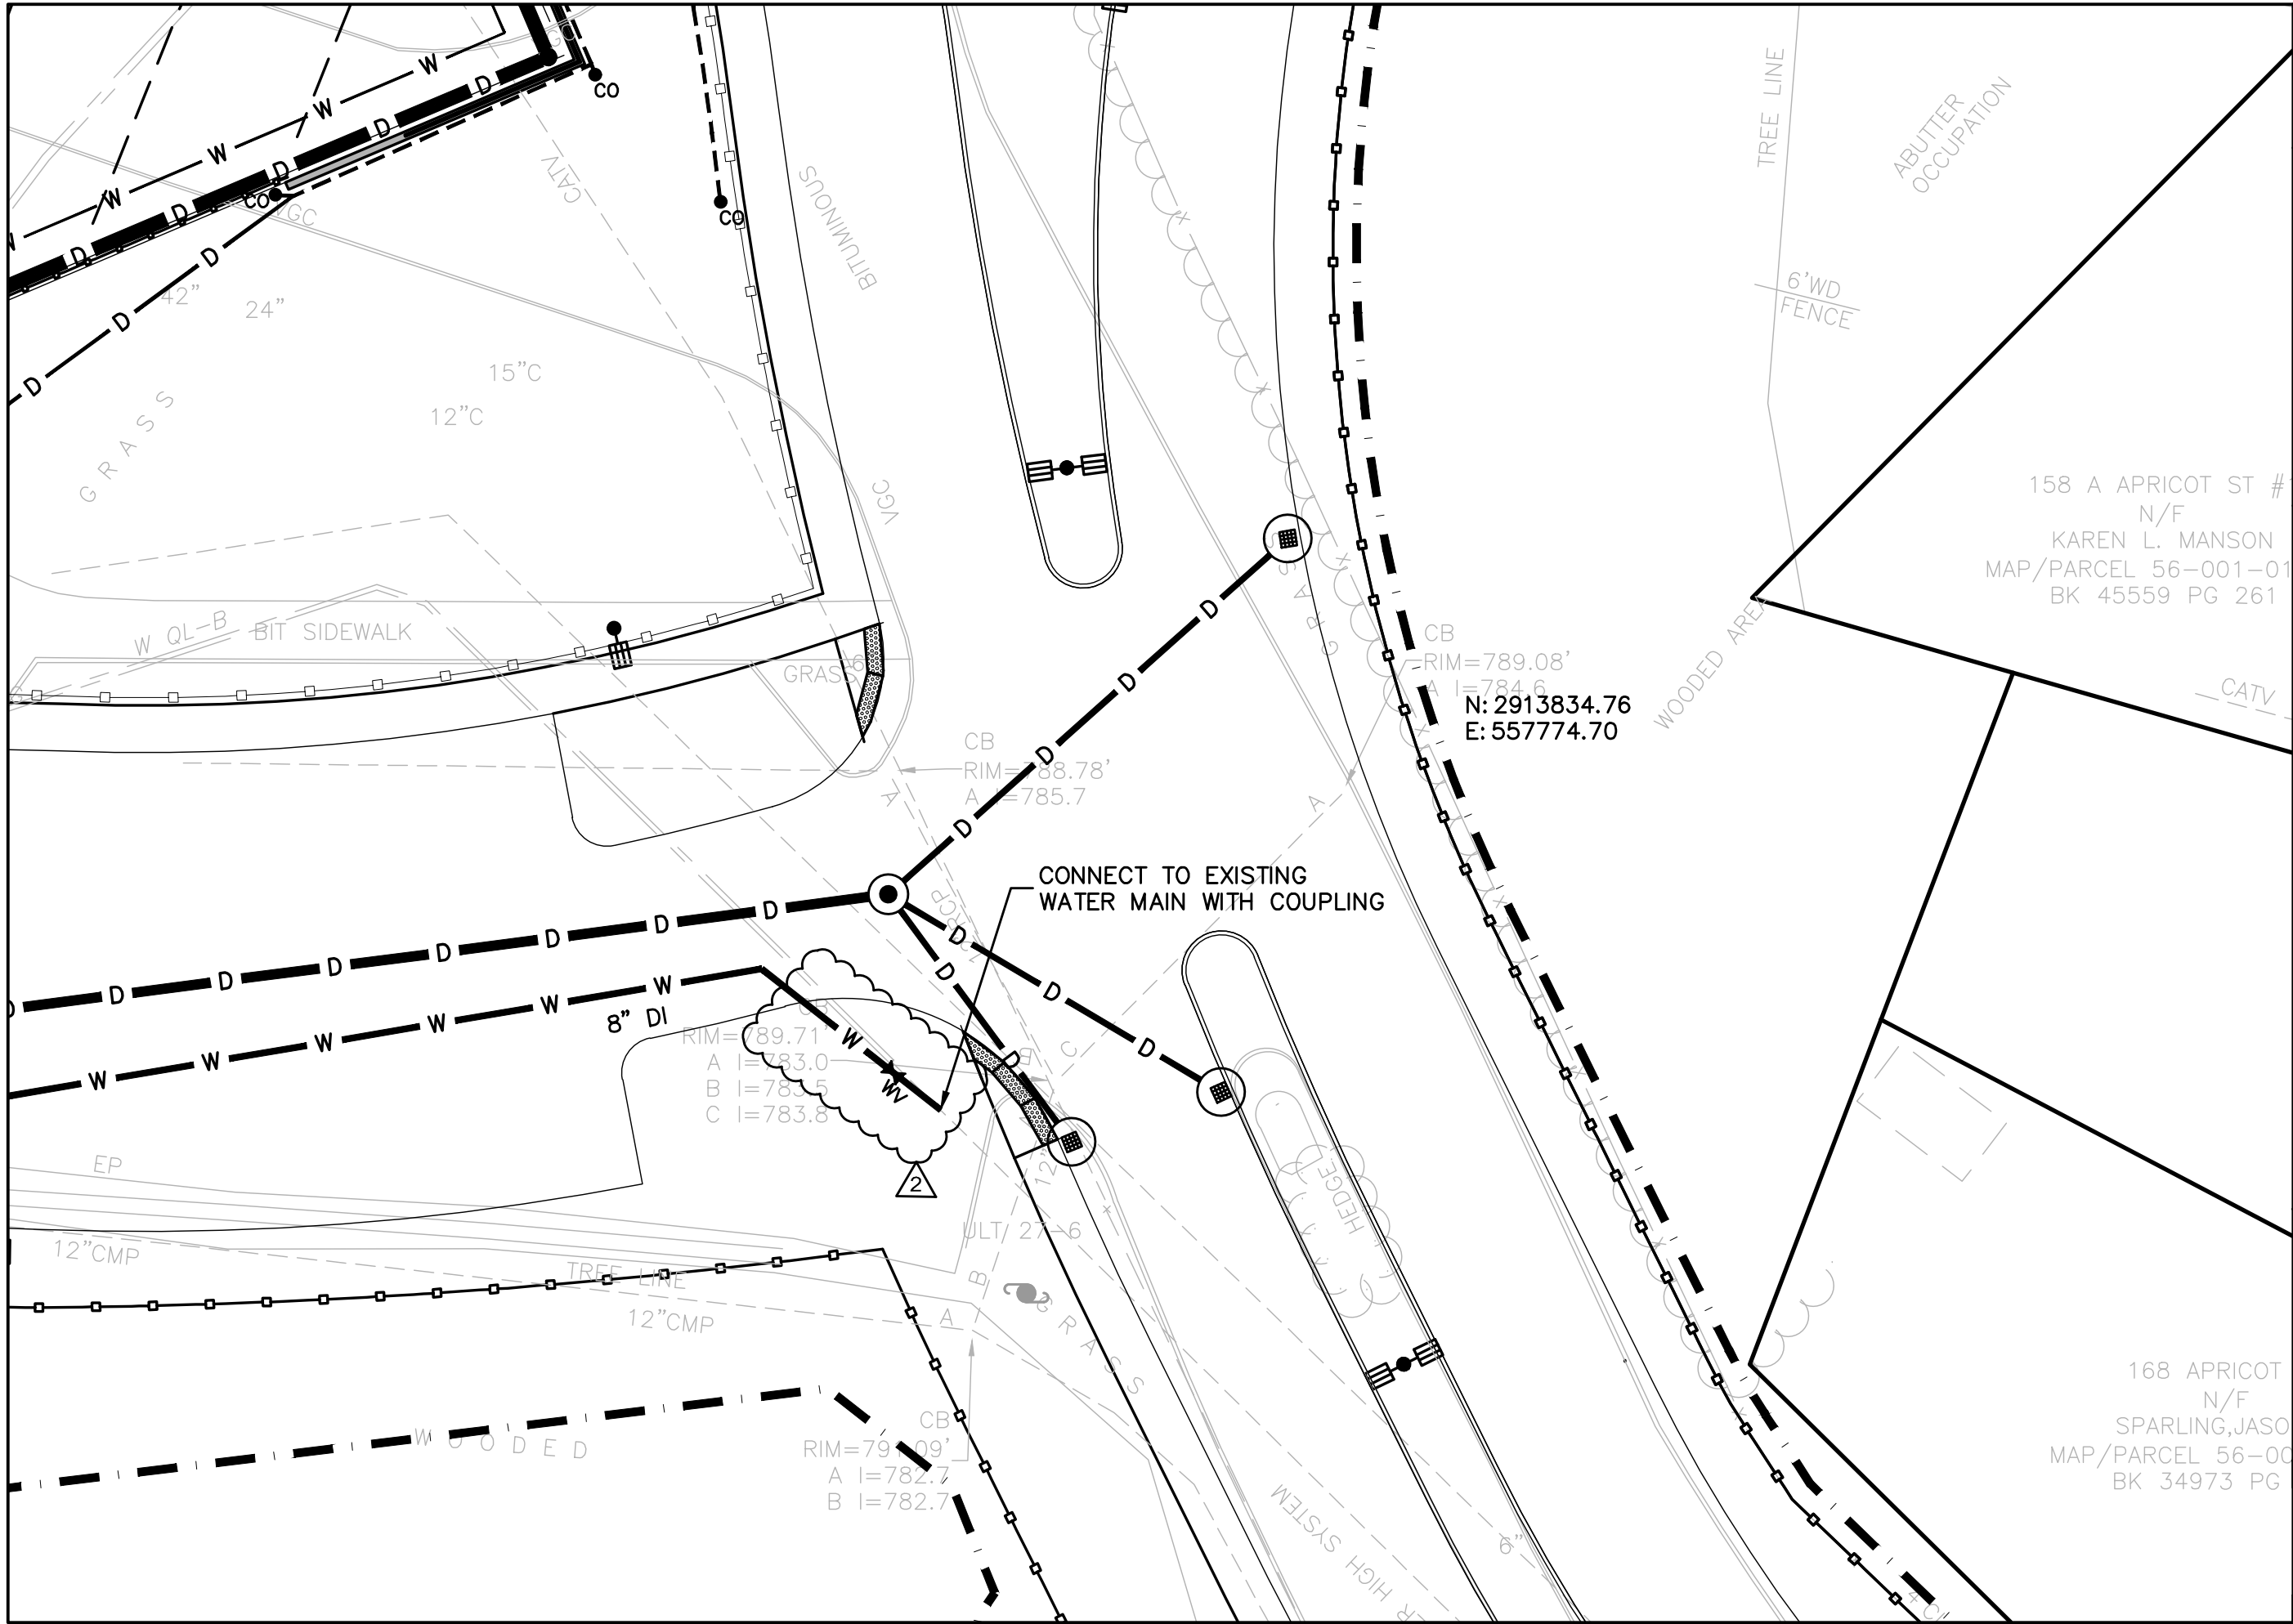

158 A APRICOT ST #
N/F
KAREN L. MANSON
MAP/PARCEL 56-001-01
BK 45559 PG 261


168 APRICOT
N/F
SPARLING, JASO
MAP/PARCEL 56-001-02
BK 34973 PG 261

DRAWING NAME: Site Utility Plan Sketch		SHEET REF. NO. C8.3
DATE: 09/11/18	DRAWING NUMBER: ADD-2 C_007	
SCALE: 1"=20'		

PROJECT TITLE:
EARLY SITE BID PACKAGE #2


South High Community School

CLIENT INFORMATION:
Worcester Public Schools

TAMBORELLI PACANO
ASSOCIATES ARCHITECTS
100 STATE STREET SUITE 200
WORCESTER, MASSACHUSETTS 01605



1700 American Street Worcester, MA 01605

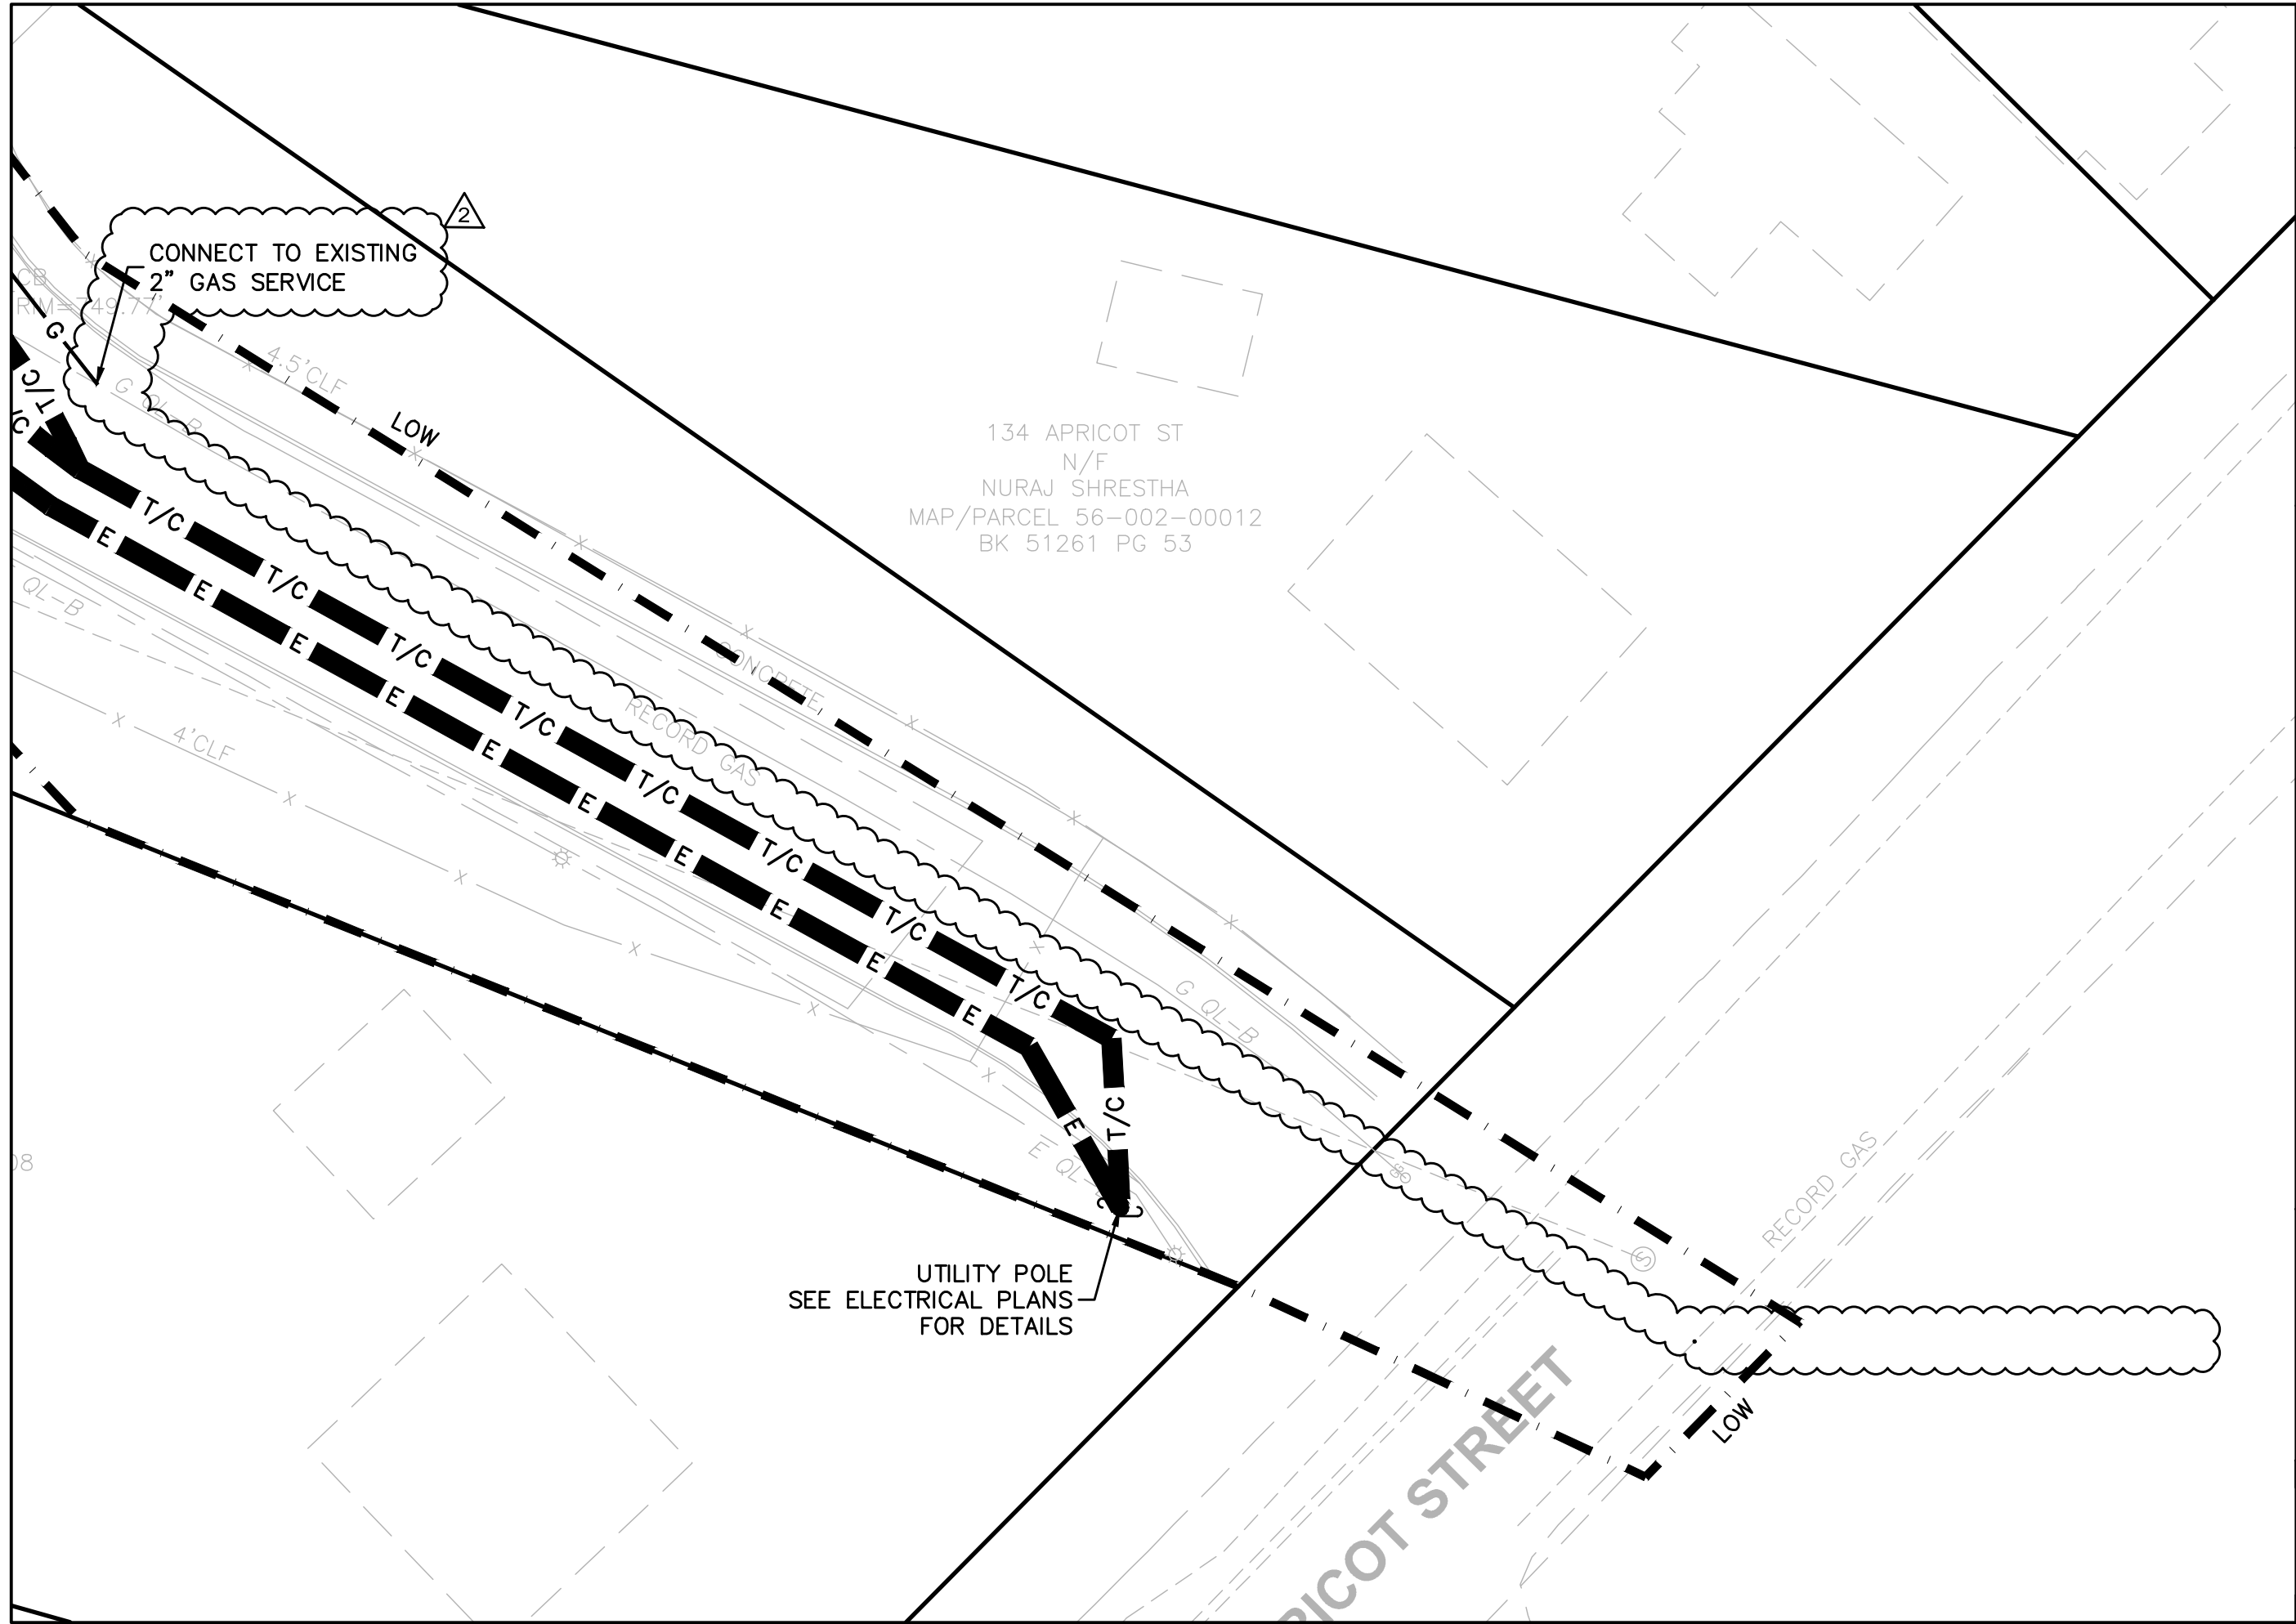


134 APRICOT ST
 N/F
 NURAJ SHRESTHA
 MAP/PARCEL 56-002-00012
 BK 51261 PG 53

CONNECT TO EXISTING
 2" GAS SERVICE

UTILITY POLE
 SEE ELECTRICAL PLANS
 FOR DETAILS

 TAMBORELLI PACANO ASSOCIATES ARCHITECTS 100 SOUTH STREET, SUITE 200 WORCESTER, MASSACHUSETTS 01605	CLIENT INFORMATION: Worcester Public Schools	 WORCESTER PUBLIC SCHOOLS A TOWN JUNE 1836	PROJECT TITLE: EARLY SITE BID PACKAGE #2 South High Community School <small>1700 American Crescent, Worcester, MA 01603</small>	DRAWING NAME: Site Utility Plan Sketch	SHEET REF. NO. C8.3
	DATE: 09/11/18 SCALE: 1"=20'	DRAWING NUMBER: ADD-2 C_008			

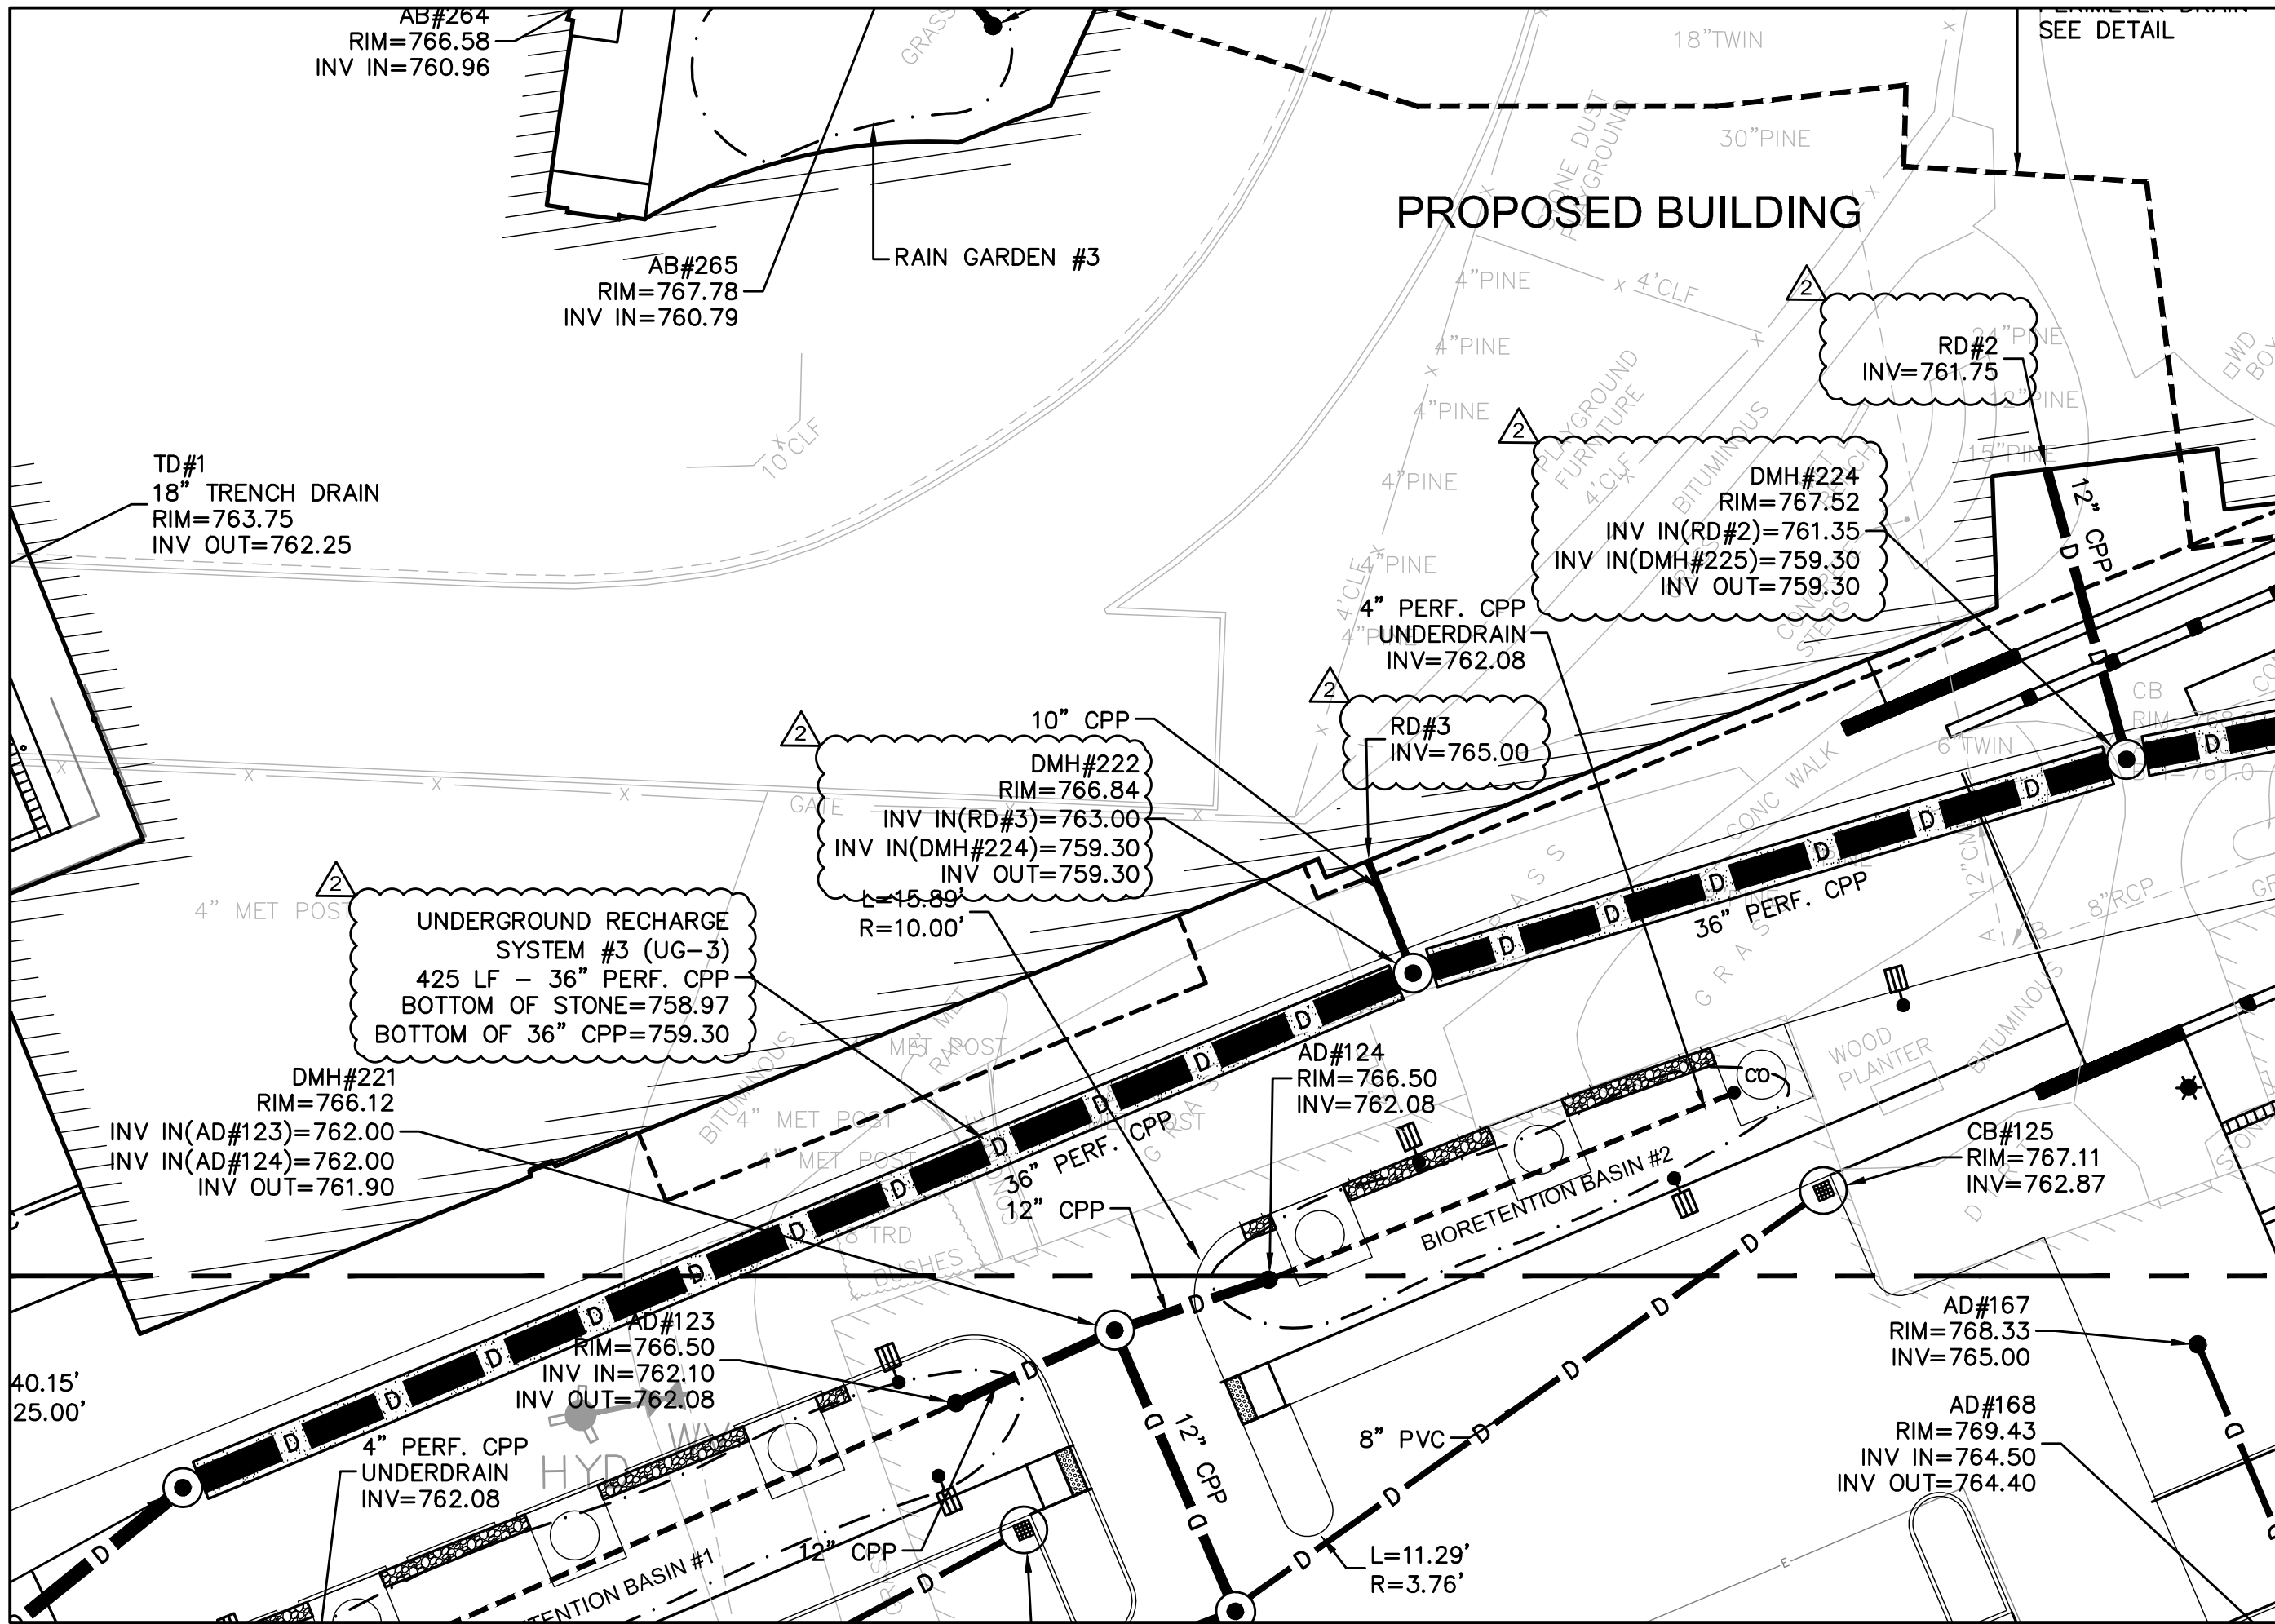

AB#264
RIM=766.58
INV IN=760.96

AB#265
RIM=767.78
INV IN=760.79

TD#1
18" TRENCH DRAIN
RIM=763.75
INV OUT=762.25

UNDERGROUND RECHARGE
SYSTEM #3 (UG-3)
425 LF - 36" PERF. CPP
BOTTOM OF STONE=758.97
BOTTOM OF 36" CPP=759.30

DMH#221
RIM=766.12
INV IN(AD#123)=762.00
INV IN(AD#124)=762.00
INV OUT=761.90

10" CPP
DMH#222
RIM=766.84
INV IN(RD#3)=763.00
INV IN(DMH#224)=759.30
INV OUT=759.30
L=15.89'
R=10.00'

RD#3
INV=765.00

DMH#224
RIM=767.52
INV IN(RD#2)=761.35
INV IN(DMH#225)=759.30
INV OUT=759.30

RD#2
INV=761.75

4" PERF. CPP
4" UNDERDRAIN
INV=762.08

AD#124
RIM=766.50
INV=762.08



CB#125
RIM=767.11
INV=762.87


AD#167
RIM=768.33
INV=765.00

AD#168
RIM=769.43
INV IN=764.50
INV OUT=764.40

40.15'
25.00'

L=11.29'
R=3.76'

SHEET REF. NO. C9.0	DRAWING NUMBER: ADD-2 C-009
DRAWING NAME: Site Drainage Plan Sketch	
PROJECT TITLE: EARLY SITE BID PACKAGE #2	
CLIENT INFORMATION: Worcester Public Schools	
 City of Worcester Massachusetts, 01605	
 LAMOREUX PACHECO ASSOCIATES ARCHITECTS 101 FERRY & REEL, SUITE 400 WASHINGTON, MASSACHUSETTS 01888 THE AMERICAN INSTITUTE OF ARCHITECTS	

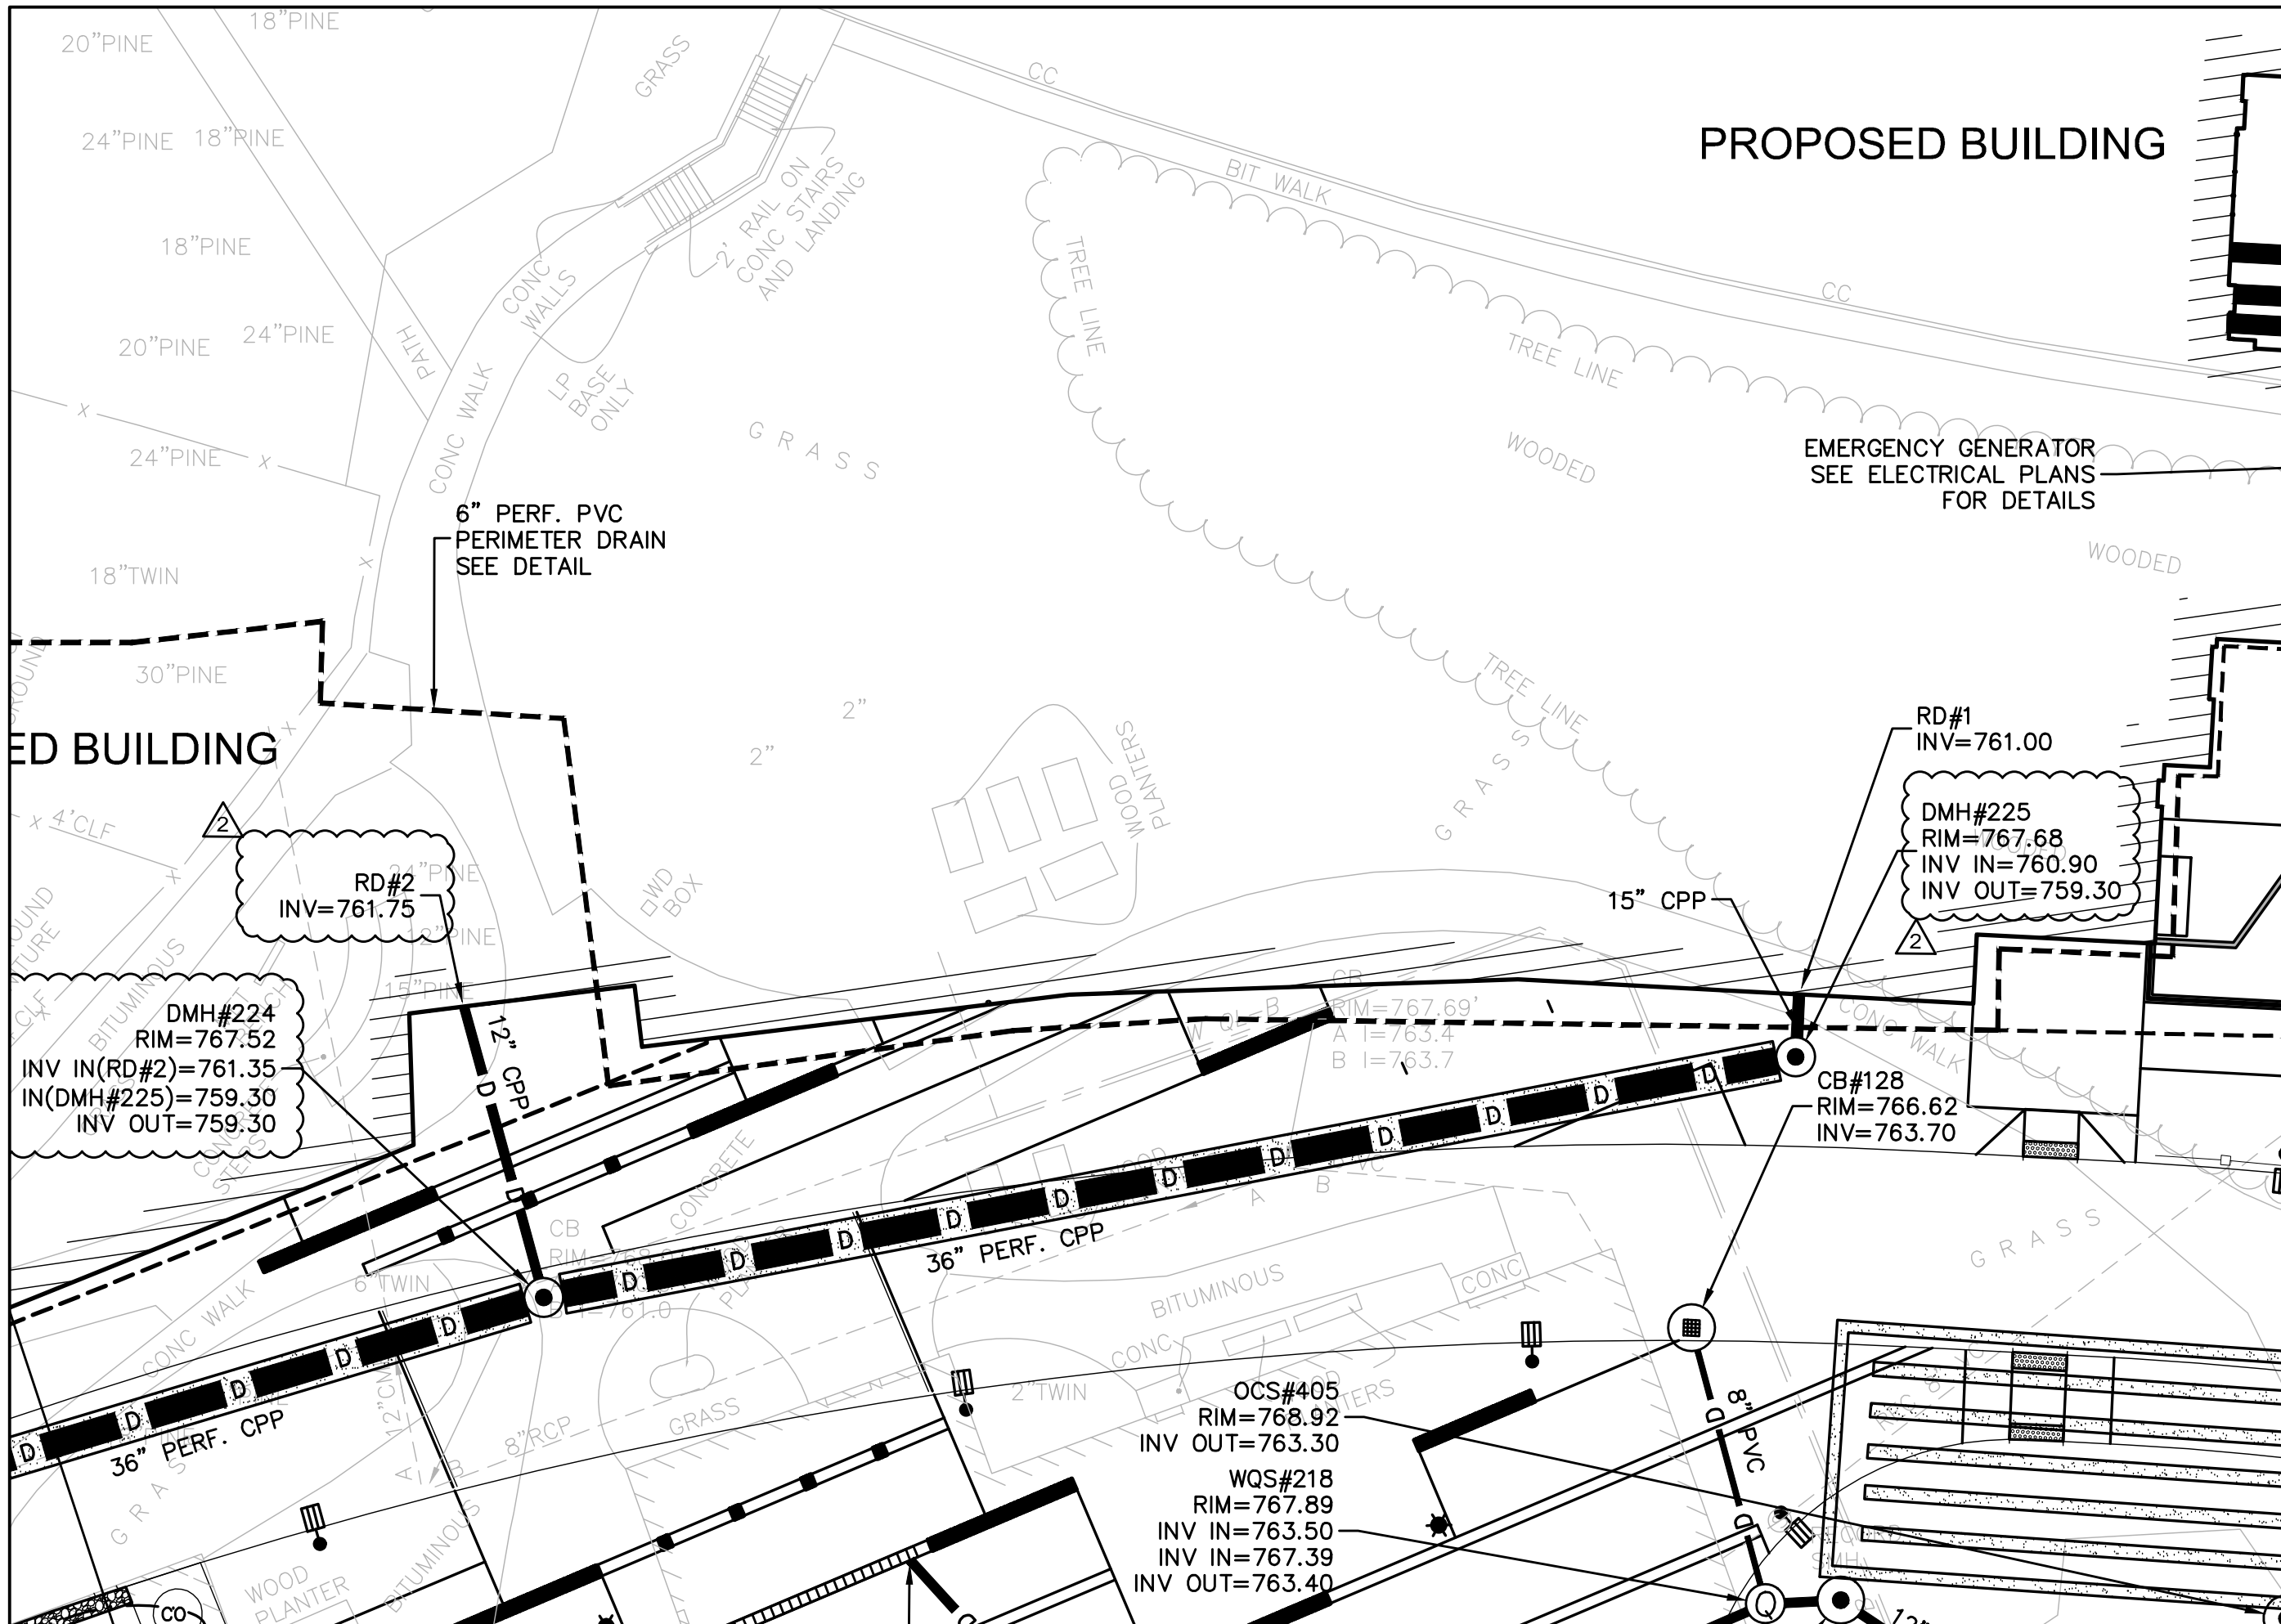

PROPOSED BUILDING

EMERGENCY GENERATOR
SEE ELECTRICAL PLANS
FOR DETAILS

6" PERF. PVC
PERIMETER DRAIN
SEE DETAIL

RD#2
INV=761.75

DMH#224
RIM=767.52
INV IN(RD#2)=761.35
IN(DMH#225)=759.30
INV OUT=759.30

RD#1
INV=761.00

DMH#225
RIM=767.68
INV IN=760.90
INV OUT=759.30

CB#128
RIM=766.62
INV=763.70

OCS#405
RIM=768.92
INV OUT=763.30

WQS#218
RIM=767.89
INV IN=763.50
INV IN=767.39
INV OUT=763.40

SHEET REF. NO. C9.1


DRAWING NUMBER: ADD-2
C-010

DATE: 09/11/18
SCALE: 1"=20'

DRAWING NAME: Site Drainage Plan Sketch


PROJECT TITLE: EARLY SITE BID PACKAGE #2
South High Community School
170 Apricot Street, Worcester, MA 01603

CLIENT INFORMATION: Worcester Public Schools




City of Worcester
Massachusetts, 01605

MEMBER OF THE AMERICAN INSTITUTE OF ARCHITECTS



LANOUILLE PACHINO ASSOCIATES ARCHITECTS
105 GOLF VIEW DRIVE SUITE 200
WORCESTER, MASSACHUSETTS 01605

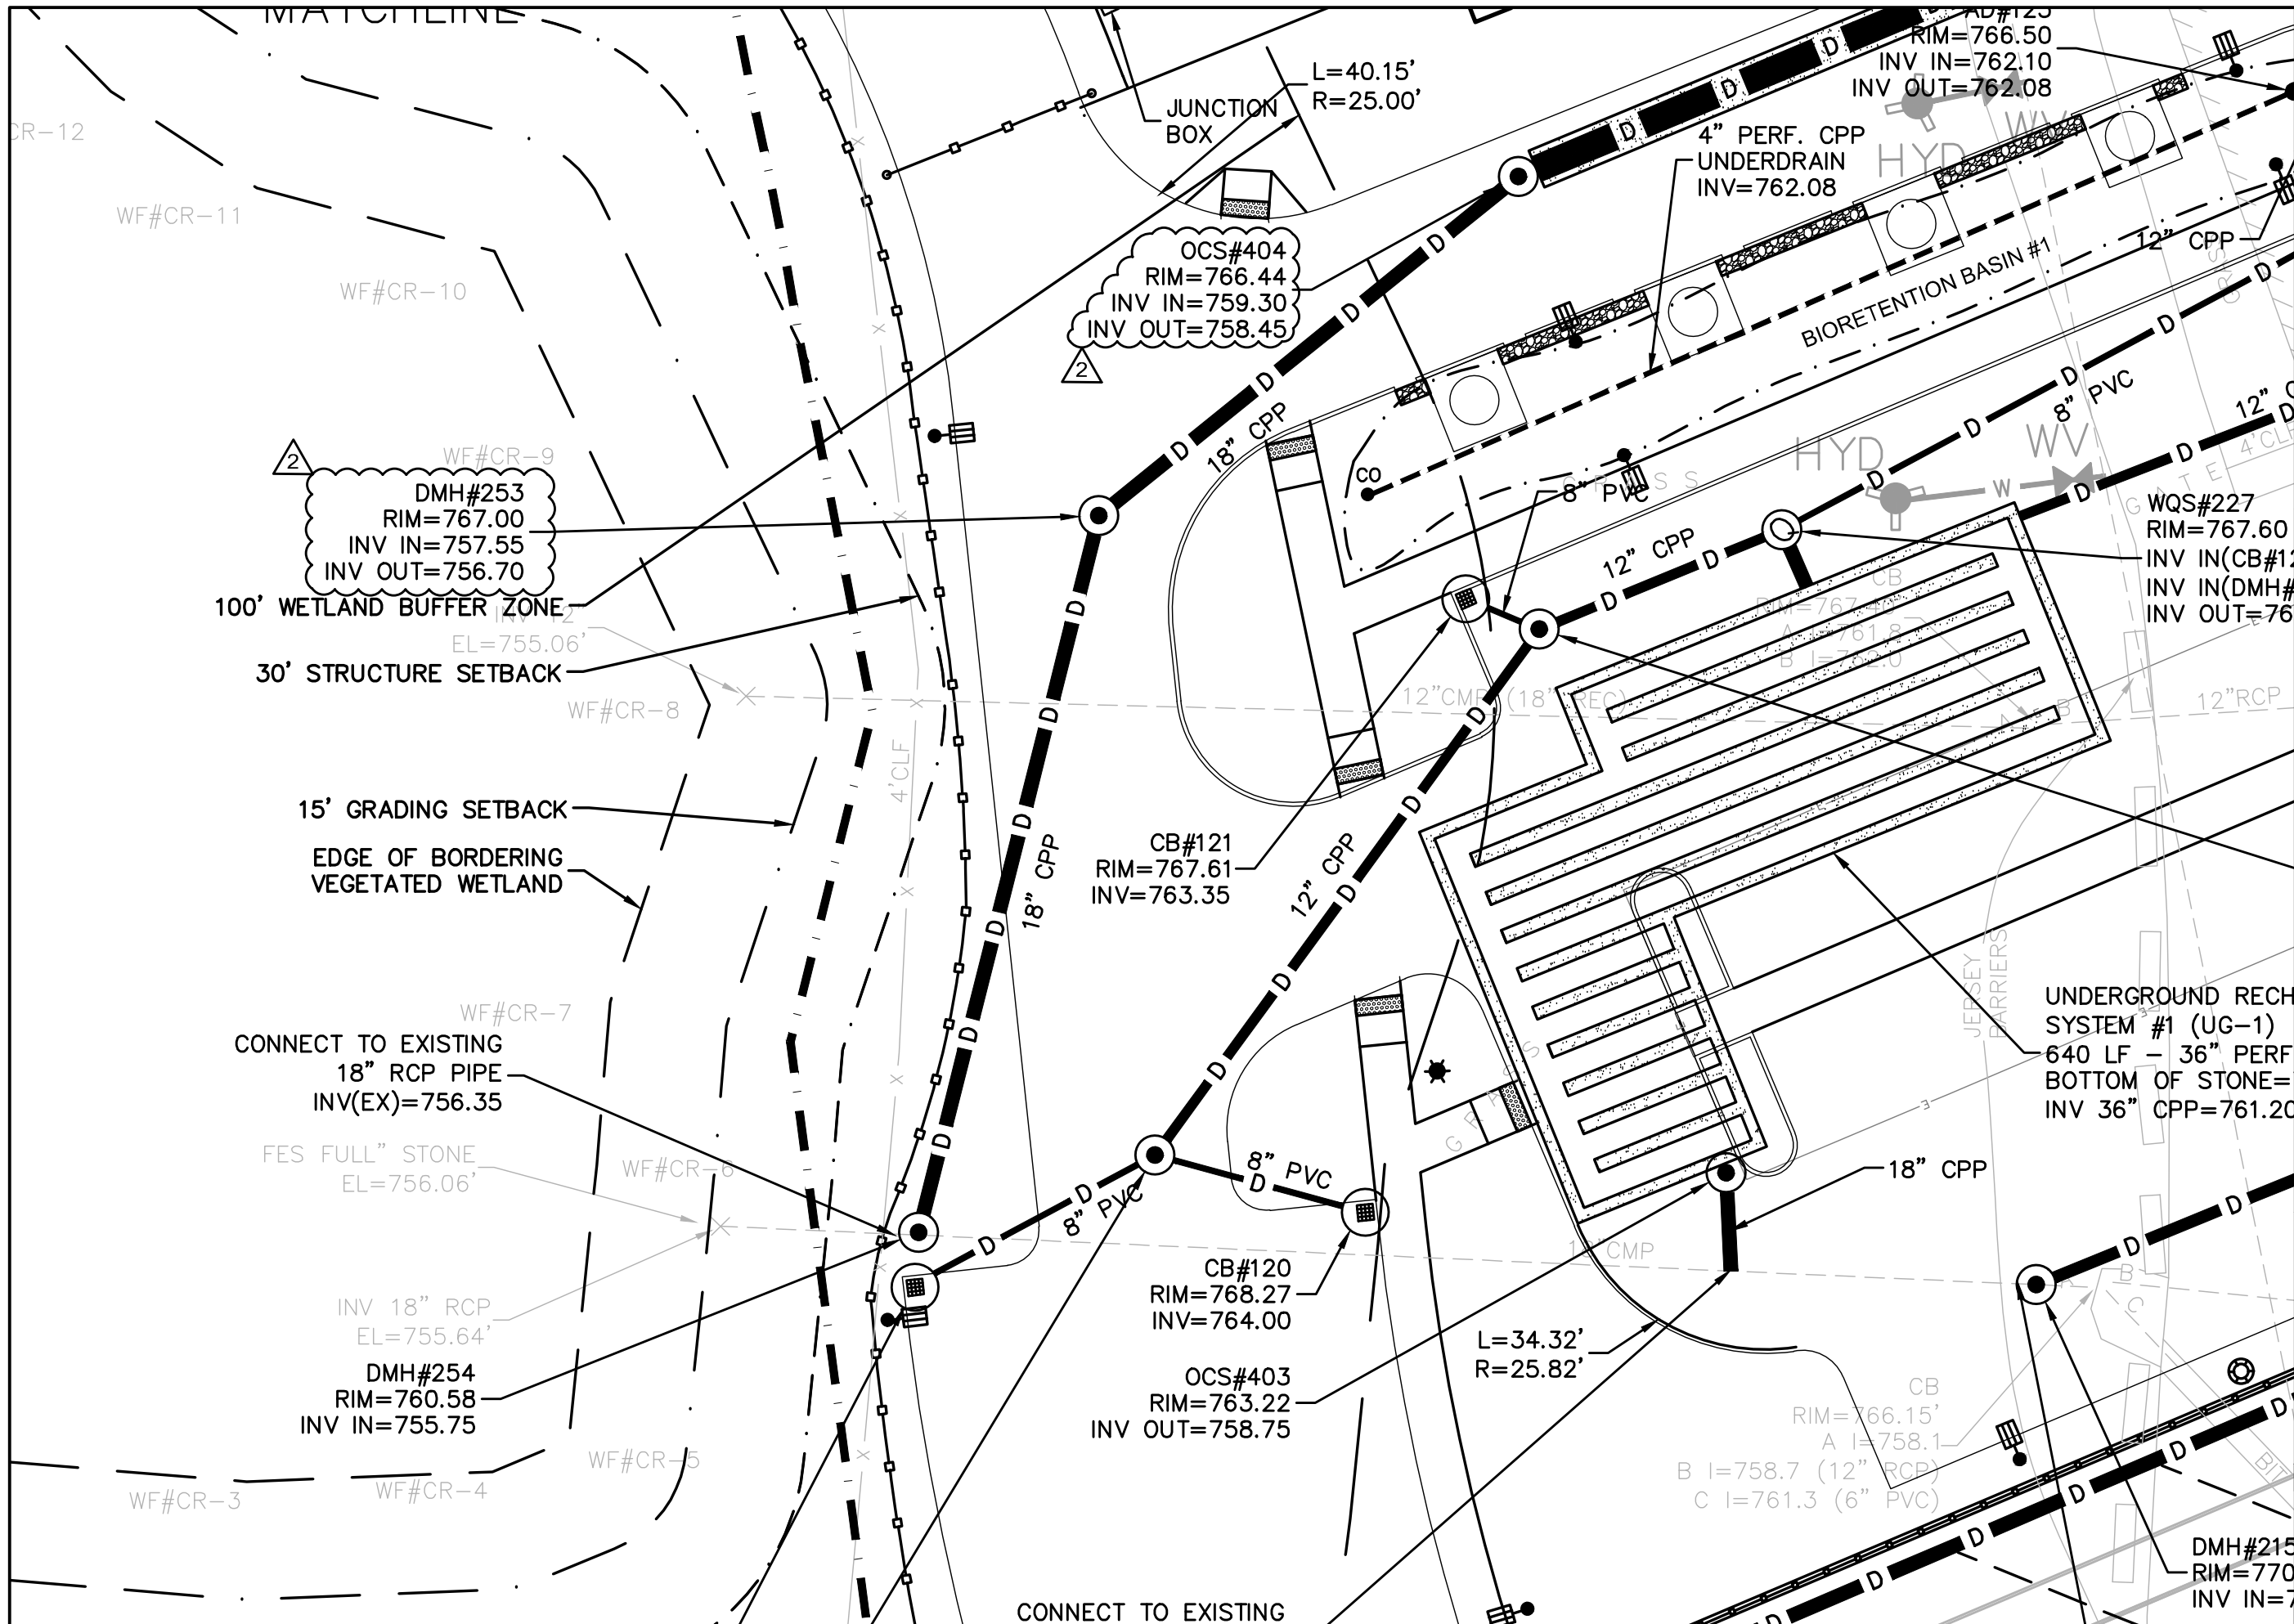

SHEET REF. NO.	C9.2
DRAWING NUMBER:	ADD-2 C-011
DATE:	09/11/18
SCALE:	1" = 20'

DRAWING NAME:
Site Drainage Plan Sketch

PROJECT TITLE:
EARLY SITE BID PACKAGE #2
South High Community School
170 Apricot Street, Worcester, MA 01603

CLIENT INFORMATION:
Worcester Public Schools



City of Worcester
Massachusetts, 01603

MEMBER OF
THE AMERICAN INSTITUTE OF ARCHITECTS

LAURENCE P. PACINO
ASSOCIATES, ARCHITECTS
108 SCOTT ST. SUITE 400
WORCESTER, MASSACHUSETTS 01603

WF#CR-9
DMH#253
RIM=767.00
INV IN=757.55
INV OUT=756.70

OCS#404
RIM=766.44
INV IN=759.30
INV OUT=758.45

AD#125
RIM=766.50
INV IN=762.10
INV OUT=762.08

WQS#227
RIM=767.60
INV IN(CB#121)=767.61
INV IN(DMH#253)=757.55
INV OUT=756.70

CB#121
RIM=767.61
INV=763.35

CB#120
RIM=768.27
INV=764.00

OCS#403
RIM=763.22
INV OUT=758.75

CB
RIM=766.15
A I=758.1
B I=758.7 (12" RCP)
C I=761.3 (6" PVC)

DMH#215
RIM=770.00
INV IN=769.00

100' WETLAND BUFFER ZONE
30' STRUCTURE SETBACK
EL=755.06'

15' GRADING SETBACK
EDGE OF BORDERING
VEGETATED WETLAND

CONNECT TO EXISTING
18" RCP PIPE
INV(EX)=756.35

FES FULL" STONE
EL=756.06'

INV 18" RCP
EL=755.64'

DMH#254
RIM=760.58
INV IN=755.75

CONNECT TO EXISTING

UNDERGROUND RECH
SYSTEM #1 (UG-1)
640 LF - 36" PERF
BOTTOM OF STONE=
INV 36" CPP=761.20

L=40.15'
R=25.00'


L=34.32'
R=25.82'

4" PERF. CPP
UNDERDRAIN
INV=762.08

BIORETENTION BASIN #1

UNDERGROUND RECH
SYSTEM #1 (UG-1)
640 LF - 36" PERF
BOTTOM OF STONE=
INV 36" CPP=761.20


PROJECT INFORMATION:
Worcester Public Schools



City of Worcester
Massachusetts, 01603

MEMBER OF
THE AMERICAN INSTITUTE OF ARCHITECTS

LAURENCE P. PACINO
ASSOCIATES, ARCHITECTS
108 SCOTT ST. SUITE 400
WORCESTER, MASSACHUSETTS 01603

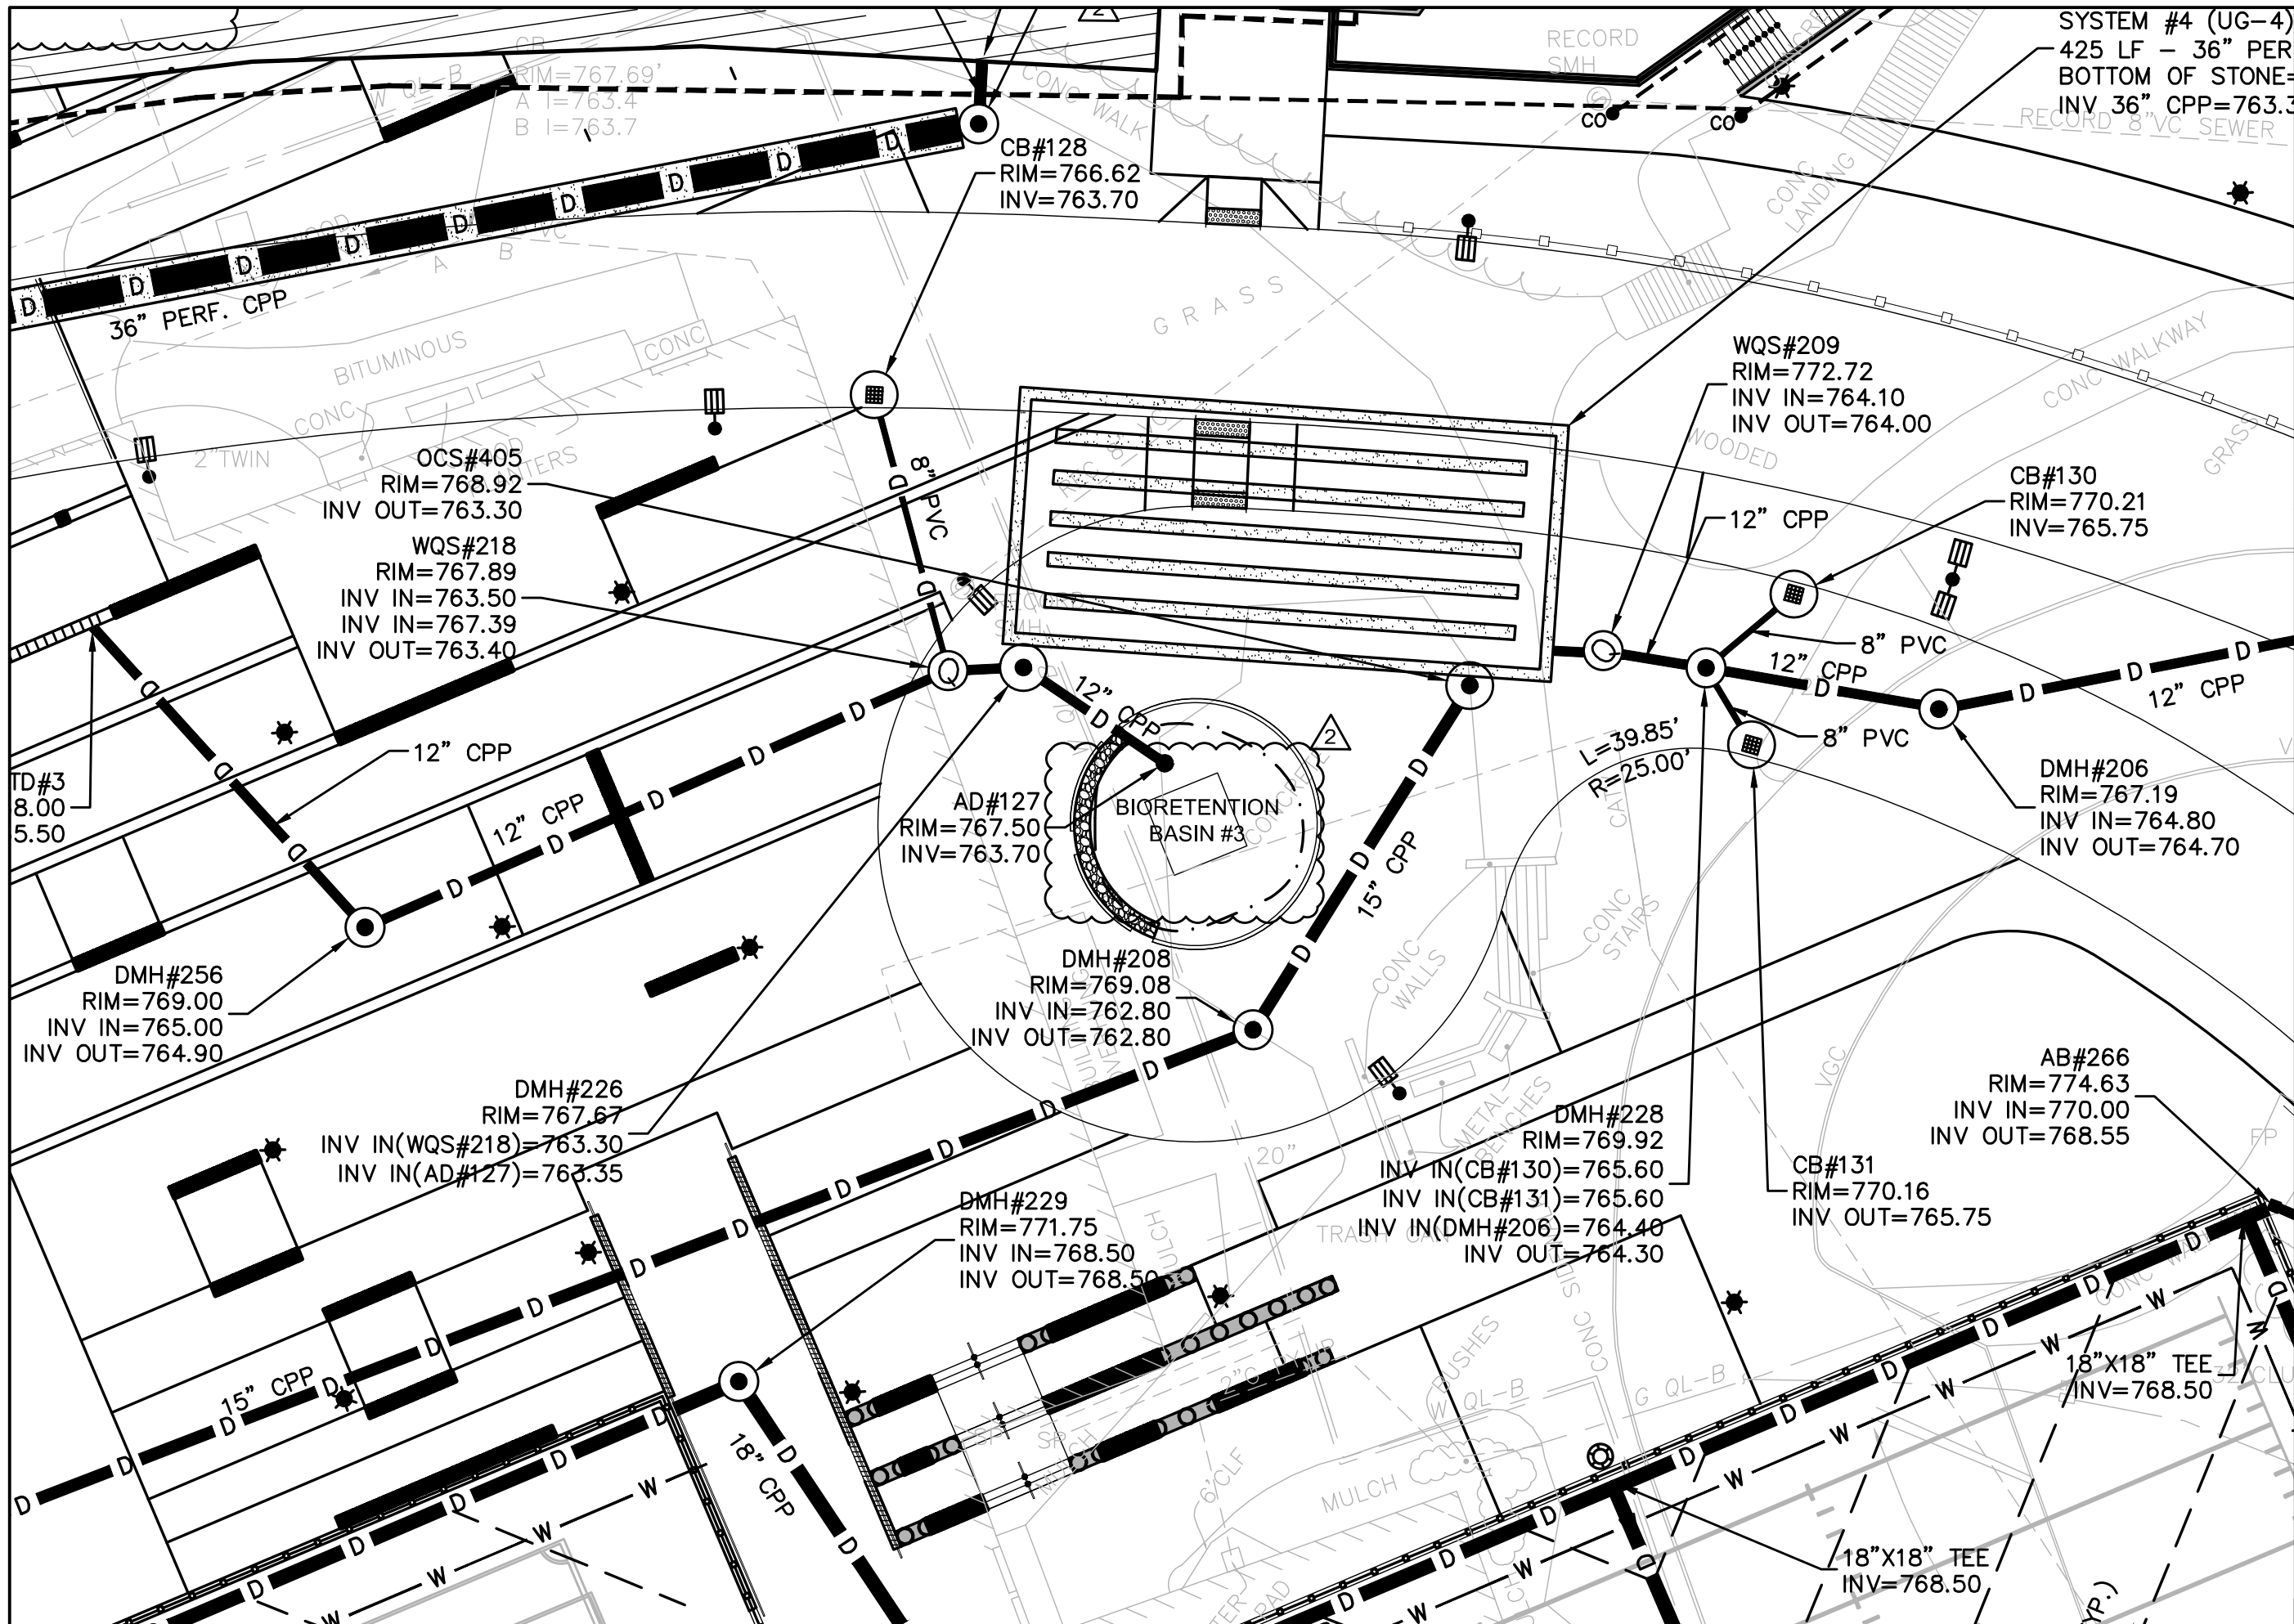

SHEET REF. NO. C9.1
 DRAWING NAME: Site Drainage Plan Sketch

DRAWING NUMBER: ADD-2
 SCALE: 1" = 20'
 DATE: 09/11/18

PROJECT TITLE: EARLY SITE BID PACKAGE #2

Client Information:
 Worcester Public Schools
 City of Worcester
 Massachusetts, 01605

CLIENT INFORMATION:
 Worcester Public Schools




City of Worcester
 Massachusetts, 01605

MEMBER OF
 THE AMERICAN INSTITUTE OF ARCHITECTS

South High Community School

170 Apricot Street, Worcester, MA 01603

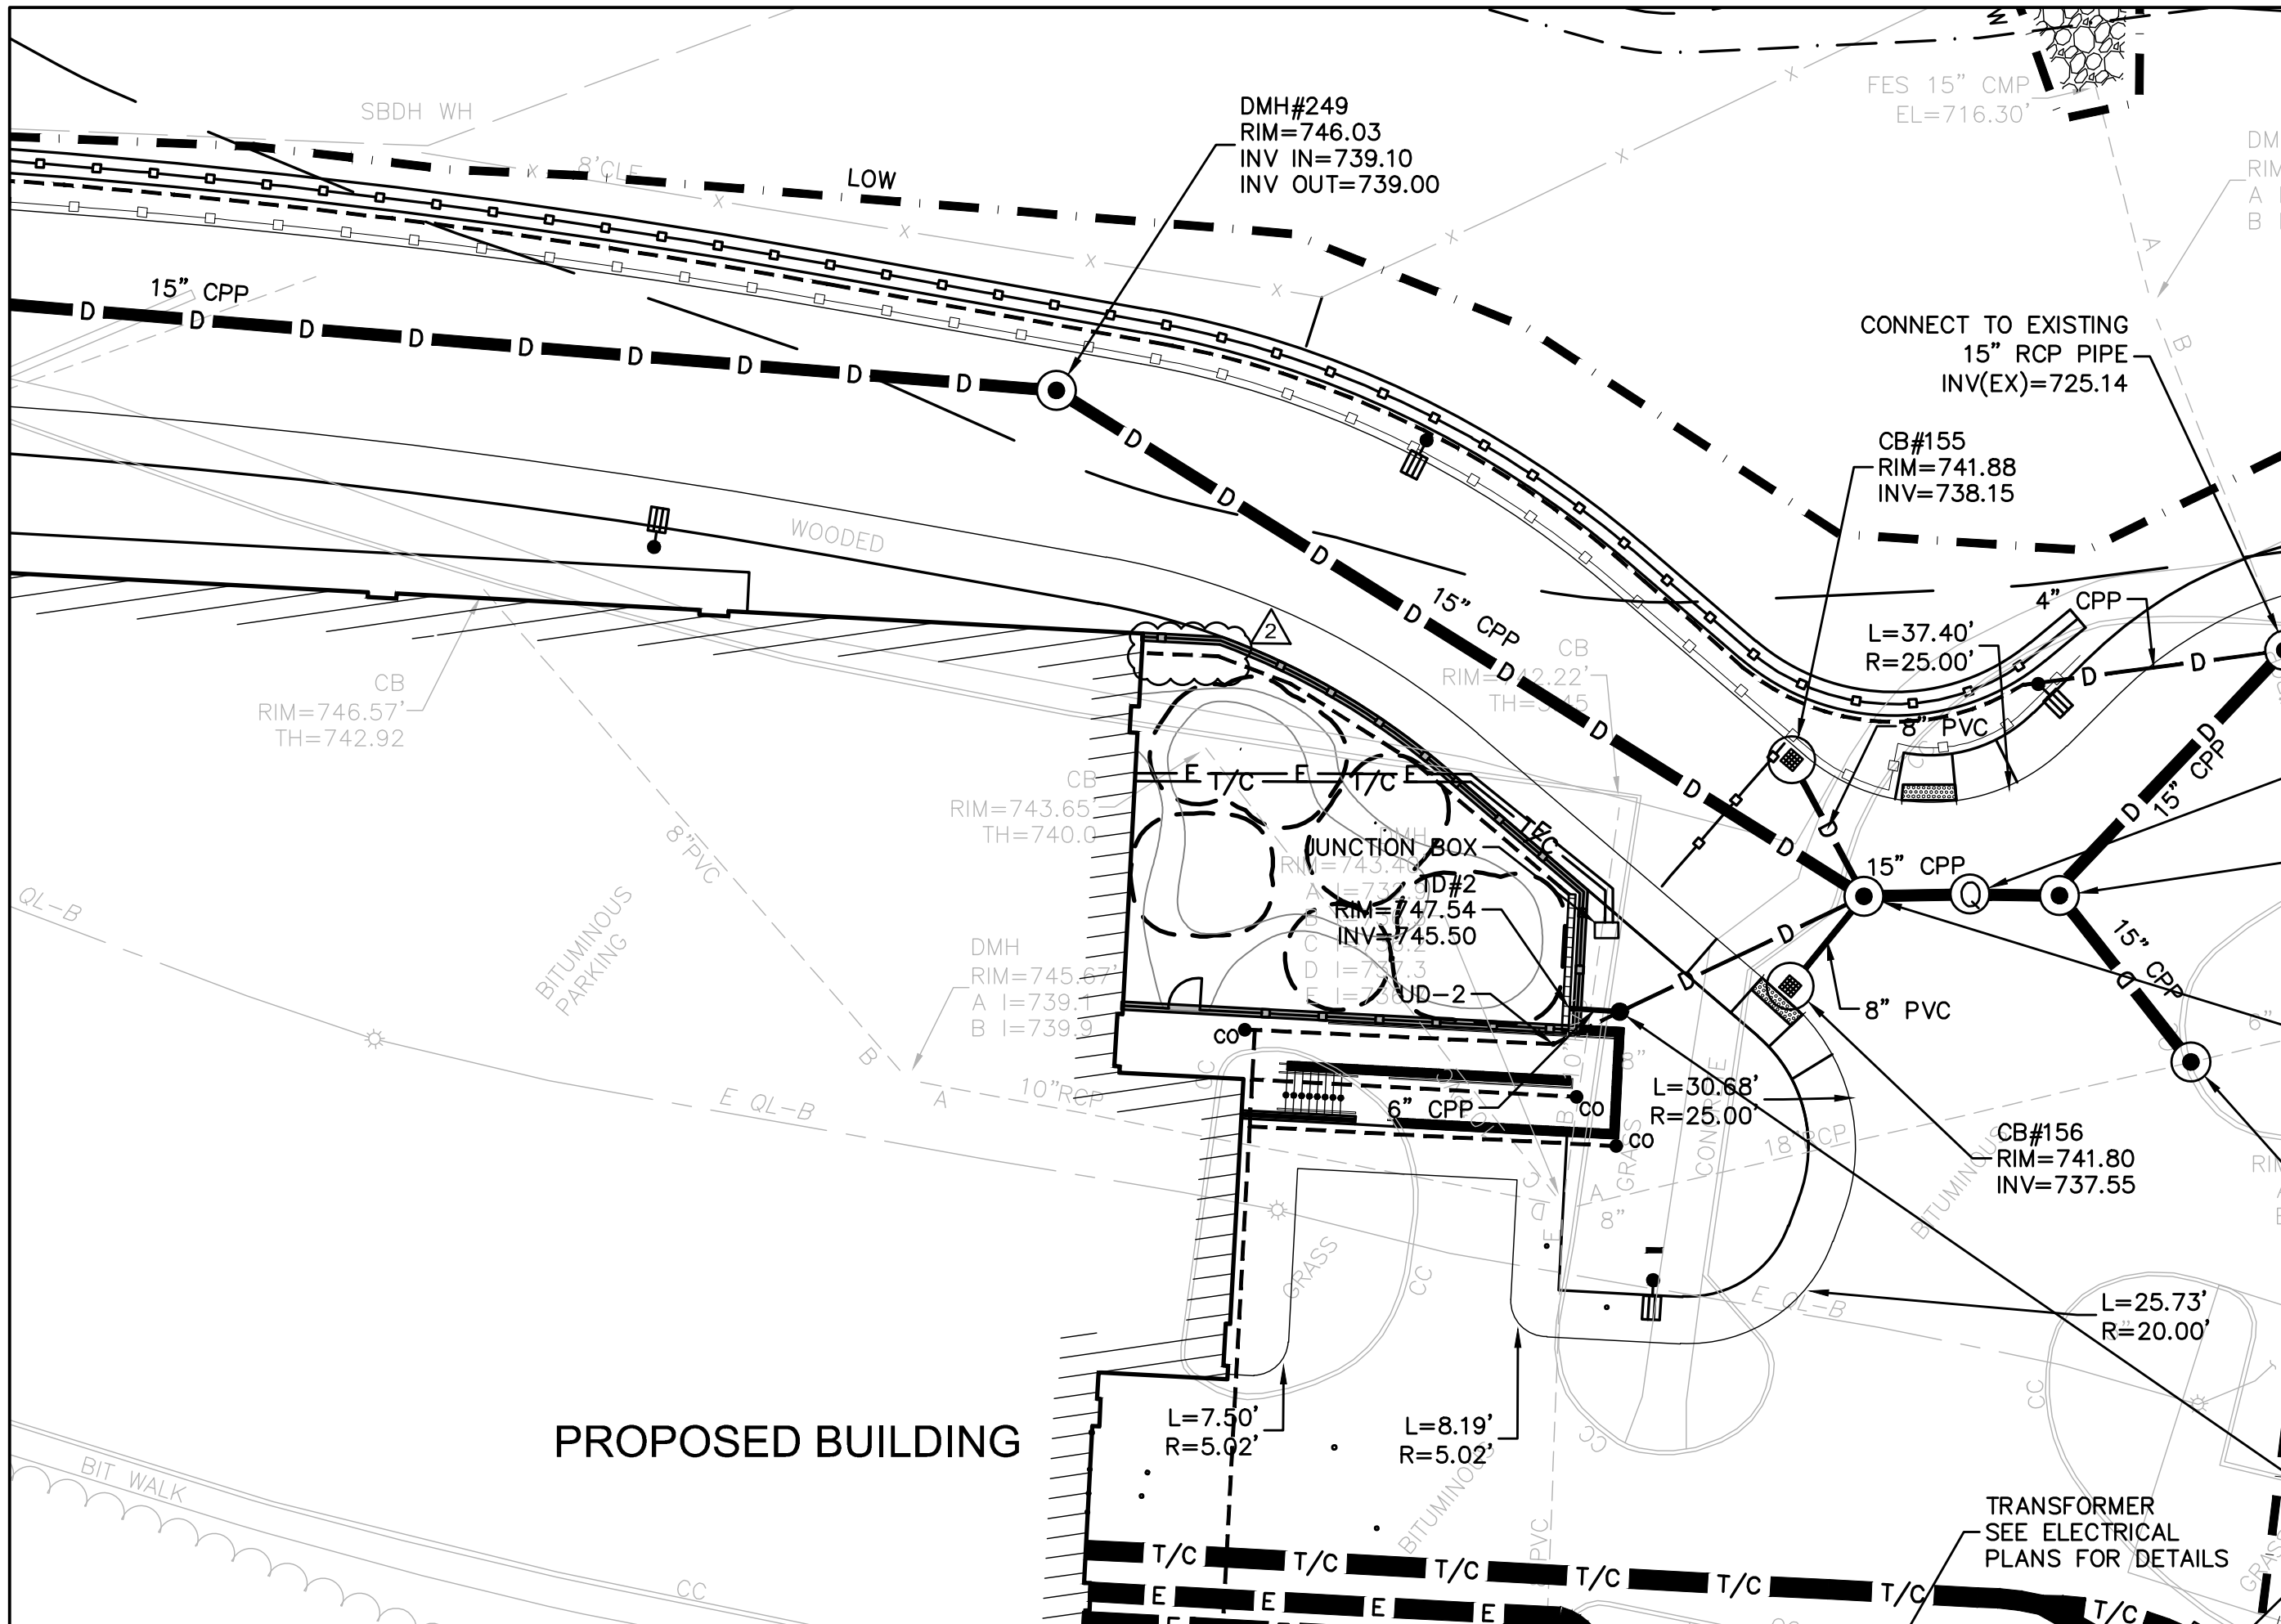

SHEET REF. NO. C9.1
 DRAWING NAME: Site Drainage Plan Sketch

DRAWING NUMBER: ADD-2
 C-013
 DATE: 09/11/18
 SCALE: 1" = 20'

PROJECT TITLE: EARLY SITE BID PACKAGE #2

South High Community School
 170 Apricot Street, Worcester, MA 01603

CLIENT INFORMATION:
 Worcester Public Schools



MEMBER OF THE AMERICAN INSTITUTE OF ARCHITECTS

PROPOSED BUILDING

TRANSFORMER
 SEE ELECTRICAL
 PLANS FOR DETAILS

DMH#249
 RIM=746.03
 INV IN=739.10
 INV OUT=739.00

FES 15" CMP
 EL=716.30'

CONNECT TO EXISTING
 15" RCP PIPE
 INV(EX)=725.14

CB#155
 RIM=741.88
 INV=738.15

L=37.40'
 R=25.00'

CB
 RIM=746.57'
 TH=742.92

CB
 RIM=743.65
 TH=740.0

JUNCTION BOX
 RIM=747.54
 INV=745.50


DMH
 RIM=745.67
 A I=739.1
 B I=739.9

CB#156
 RIM=741.80
 INV=737.55

L=25.73'
 R=20.00'

L=7.50'
 R=5.02'

L=8.19'
 R=5.02'

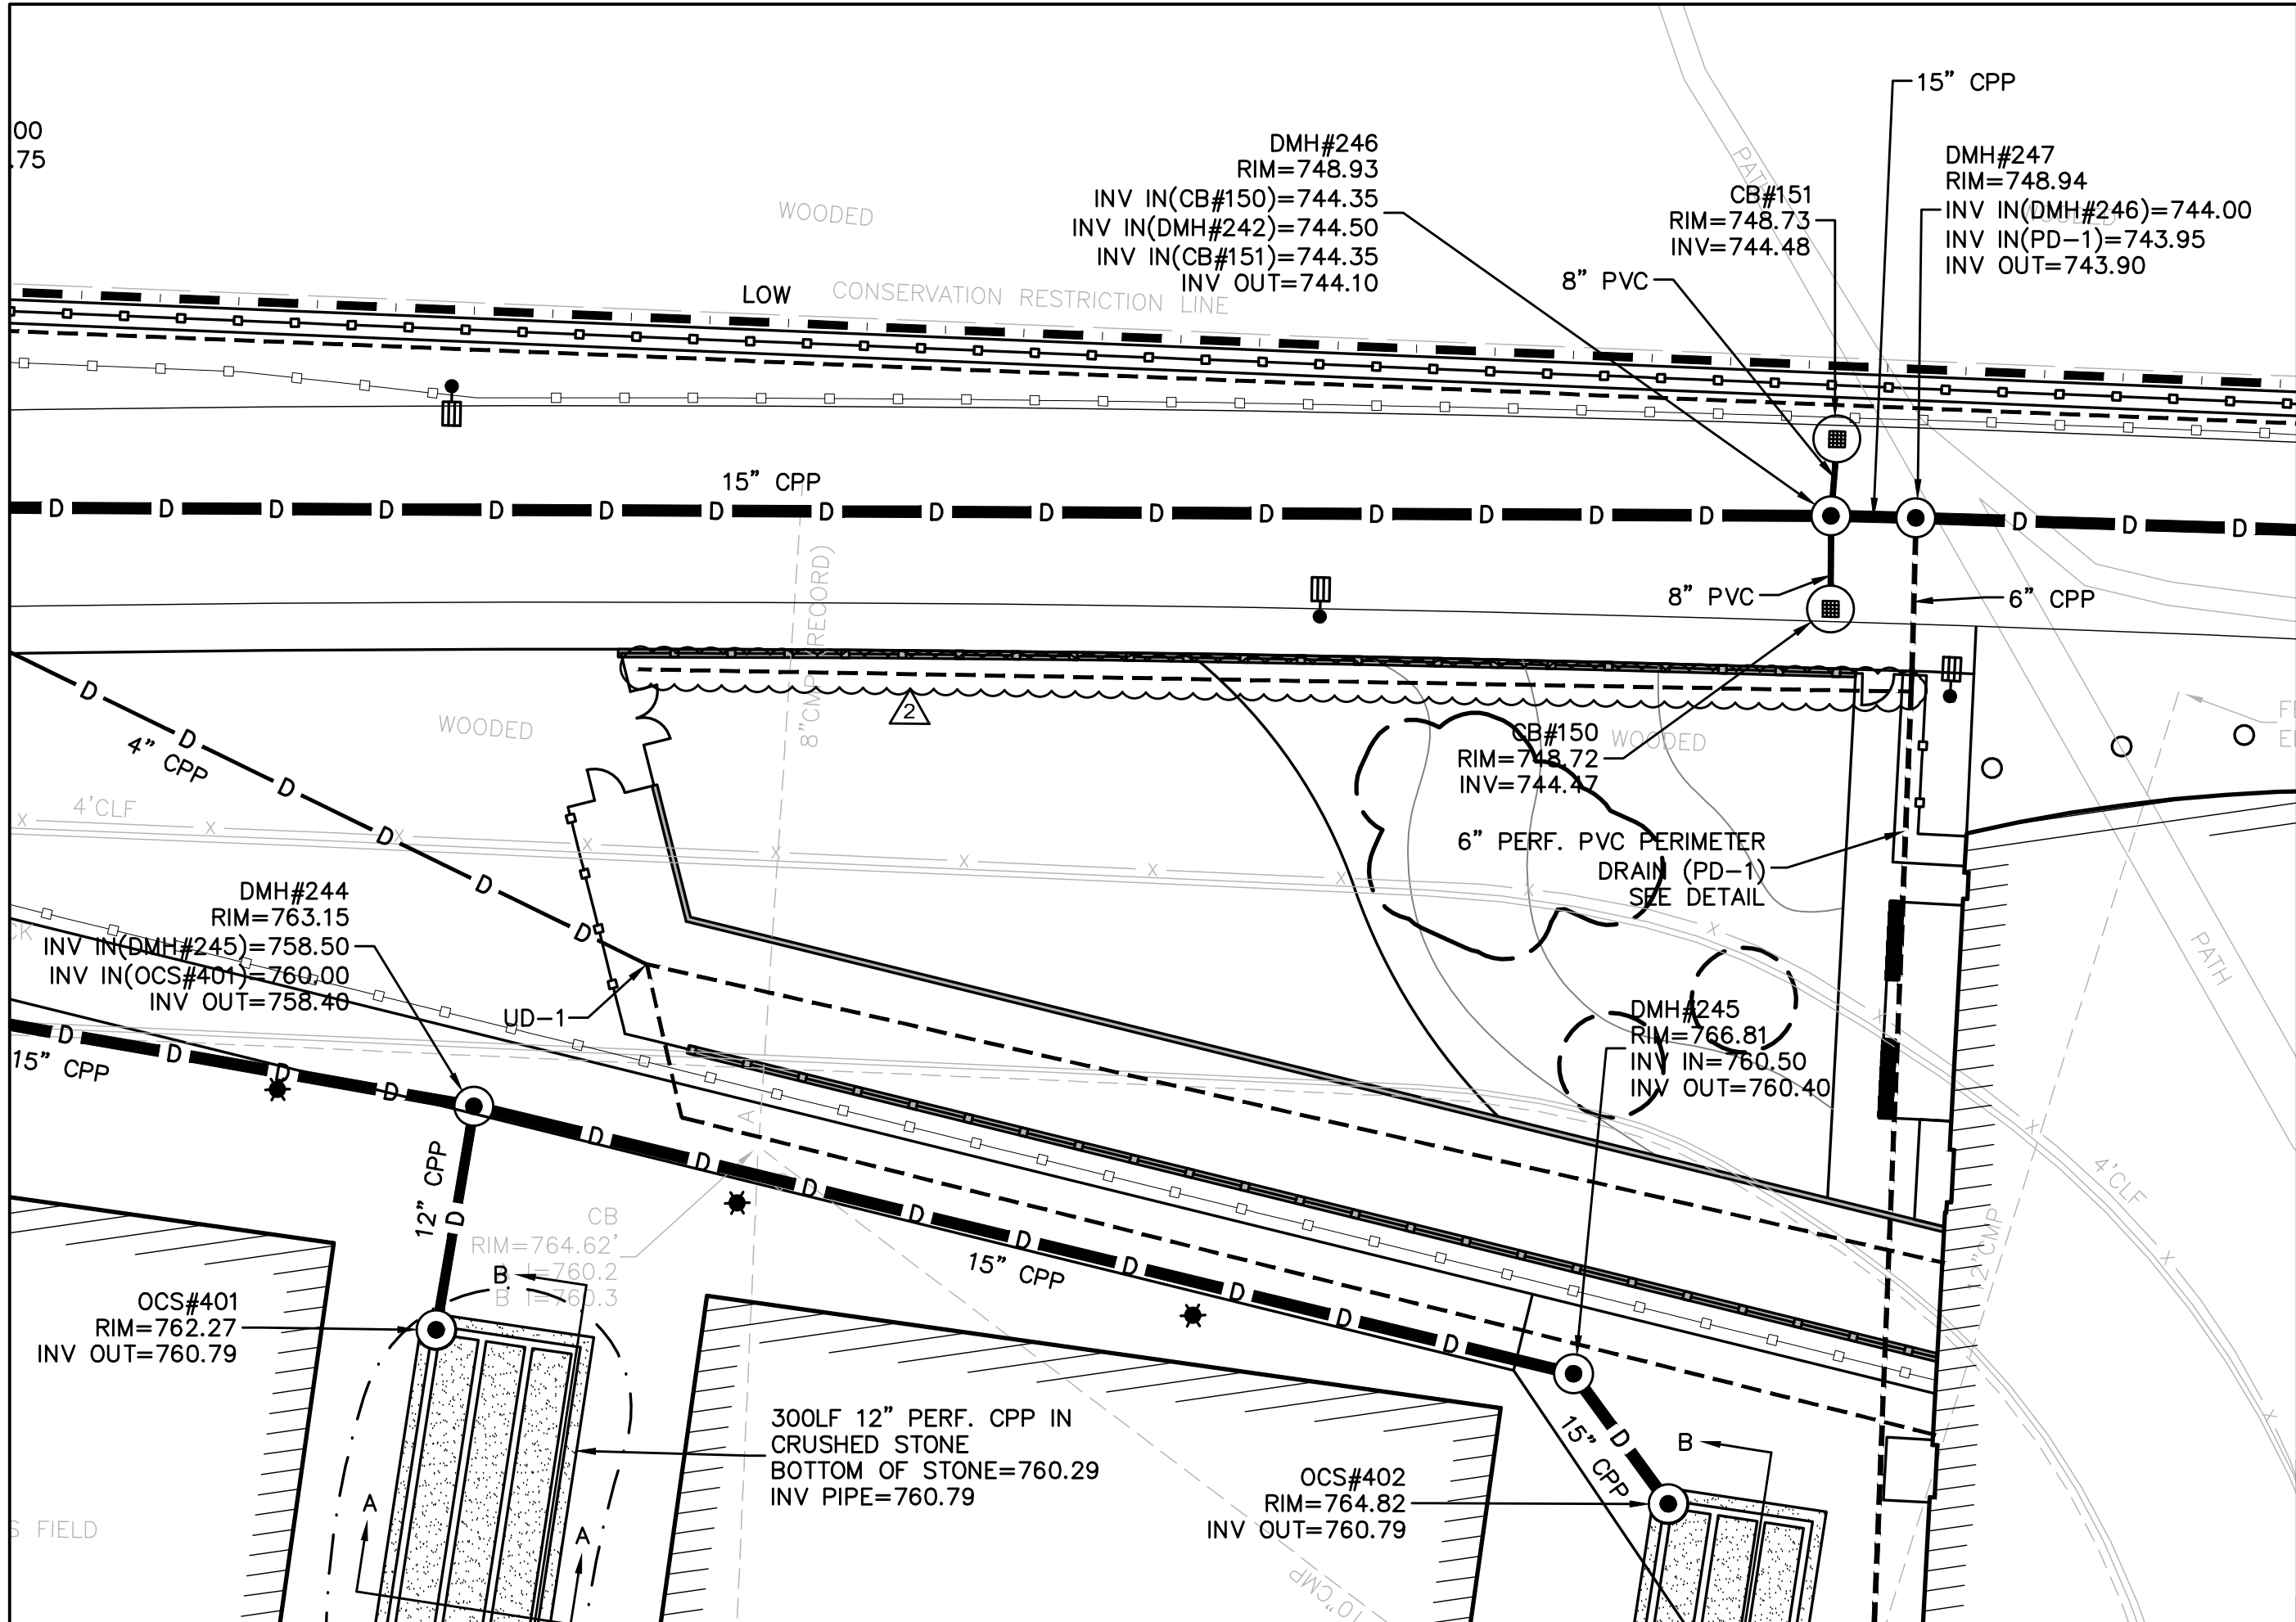

SHEET REF. NO.
C9.0

DRAWING NAME:
Site Drainage Plan Sketch

DRAWING NUMBER:
ADD-2
C-014

DATE:
09/11/18


SCALE:
1" = 20'

PROJECT TITLE:
EARLY SITE BID PACKAGE #2

Client Information:
Worcester Public Schools

South High Community School
170 Apricot Street, Worcester, MA 01603



CLIENT INFORMATION:
Worcester Public Schools





City of Worcester
Massachusetts, 01603

MEMBER OF
THE AMERICAN INSTITUTE OF ARCHITECTS

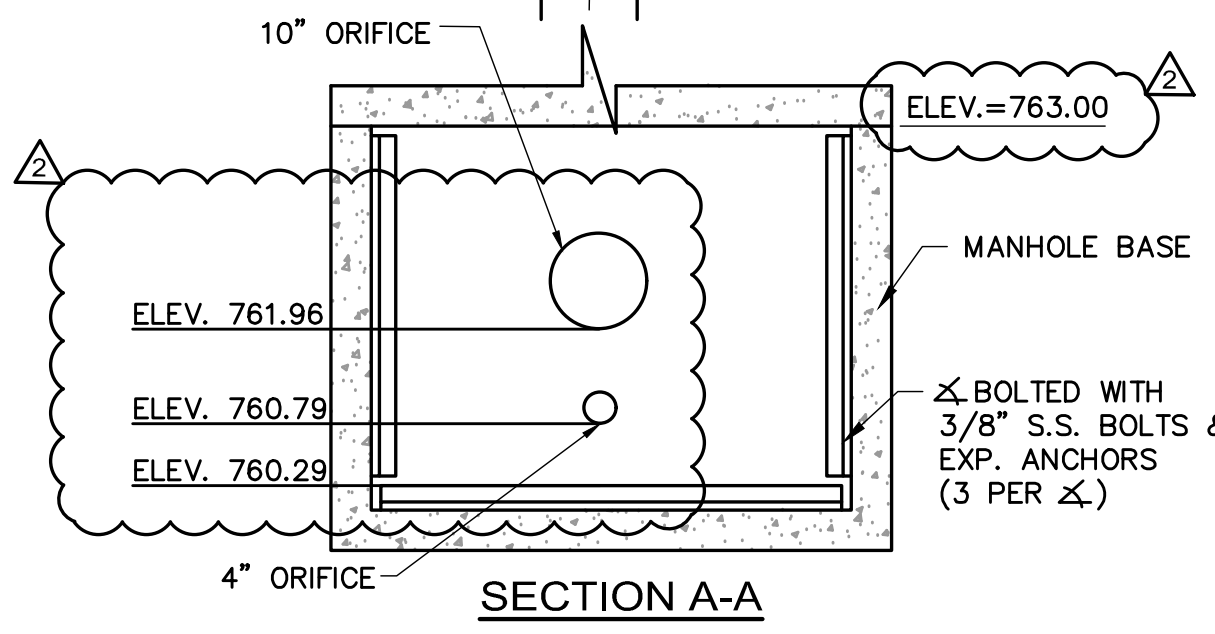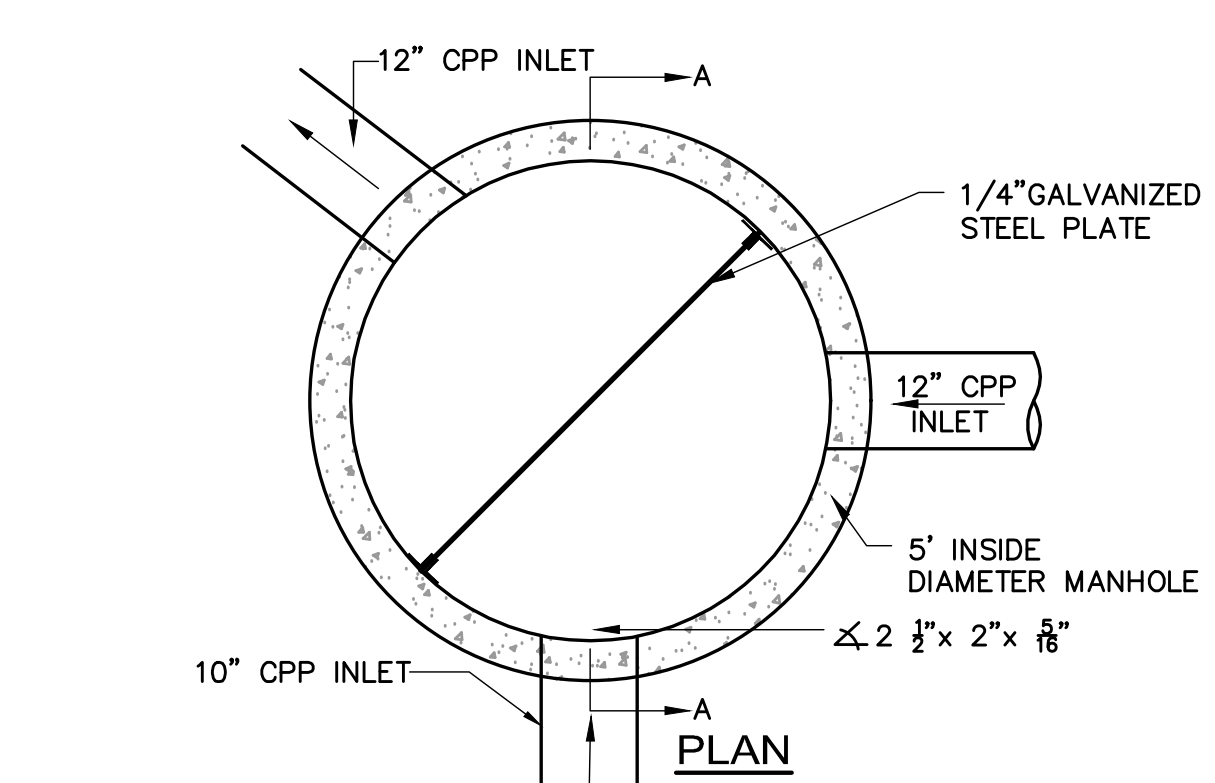

LAURENCE P. PAGANO
ASSOCIATES, ARCHITECTS
108 STATE STREET, SUITE 400
WORCESTER, MASSACHUSETTS 01603

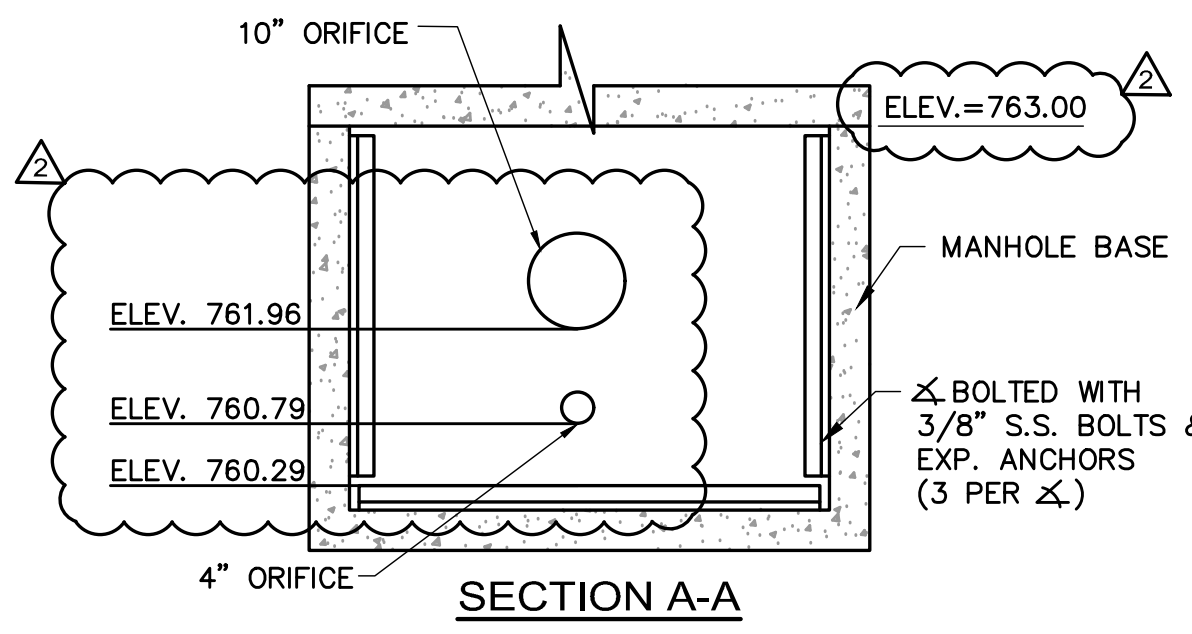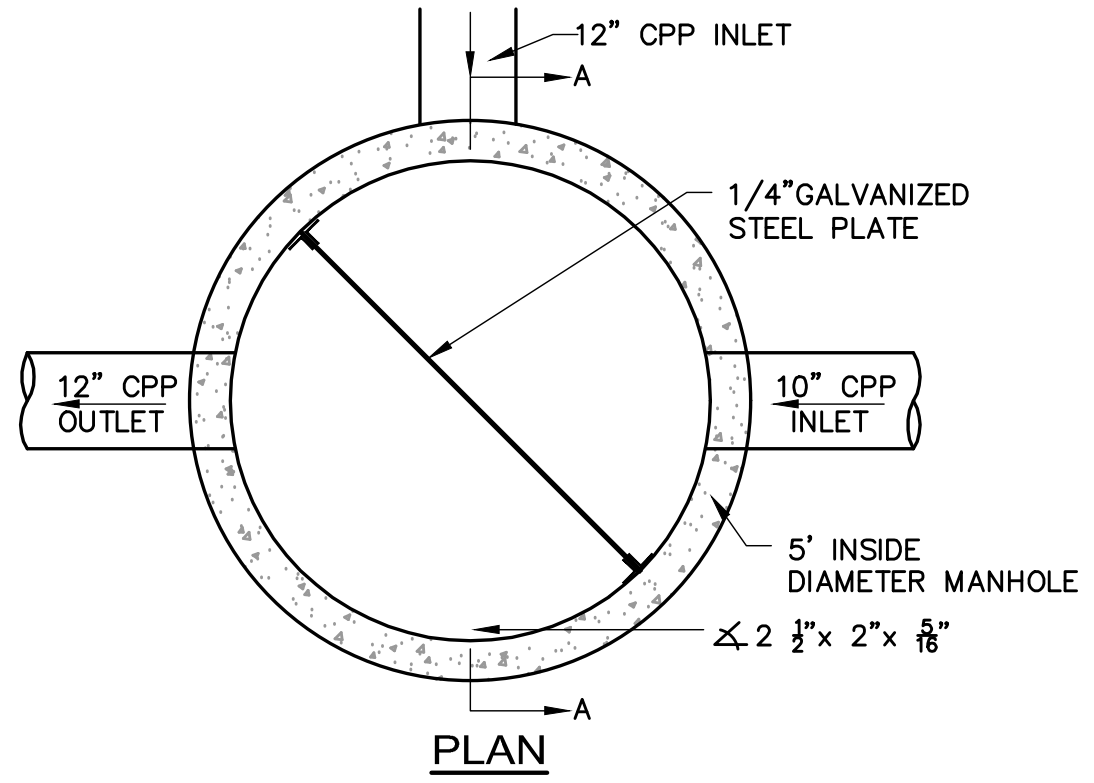

**OUTLET CONTROL STRUCTURE
OCS#400 (RAIN GARDEN #1)**
NOT TO SCALE



**OUTLET CONTROL STRUCTURE
OCS#401 (RAIN GARDEN #2)**
NOT TO SCALE

SHEET REF. NO. C11.2	DRAWING NAME: Civil Detail Sketch	DRAWING NUMBER: ADD-2 C-015
PROJECT TITLE: EARLY SITE BID PACKAGE #2 South High Community School 170 Apricot Street, Worcester, MA 01603		
CLIENT INFORMATION: Worcester Public Schools	 City of Worcester Massachusetts, 01605	
 LAMORTUS PACANO ASSOCIATES, ARCHITECTS 178 STATE STREET, SUITE 400 WORCESTER, MASSACHUSETTS 01605 THE AMERICAN INSTITUTE OF ARCHITECTS		

SHEET REF. NO.	C11.2
DRAWING NAME:	Civil Detail Sketch
DATE:	09/11/18
SCALE:	As Noted
DRAWING NUMBER:	ADD-2 C-016

PROJECT TITLE:
EARLY SITE BID PACKAGE #2

South High Community School
170 Apricot Street, Worcester, MA 01603

CLIENT INFORMATION:
Worcester Public Schools





City of Worcester
Worcester, Massachusetts, 01605





LAMORTIUS PAGANO
ASSOCIATES, ARCHITECTS
178 COLLE & REES, SUITE 400
WORCESTER, MASSACHUSETTS 01605

THE AMERICAN INSTITUTE OF ARCHITECTS

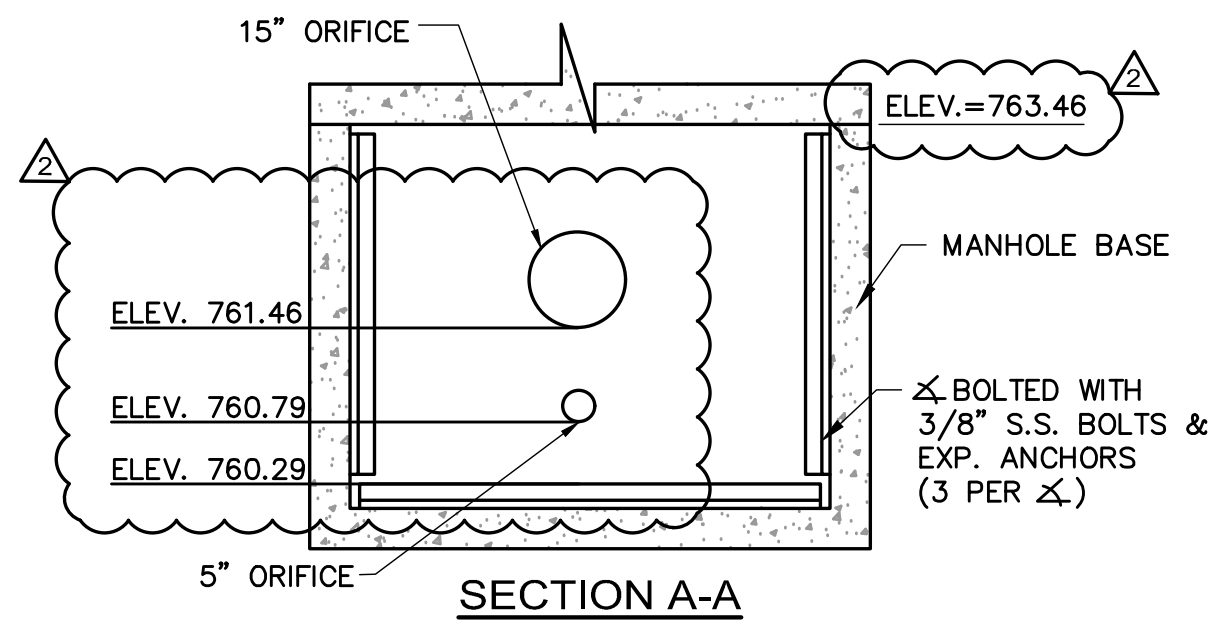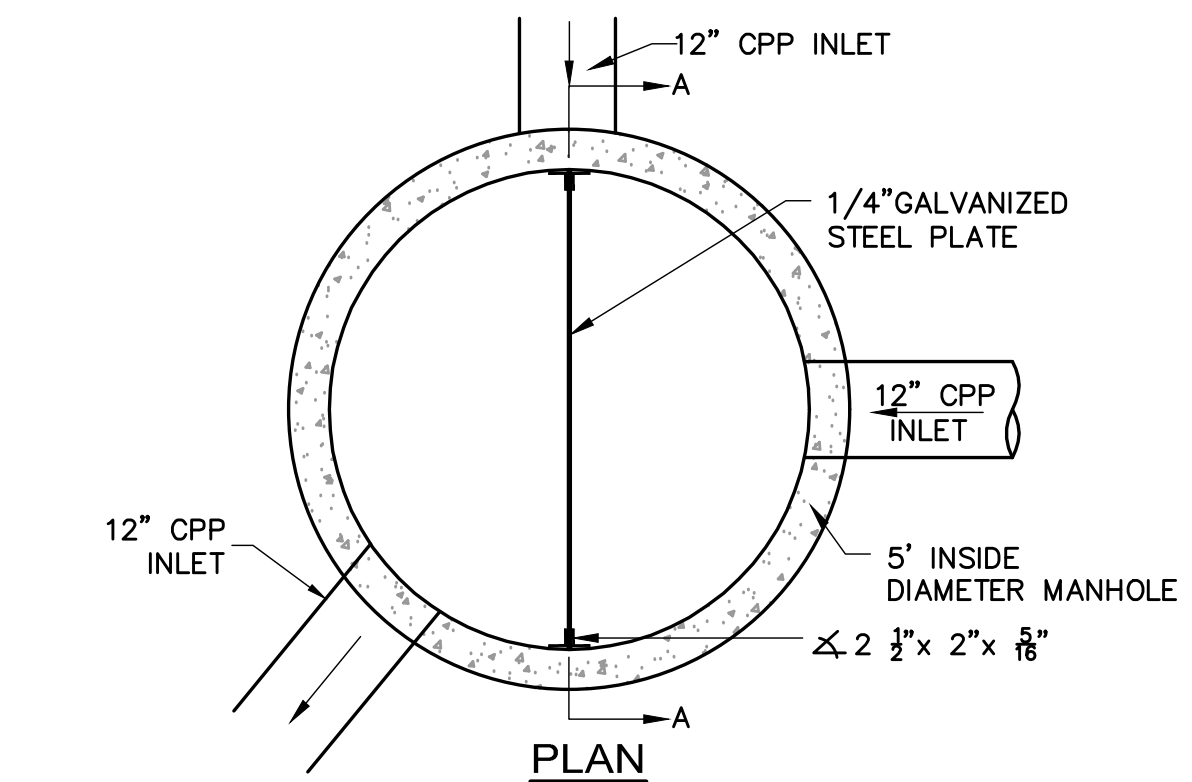


SECTION A-A

**OUTLET CONTROL STRUCTURE
OCS#402 (RAIN GARDEN #3)**
NOT TO SCALE

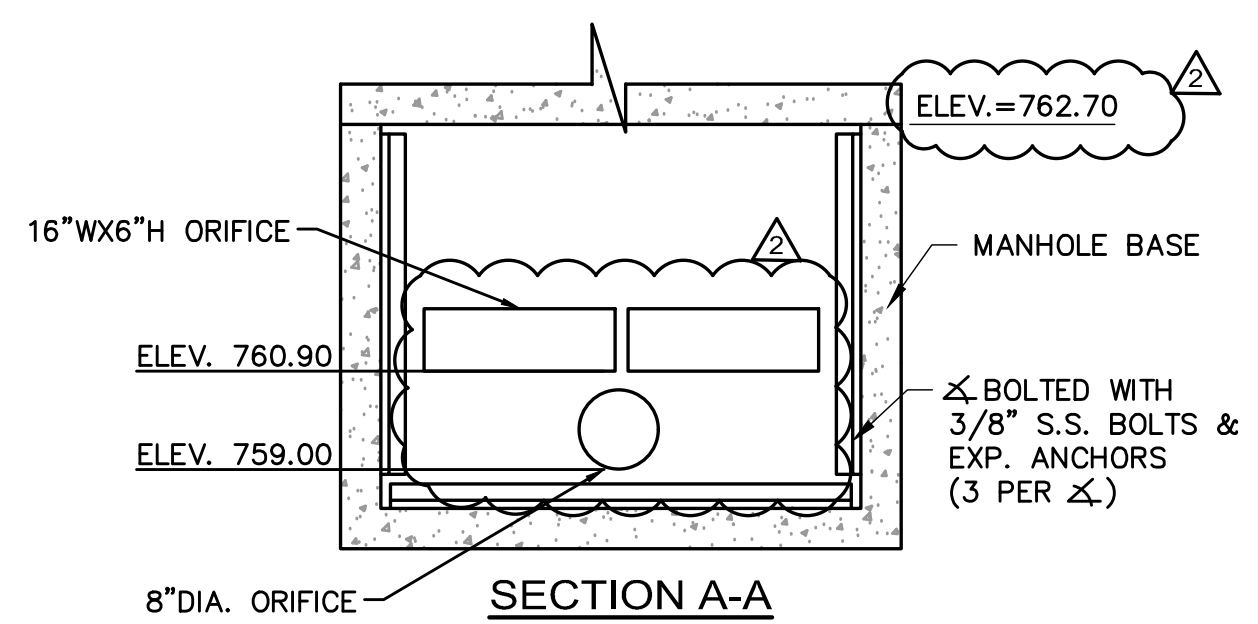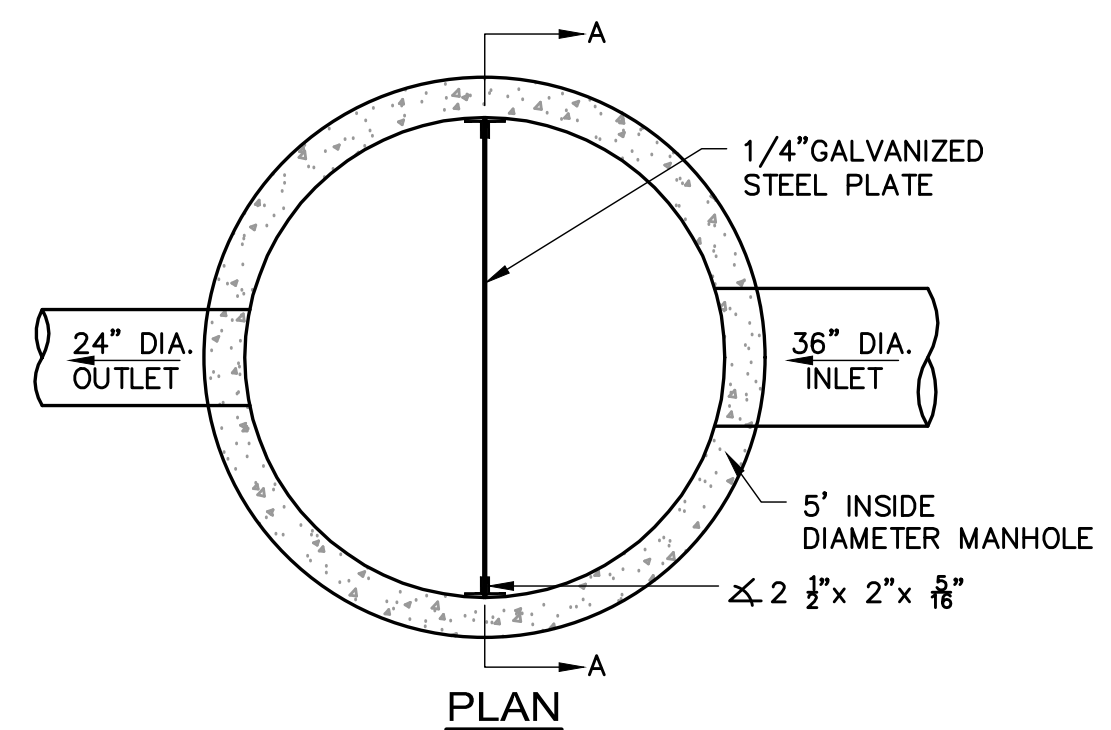


SECTION A-A


**OUTLET CONTROL STRUCTURE
OCS#403 (UNDERGROUND RECHARGE #1)**
NOT TO SCALE

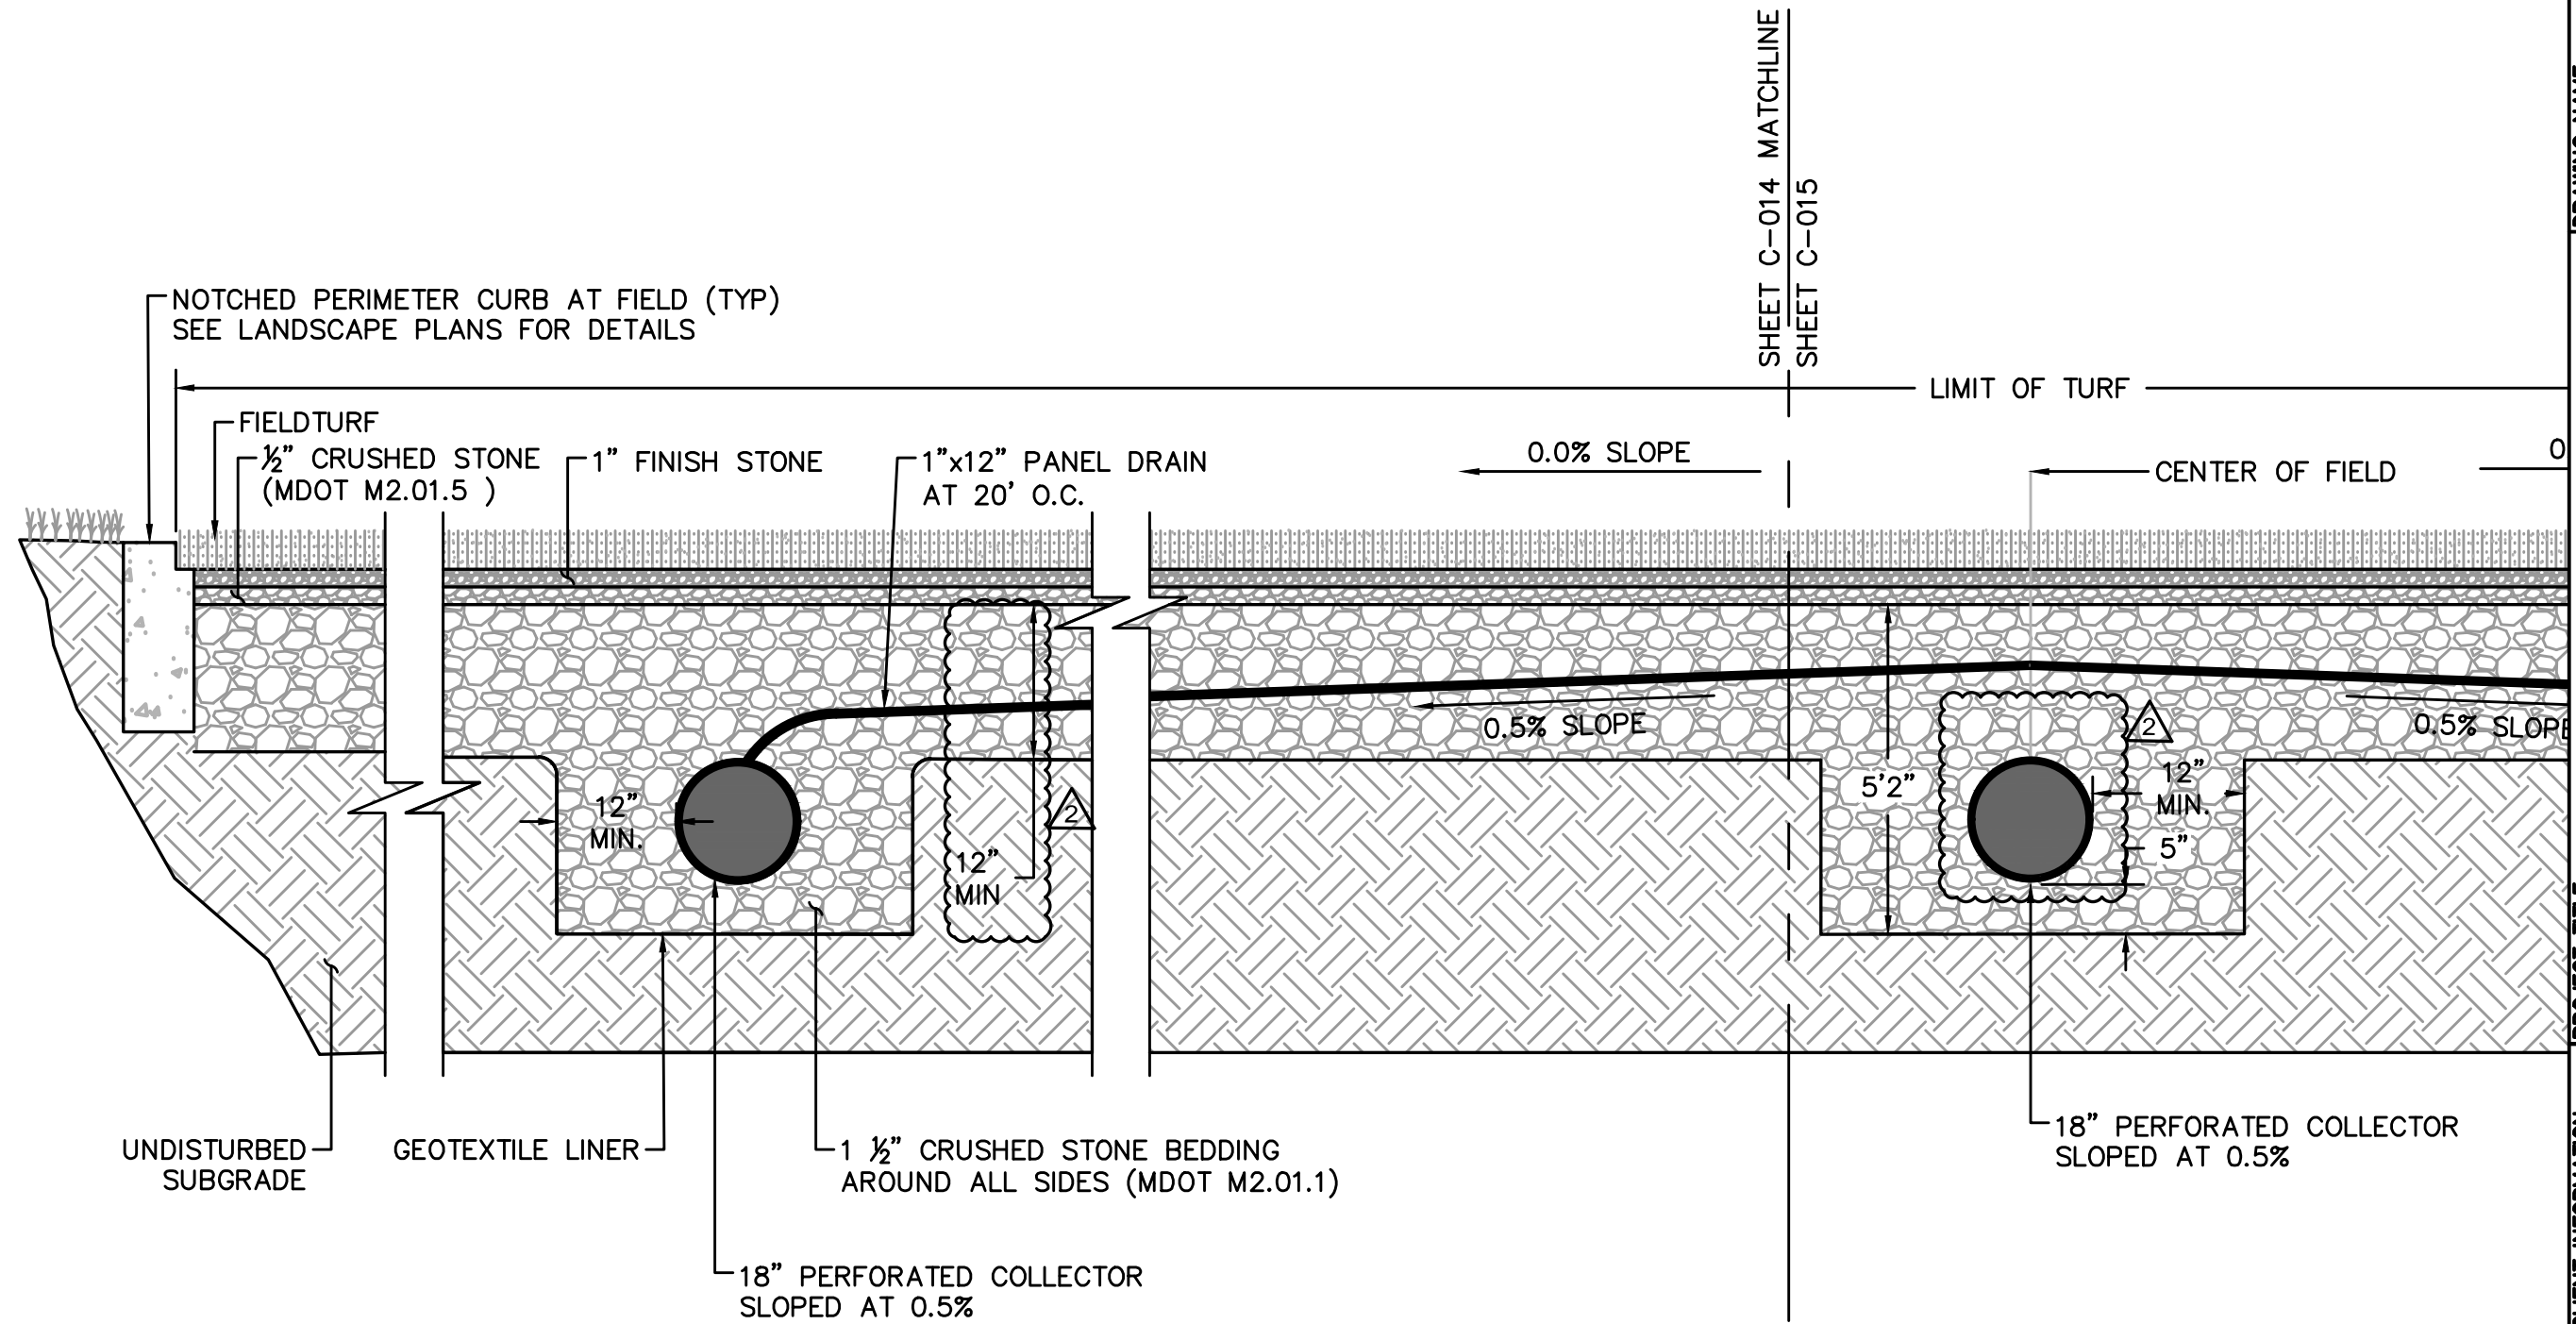

SYNTHETIC TURF FIELD SYSTEM DETAIL

NOT TO SCALE


DRAWING NAME: Civil Detail Sketch	SHEET REF. NO. C11.2
	DRAWING NUMBER: ADD-2 C-017
DATE: 09/11/18	SCALE: As Noted
PROJECT TITLE: EARLY SITE BID PACKAGE #2 South High Community School 170 Apricot Street, Worcester, MA 01603	
CLIENT INFORMATION: Worcester Public Schools  City of Worcester Massachusetts, 01605	 LAWRENCE, P. A. & ASSOCIATES PROFESSIONAL ENGINEERS 1000 WASHINGTON STREET WORCESTER, MA 01603

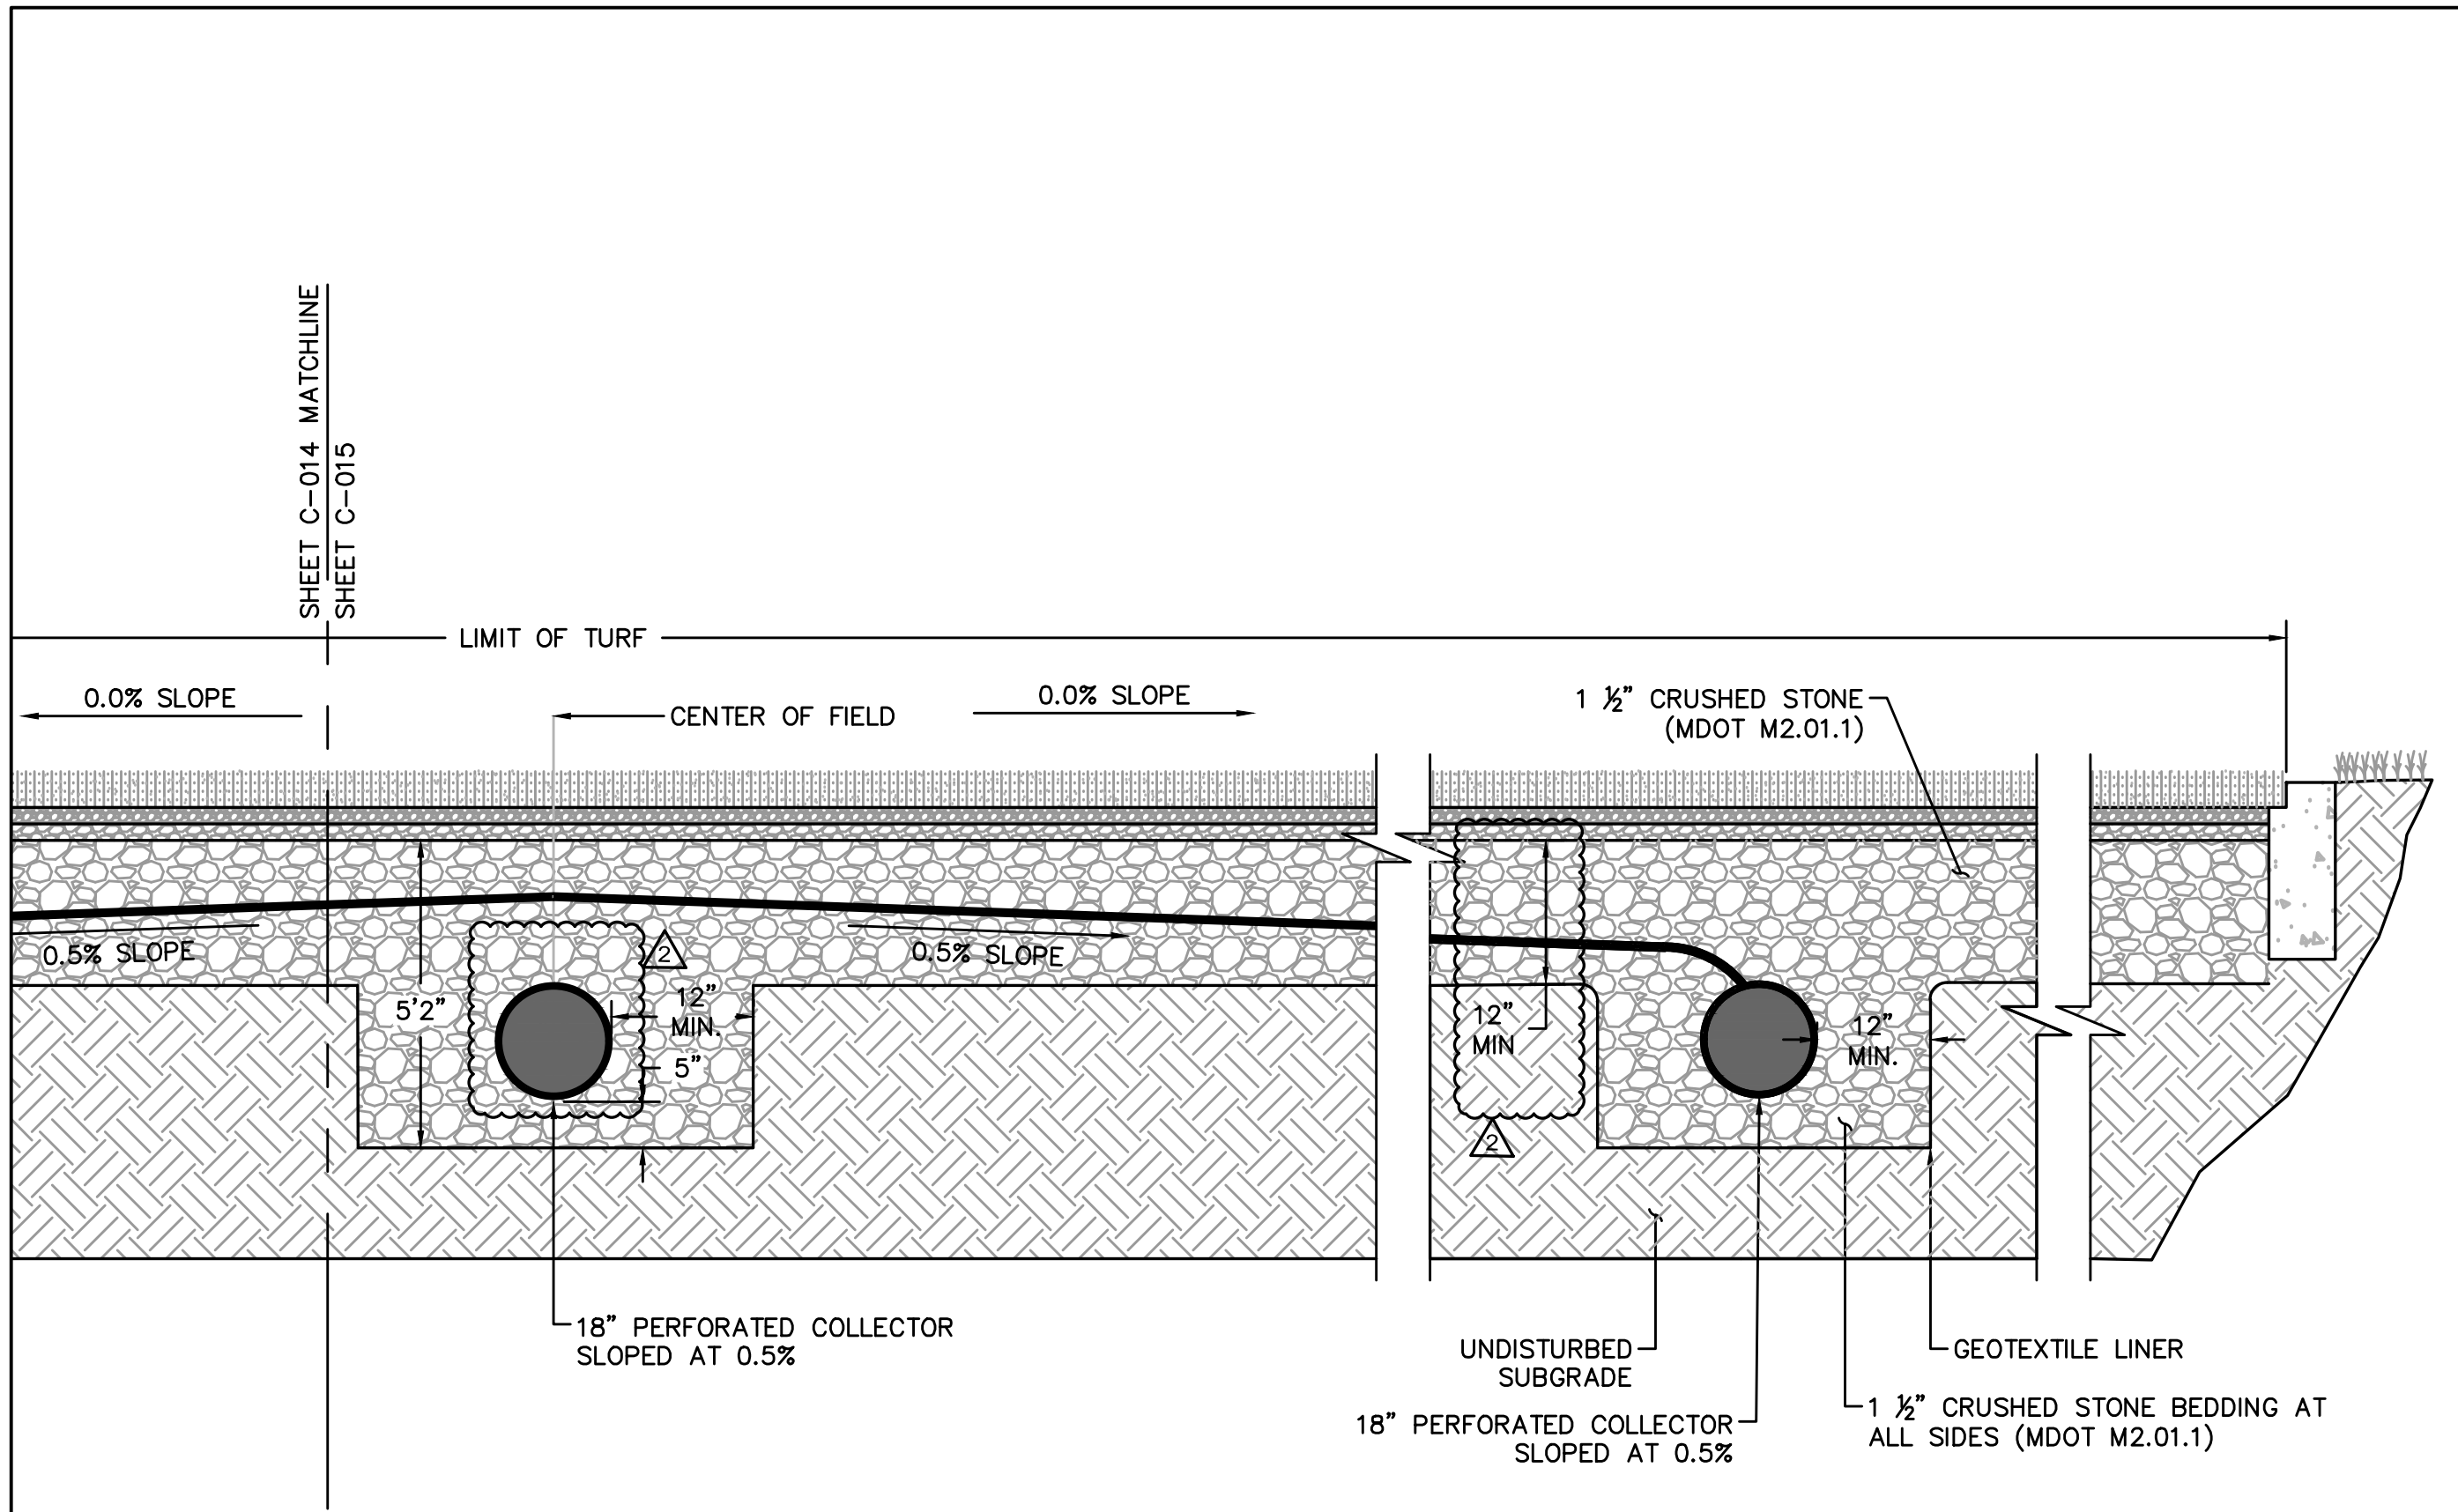




SYNTHETIC TURF FIELD SYSTEM DETAIL

NOT TO SCALE



SHEET C-014 MATCHLINE
SHEET C-015

CLIENT INFORMATION: Worcester Public Schools  City of Worcester Massachusetts, 01605	PROJECT TITLE: EARLY SITE BID PACKAGE #2 South High Community School 170 Apricot Street, Worcester, MA 01603	DRAWING NAME: Civil Detail Sketch	SHEET REF. NO.: C11.2
	DATE: 09/11/18	DRAWING NUMBER: ADD-2 C-018	SCALE: As Noted

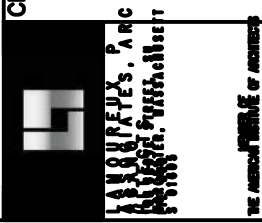

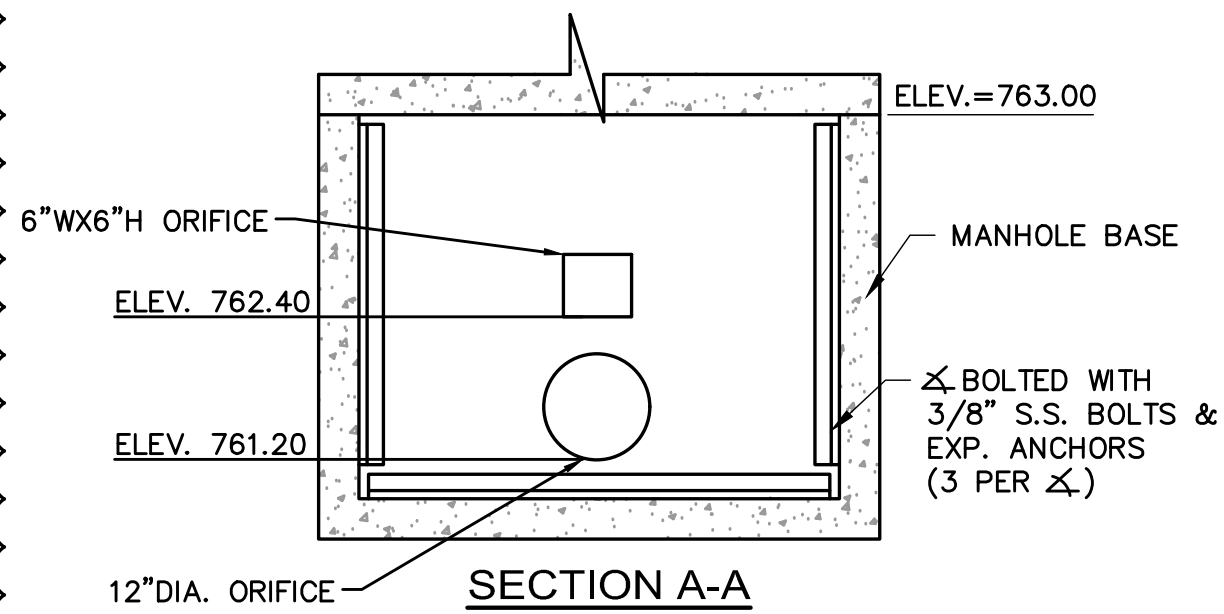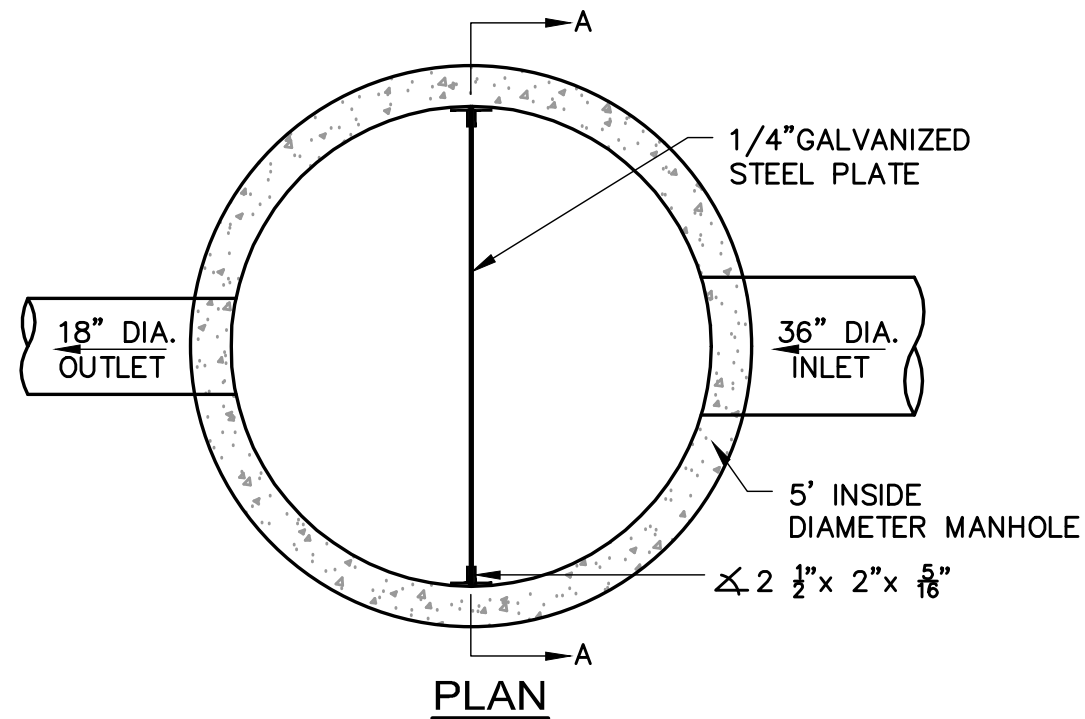

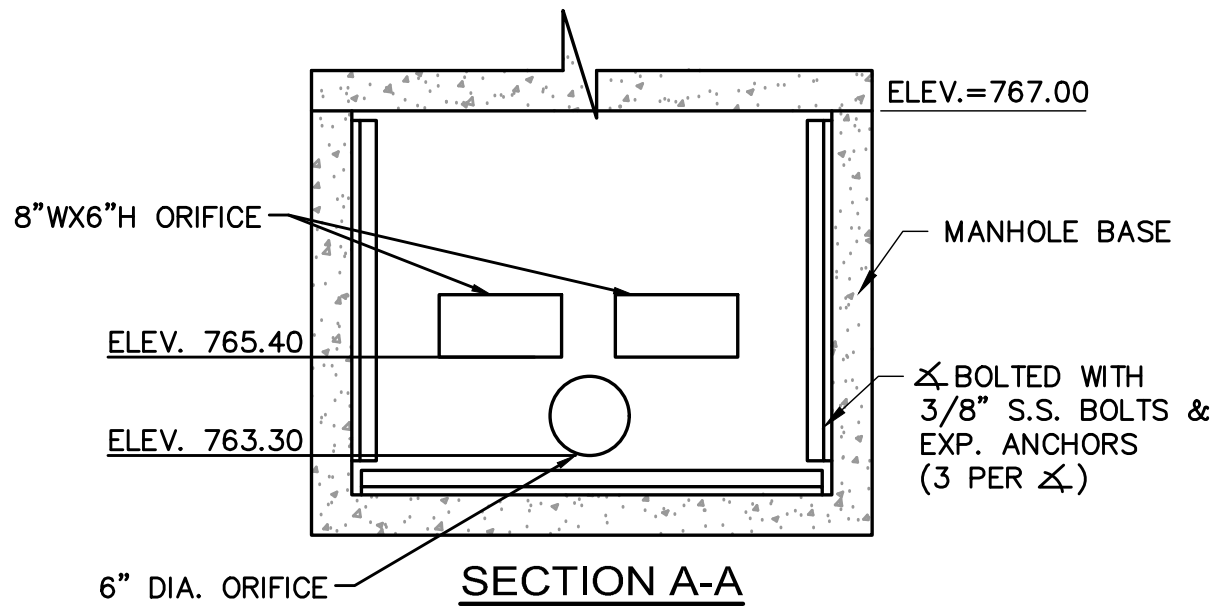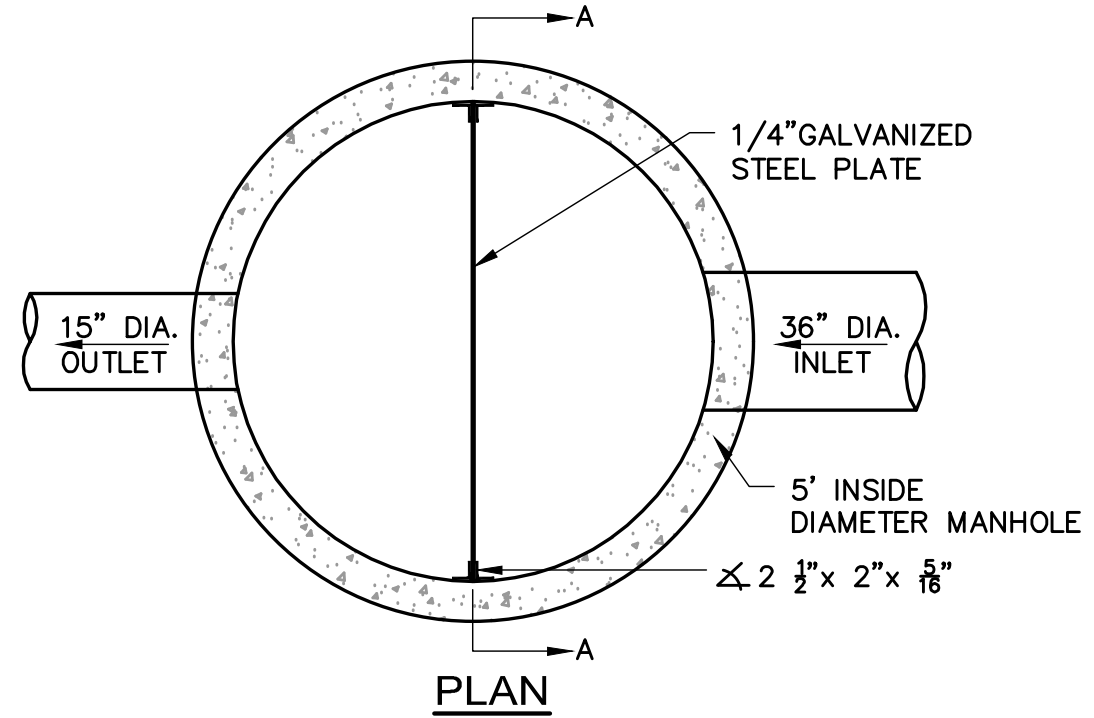


**OUTLET CONTROL STRUCTURE
OCS#404 (UNDERGROUND RECHARGE #3)**
NOT TO SCALE




**OUTLET CONTROL STRUCTURE
OCS#405 (UNDERGROUND RECHARGE #4)**
NOT TO SCALE

SHEET REF. NO. C11.2	DRAWING NUMBER: ADD-2 C-019
DATE: 09/11/18	SCALE: As Noted
PROJECT TITLE: EARLY SITE BID PACKAGE #2	
CLIENT INFORMATION: Worcester Public Schools	
 City of Worcester Worcester, MA 01603	
 LAMORTIUS PAGANO ASSOCIATES ARCHITECTS 108 COLE STREET, SUITE 400 WORCESTER, MASSACHUSETTS 01605	

1 Five (5) trees changed from AL to GT

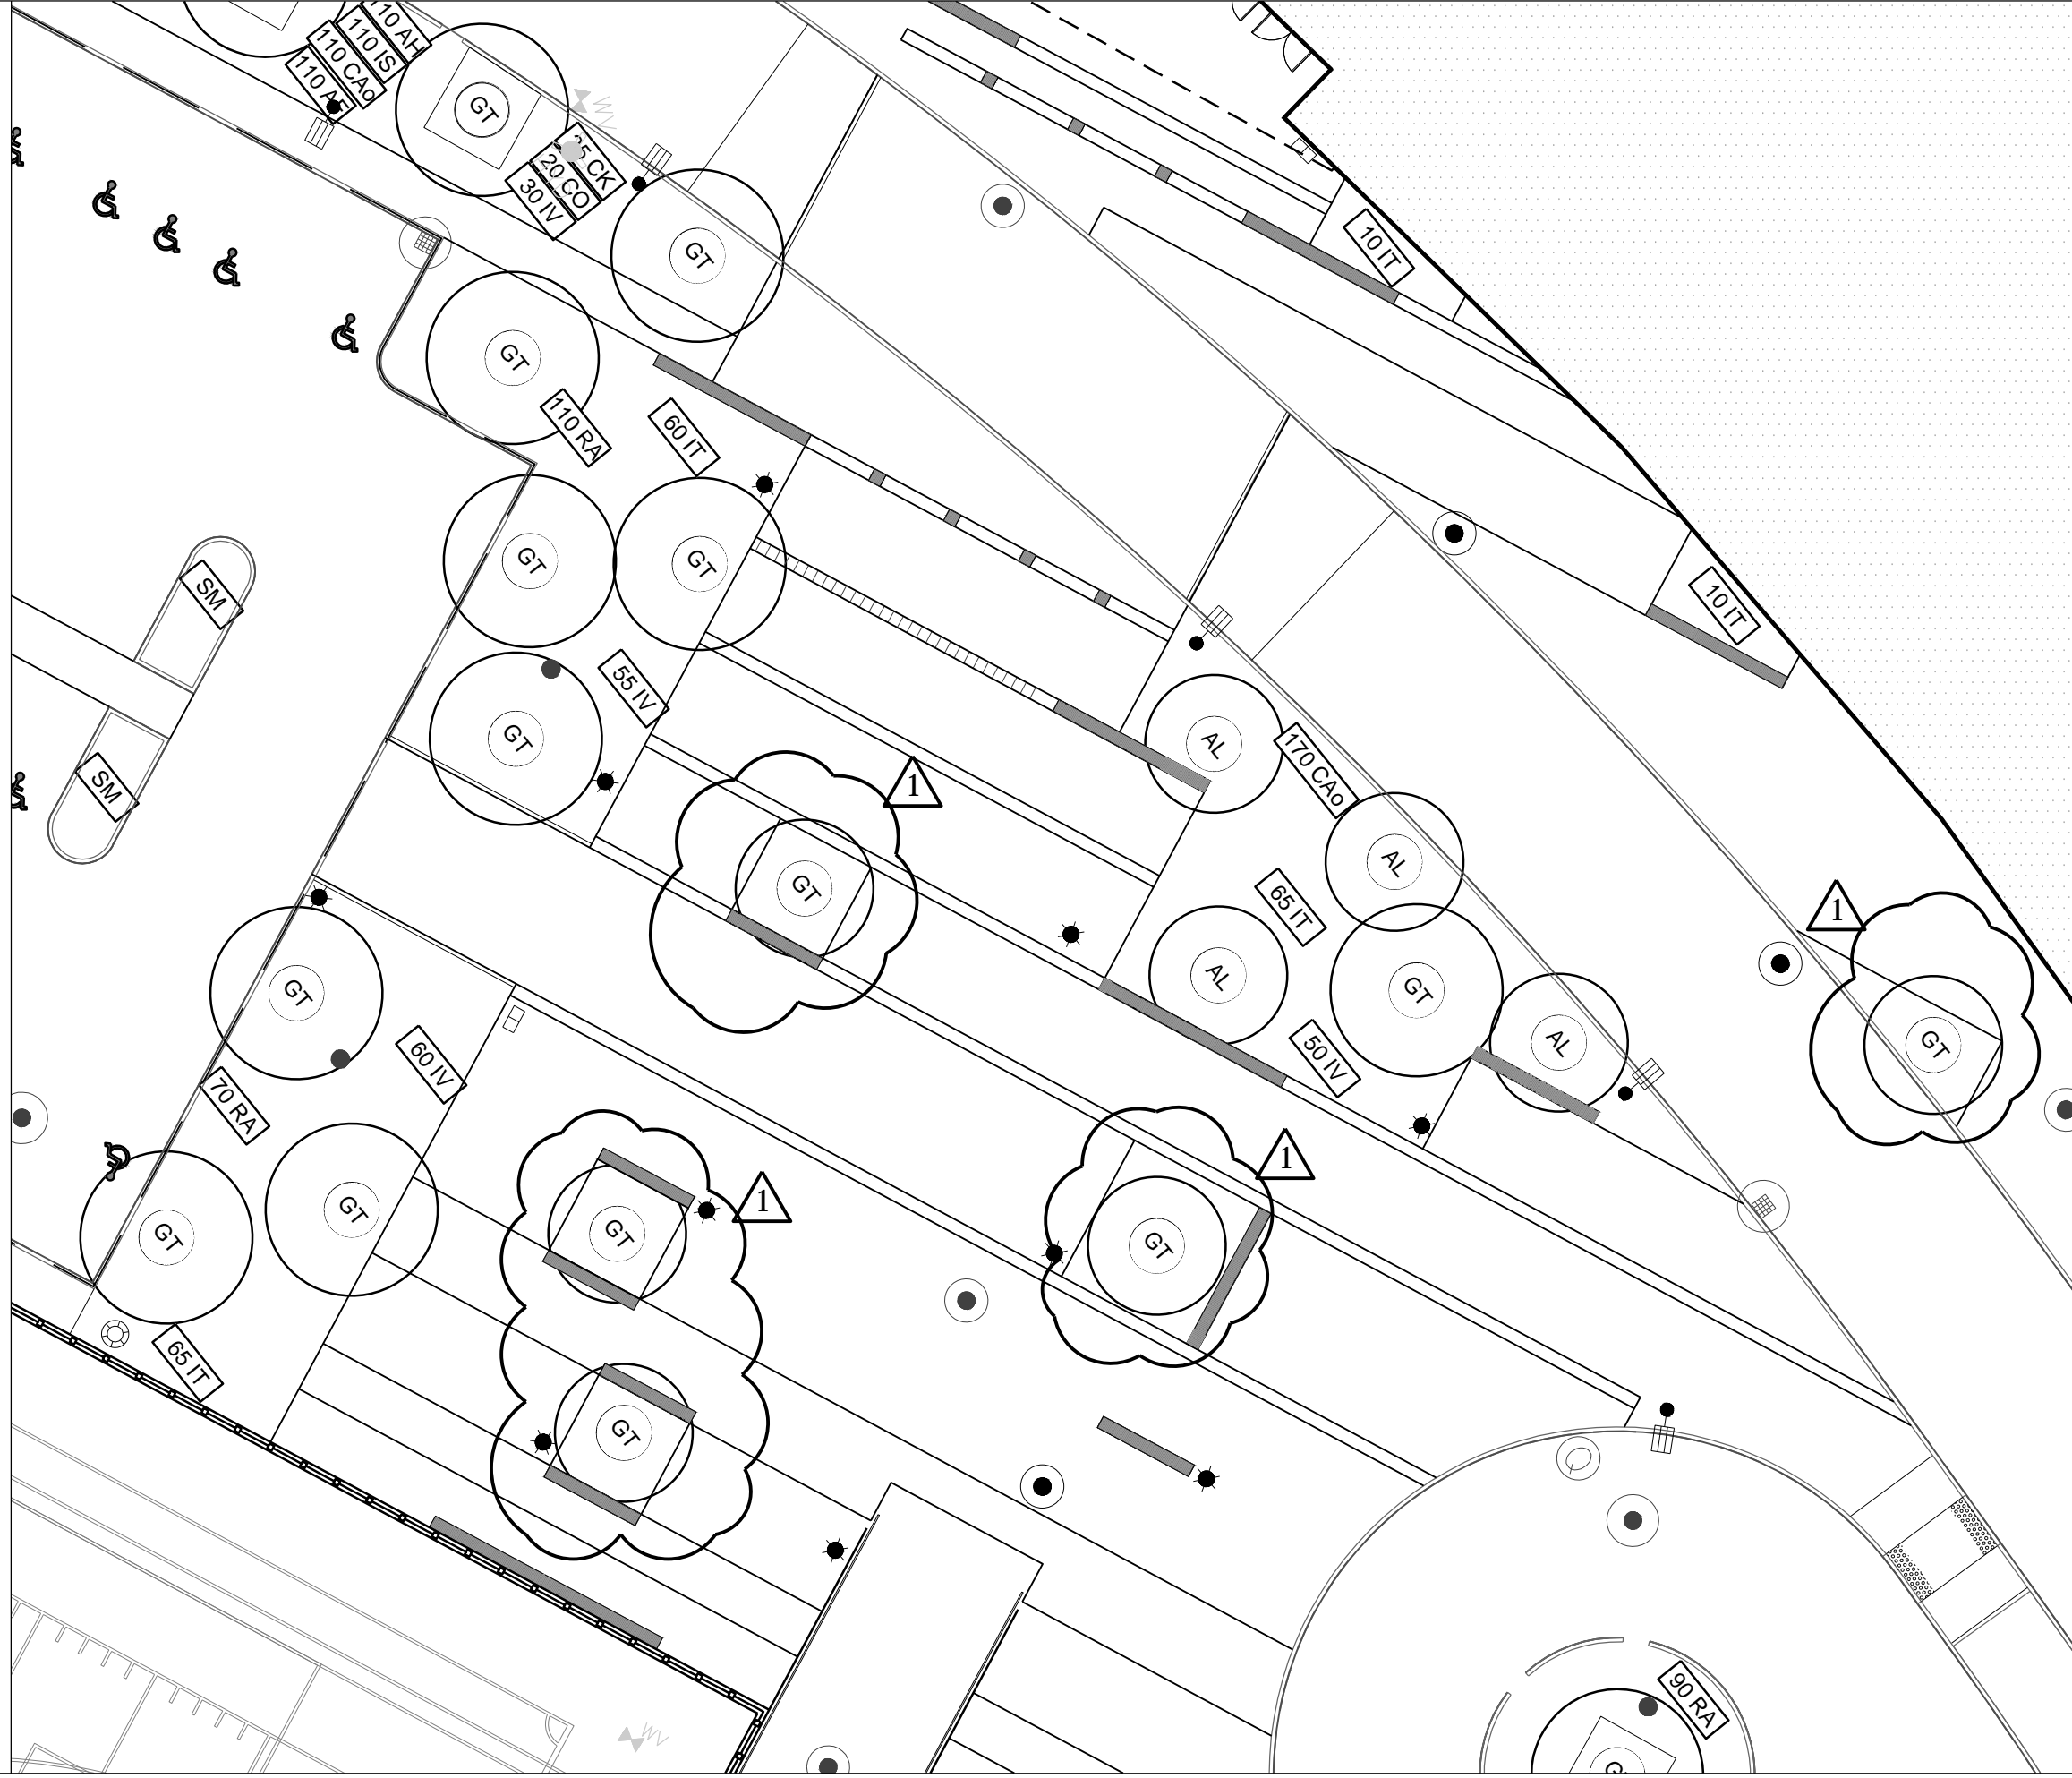


CLIENT INFORMATION: Worcester Public Schools  City of Worcester Worcester, Massachusetts, 01605	PROJECT TITLE: EARLY SITE BID PACKAGE #2 South High Community School 170 Apricot Street, Worcester, MA 01603	DRAWING NAME: Courtyard Trees	SHEET REF. NO.: L4.0, L4.1 L4.2
	DATE: September 10, 2018 SCALE: 1" = 20'-0"	DRAWING NUMBER: ADD-2 L-001	DRAWING NAME: Courtyard Trees


LAMORELUX PAGANO ASSOCIATES ARCHITECTS
 100 GROVE STREET, SUITE 200
 WORCESTER, MASSACHUSETTS 01603
 THE AMERICAN INSTITUTE OF ARCHITECTS



Clarification that five (5) sets of tennis equipment should be provided as specified.

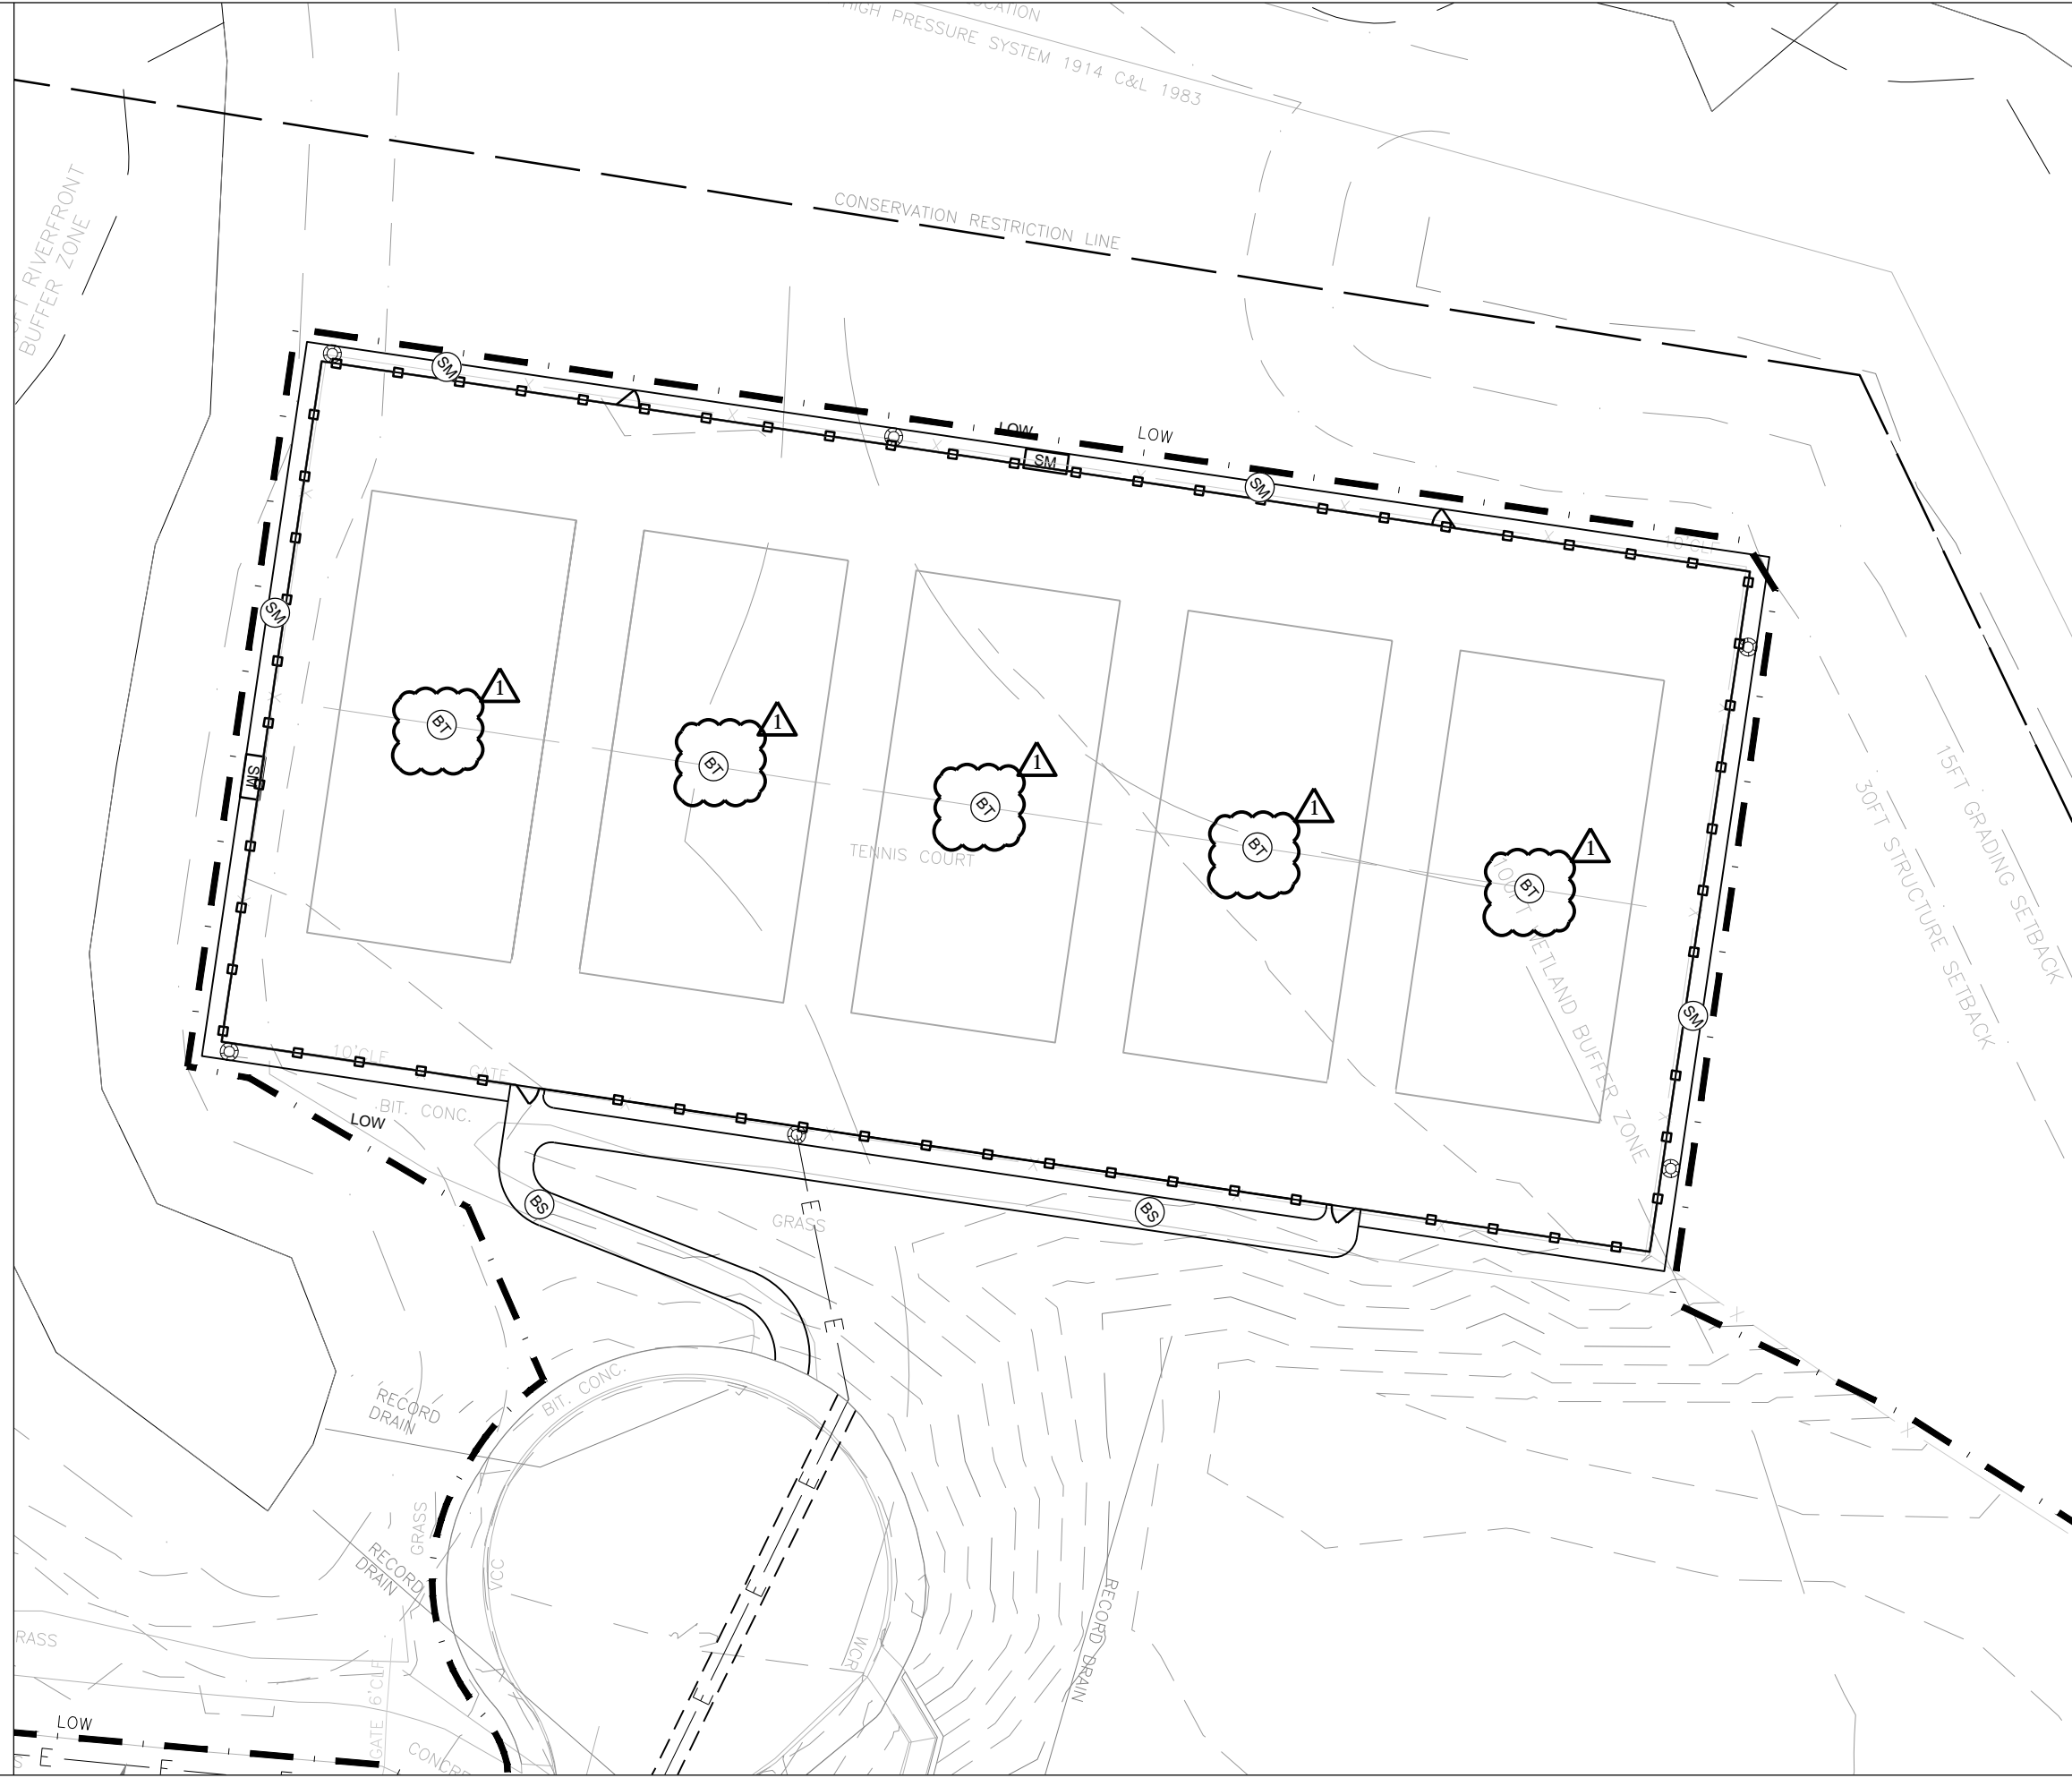

CLIENT INFORMATION:
Worcester Public Schools



City of Worcester
Massachusetts, 01605

PROJECT TITLE:

EARLY SITE BID PACKAGE #2

South High Community School

170 Apricot Street, Worcester, MA 01603

DRAWING NAME:

Tennis Equipment Callouts

DATE:
September 10, 2018

SCALE:
1" = 30'-0"

DRAWING NUMBER:

ADD-2

L-002

SHEET REF. NO.

L2.4



LAMORELUX PAGANO
ASSOCIATES ARCHITECTS
100 GROVE STREET, SUITE 200
WORCESTER, MASSACHUSETTS 01603

THE AMERICAN INSTITUTE OF ARCHITECTS

ADDENDUM No. 3 – September 19, 2018

GENERAL

This addendum modifies, amends, and supplements designated parts of the Contract Documents for the above project and is hereby made part thereof by reference and shall be as binding as though inserted in locations designated hereunder.

It shall be the responsibility of the bidders to notify all subcontractors and suppliers he proposes to use for the various parts of the work for any changes or modifications contained in this addendum. No claim for additional compensation because of lack of knowledge of the contents of this addendum will be considered.

As part of this Addendum #3, all bidders are hereby being notified that there is a bid package referred to as “Site Enabling Bid Package #1”. All Site Enabling Bid Package #1 documents (drawings and specifications, and addendum) will be made available to all bidders by the Construction Manager (Fontaine Bros / W.T. Rich).

SPECIFICATIONS

1. DOCUMENT 03 45 01 – PRECAST ARCHITECTURAL CONCRETE - SITEWORK

Page 1, 1.1, A

Insert at end: “4. Architectural precast concrete steps.
 5. Architectural precast concrete entrance sign.”

2. SECTION 31 20 00 – EARTH MOVING

Page 14, 1.16, C

Delete Item “C” in its entirety

Insert: “C. Refer to Construction Manager’s Scope of Work 31-3 Early Site Bid Package #2 Document for all unit costs.”

Page 14, 1.16, E

Delete: Item “E” in its entirety

Insert: “E. Refer to Construction Manager’s Scope of Work 31-3 Early Site Bid Package #2.”

Page 6, 1.16

Insert: “F. All ordinary site earthen excavations are unclassified, refer to Construction Manager’s Scope of Work 31-3 Early Site Bid Package #2.

All building excavation limits are to remove in its entirety; all fill materials placed as part of the original school’s earthwork operations. Reference the published soils borings and test pits that indicate the strata change between fill and original soils for vertical excavation limits.

Horizontal limits shall extend beyond the proposed building footprint a distance equal to the distance between the bottom of the proposed footings and the natural soil or 5 feet, whichever is greater.

Building excavation limits at the soldier pile retaining shall be to the inside face of the retaining and further defined in the Construction Manager's Scope of Work 31-3 Early Site Bid Package #2.

All fill within the building from the above noted excavations to the bottom of interior slab crushed stone base or as defined in the documents shall be structural fill."

Page 21, 2.1

Insert at end: "K. ½ inch Crushed Stone: ½ inch crushed stone shall meet the requirements of MassDOT M2.01.5. It shall consist of durable crushed rock or crushed gravel stone, free of ice, snow, sand, silt, clay, loam, shale, or other deleterious or organic matter. It shall be graded within the following limits:

<u>U. S. Standard Sieve Size</u>	<u>Percent Finer by Weight</u>
5/8 inch	100
½ inch	85-100
3/8 inch	15-45
No. 4	0-15
No. 8	0-5"

Page 38, 3.16

Insert at end: "I. Refer to the Document from Lord Associates dated 02/12/2018 published as Appendix D regarding the reuse of existing earthen material and required cover at areas. These requirements are limited to areas of increased exposure, and are defined as all areas inside of the interior curb around the building and sports field. Areas outside this ring the existing excavated materials can be used as backfill, subject to meeting grading and other requirements specified herein."

3. SECTION 32 80 00 – IRRIGATION SYSTEM

Page 4, 1.6

Insert: "C. Extended Maintenance Agreement: The Contractor shall provide an extended maintenance agreement to include all manufacturer-recommended services and maintenance related to annual fall winterization and spring startup of the irrigation system. The extended maintenance agreement shall extend for a period of three (3) years from the date of substantial completion and shall include all labor and materials required to perform the required maintenance service."

Page 9, 2.13, C

Delete in its entirety

Replace with: "C. Controller unit will be located in the boiler room adjacent to BFP. Refer to plumbing drawings. Type of mounting will be selected by the Architect."

DRAWINGS

1. ADDENDUM NO. 2

- A. Delete sketch ADD-2/C-003; replace with ADD-3/C-003
- B. Delete sketch ADD-2/C-004; replace with ADD-3/C-004
- C. Delete sketch ADD-2/C-017; replace with ADD-3/C-017
- D. Delete sketch ADD-2/C-018; replace with ADD-3/C-018

2. DRAWING C3.3 – Site Demolition Plan

- A. Refer to sketch ADD-3/C-028

3. DRAWING C5.3 – Roadway Layout and Materials Plan

- A. Refer to sketch ADD-3/C-027

4. DRAWING C7.0 and C7.1

- A. Refer to sketch ADD-3/C-030

5. DRAWING C8.1 – Site Utility Plan

- A. Refer to sketch ADD-3/C-031

6. DRAWING C8.3 – Site Utility Plan

- B. Refer to sketch ADD-3/C-026

7. DRAWING C9.2 – Site Drainage Plan

- A. Refer to sketch ADD-3/C-029

8. DRAWING C11.1 and C11.2

- A. Refer to sketch ADD-3/C-020

9. DRAWING C11.3 – Civil Details

- A. Refer to sketch ADD-3/C-021

10. DRAWING C11.3 – Civil Details

- A. Refer to sketch ADD-3/C-022

11. DRAWING C11.4 – Civil Details

- A. Refer to sketch ADD-3/C-023
- B. GREASE TRAP- Add Note: "All piping complete from building to the grease trap tank, all piping on the interior of the grease trap, including the interior baffle and to 10 feet from the outfall shall be by the PSC. The vent back from the tank to the building in its entirety is by the PSC. Coordinate the inverts and cast in place boots as part of the tank submittal."
- C. OIL/GAS SEPARATOR DETAIL- Add Note: "All piping complete from building to the oil/gas separator trap tank, all piping on the interior of the trap, and to 10 feet from the outfall shall be by the PSC. The vents back from the tank to the building in its entirety are by the PSC. Coordinate the inverts and cast in place boots as part of the tank submittal. Add minimum 3 courses of red sewer brick with cement parging from the precast tank top to grade."

12. DRAWING C11.5 – Civil Details

- A. Refer to sketch ADD-3/C-024
- B. Refer to sketch ADD-3/C-032

13. DRAWING C11.6 – Civil Details

- A. Refer to sketch ADD-3/C-025

14. DRAWING L2.3, L2.4, L3.3, and L3.4

- A. Refer to sketch ADD-3/L-003

15. DRAWING L2.9 – Irrigation Area

- A. Refer to sketch ADD-3/L-005

16 .DRAWING L5.6 – Bleacher and Field Details

- A. Refer to sketch ADD-3/L-004

ATTACHMENTS

DOCUMENTS:

1. Site Enabling Bid Package #1- Addendum #1, dated May 1, 2018
2. Field Observation Report No. 001 by Lahlaf Geotechnical Consulting, Inc., dated 7/11/18

SKETCHES:

CIVIL

1. ADD-3/C-003 Site Utility Plan Sketch
2. ADD-3/C-004 Site Utility Plan Sketch
3. ADD-3/C-017 Civil Detail Sketch
4. ADD-3/C-018 Civil Detail Sketch
5. ADD-3/C-020 Civil Detail Sketch
6. ADD-3/C-021 Civil Detail Sketch
7. ADD-3/C-022 Civil Detail Sketch
8. ADD-3/C-023 Civil Detail Sketch
9. ADD-3/C-024 Civil Detail Sketch
10. ADD-3/C-025 Civil Detail Sketch
11. ADD-3/C-026 Site Utility Plan Sketch
12. ADD-3/C-027 Roadway Layout and Materials Plan Sketch
13. ADD-3/C-028 Site Demolition Plan Sketch
14. ADD-3/C-029 Site Drainage Plan Sketch
15. ADD-3/C-030 Civil Grading Plan Sketch
16. ADD-3/C-031 Site Utility Plan Sketch
17. ADD-3/C-032 Civil Detail Sketch

LANDSCAPE

1. ADD-3/L-003 Courtyard Trees
2. ADD-3/L-004 Artificial Field Turf Detail
3. ADD-3/L-005 Irrigation Control Box Location

END OF ADDENDUM #3

S E-ADDENDUM No. 1 – May 1, 2018

GENERAL

This addendum modifies, amends, and supplements designated parts of the Contract Documents for the above project and is hereby made part thereof by reference and shall be as binding as though inserted in locations designated hereunder.

It shall be the responsibility of the bidders to notify all subcontractors and suppliers he proposes to use for the various parts of the work for any changes or modifications contained in this addendum. No claim for additional compensation because of lack of knowledge of the contents of this addendum will be considered.

PART 1 GENERAL

1. None

PART 2 SPECIFICATIONS

1. None

PART 3 DRAWINGS

1. Drawing EC3.0 Erosion and Sediment Control Plan has been revised based on Conservation Commission review comments, refer to the attached revised drawing.

PART 4 CM QUESTIONS AND RESPONSES

QUESTION # 1

A fencing sub would like to confirm that there are two rows of fencing along certain areas of the job. Referencing Sheet EC3.0, there appears to be a construction fence depicted with the erosion control barrier (ECB line type), around the perimeter of the site. However, there also appears to be other areas where additional fencing is called out, directly adjacent to the ECB. Could you try to clarify?

RESPONSE: Refer to the attached drawing EC3.0, revised as part of this Addendum.

QUESTION # 2

Please confirm what the limits are of the "Construction Access Road"? There are two details for asphalt paving, but only one shade on the L&M plan.

RESPONSE: All areas should be paved per the "Construction Access Road Hot Mix Asphalt Paving Detail" on EC-7.1.

QUESTION # 3

The retaining wall fencing that it will be permanent is called out, but the only details on the plans show construction fencing. Would this retaining wall fence be different in type and height?

RESPONSE: That fence will be 4 ft chain link and the details for it are in spec section 32 31 13. Details for the fence are also provided on EC7.1 in detail titled "Fence Connection Locations."

QUESTION # 4

Is sheet EP1 "Electrical Temporary Lighting Plan" part of the site work scope for the site enabling bid? If so, please provide a spec for the temporary lighting. If not, will the site contractor be responsible to provide assistance to the electrical subcontractor i.e. excavate and backfill trenches and installing bases?

RESPONSE: The actual electrical work will not be by the site contractor but they will be providing assistance as noted. There is also a request in the scope to provide a unit price for temp light poles.

QUESTION # 5

Bid Alternate #2 in the subcontractor scope of work states "remove and salvage existing lighting." The site demolition plan shows to maintain and protect existing lighting. Please clarify.

RESPONSE: Alternate two is for the small parking area at the Sullivan school and the note only applies to the poles in that area (2 total). Poles that are currently operating will be protected and the poles that are inoperable will be removed and disposed of

QUESTION # 6

There are three different details depicting construction fence on the plans (EC7.0); Chain Link Construction Fence, Temporary Chain Link Construction Fence With Ballast Bases, and Perimeter Erosion Control Barrier-Super Silt Fence. All three have differing heights and construction parameters (top rail/tension wire). Could you please confirm the following regarding the fencing:

- Unless noted differently, all temp construction fencing should be 6' in height.
- Top and center rails are only required on the ballasted fencing; tension wires on all other types.
- Temporary fence shall conform to spec section 015000.2.1A.

RESPONSE: Yes, confirmed.

PART 5 ATTACHMENTS

DOCUMENTS:

None


SKETCHES:

None

DRAWINGS:

EC3.0 Erosion and Sediment Control Plan

END OF ADDENDUM #1

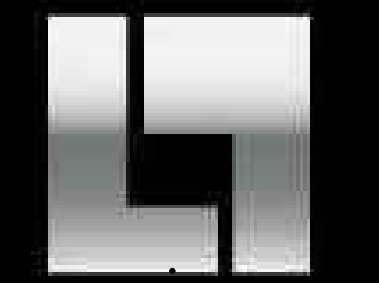

LAMOUREUX PAGANO
ASSOCIATES, ARCHITECTS
108 GROVE STREET, SUITE 300
WORCESTER, MASSACHUSETTS 01605

MEMBER OF
THE AMERICAN INSTITUTE OF ARCHITECTS
CONSULTANT




Nisich Engineering
100 West Street, Suite 818
Worcester, MA 01605
F: 508-855-1234
E: info@nisich.com

OWNER

Worcester Public
Schools



Worcester, MA

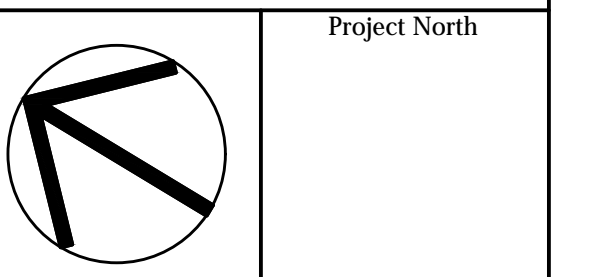

PROJECT

SITE ENABLING BID
PACKAGE #1


South High
Community School

170 Apricot Street, Worcester, MA 01603

TITLE

**EROSION AND
SEDIMENT
CONTROL PLAN**

Key Plan

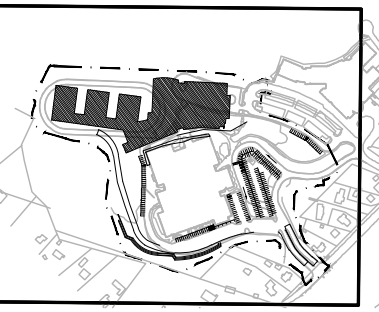

REVISIONS

No.	Description	Date
1	Addendum #1	5/3/2018

FILE: 11677ec-enabing


DWN. BY: ER JOB NO: #1611

CKD. BY: JEC SCALE: 1"=40'


DATE: April 12, 2018

EC3.0

Nisich Project #11677

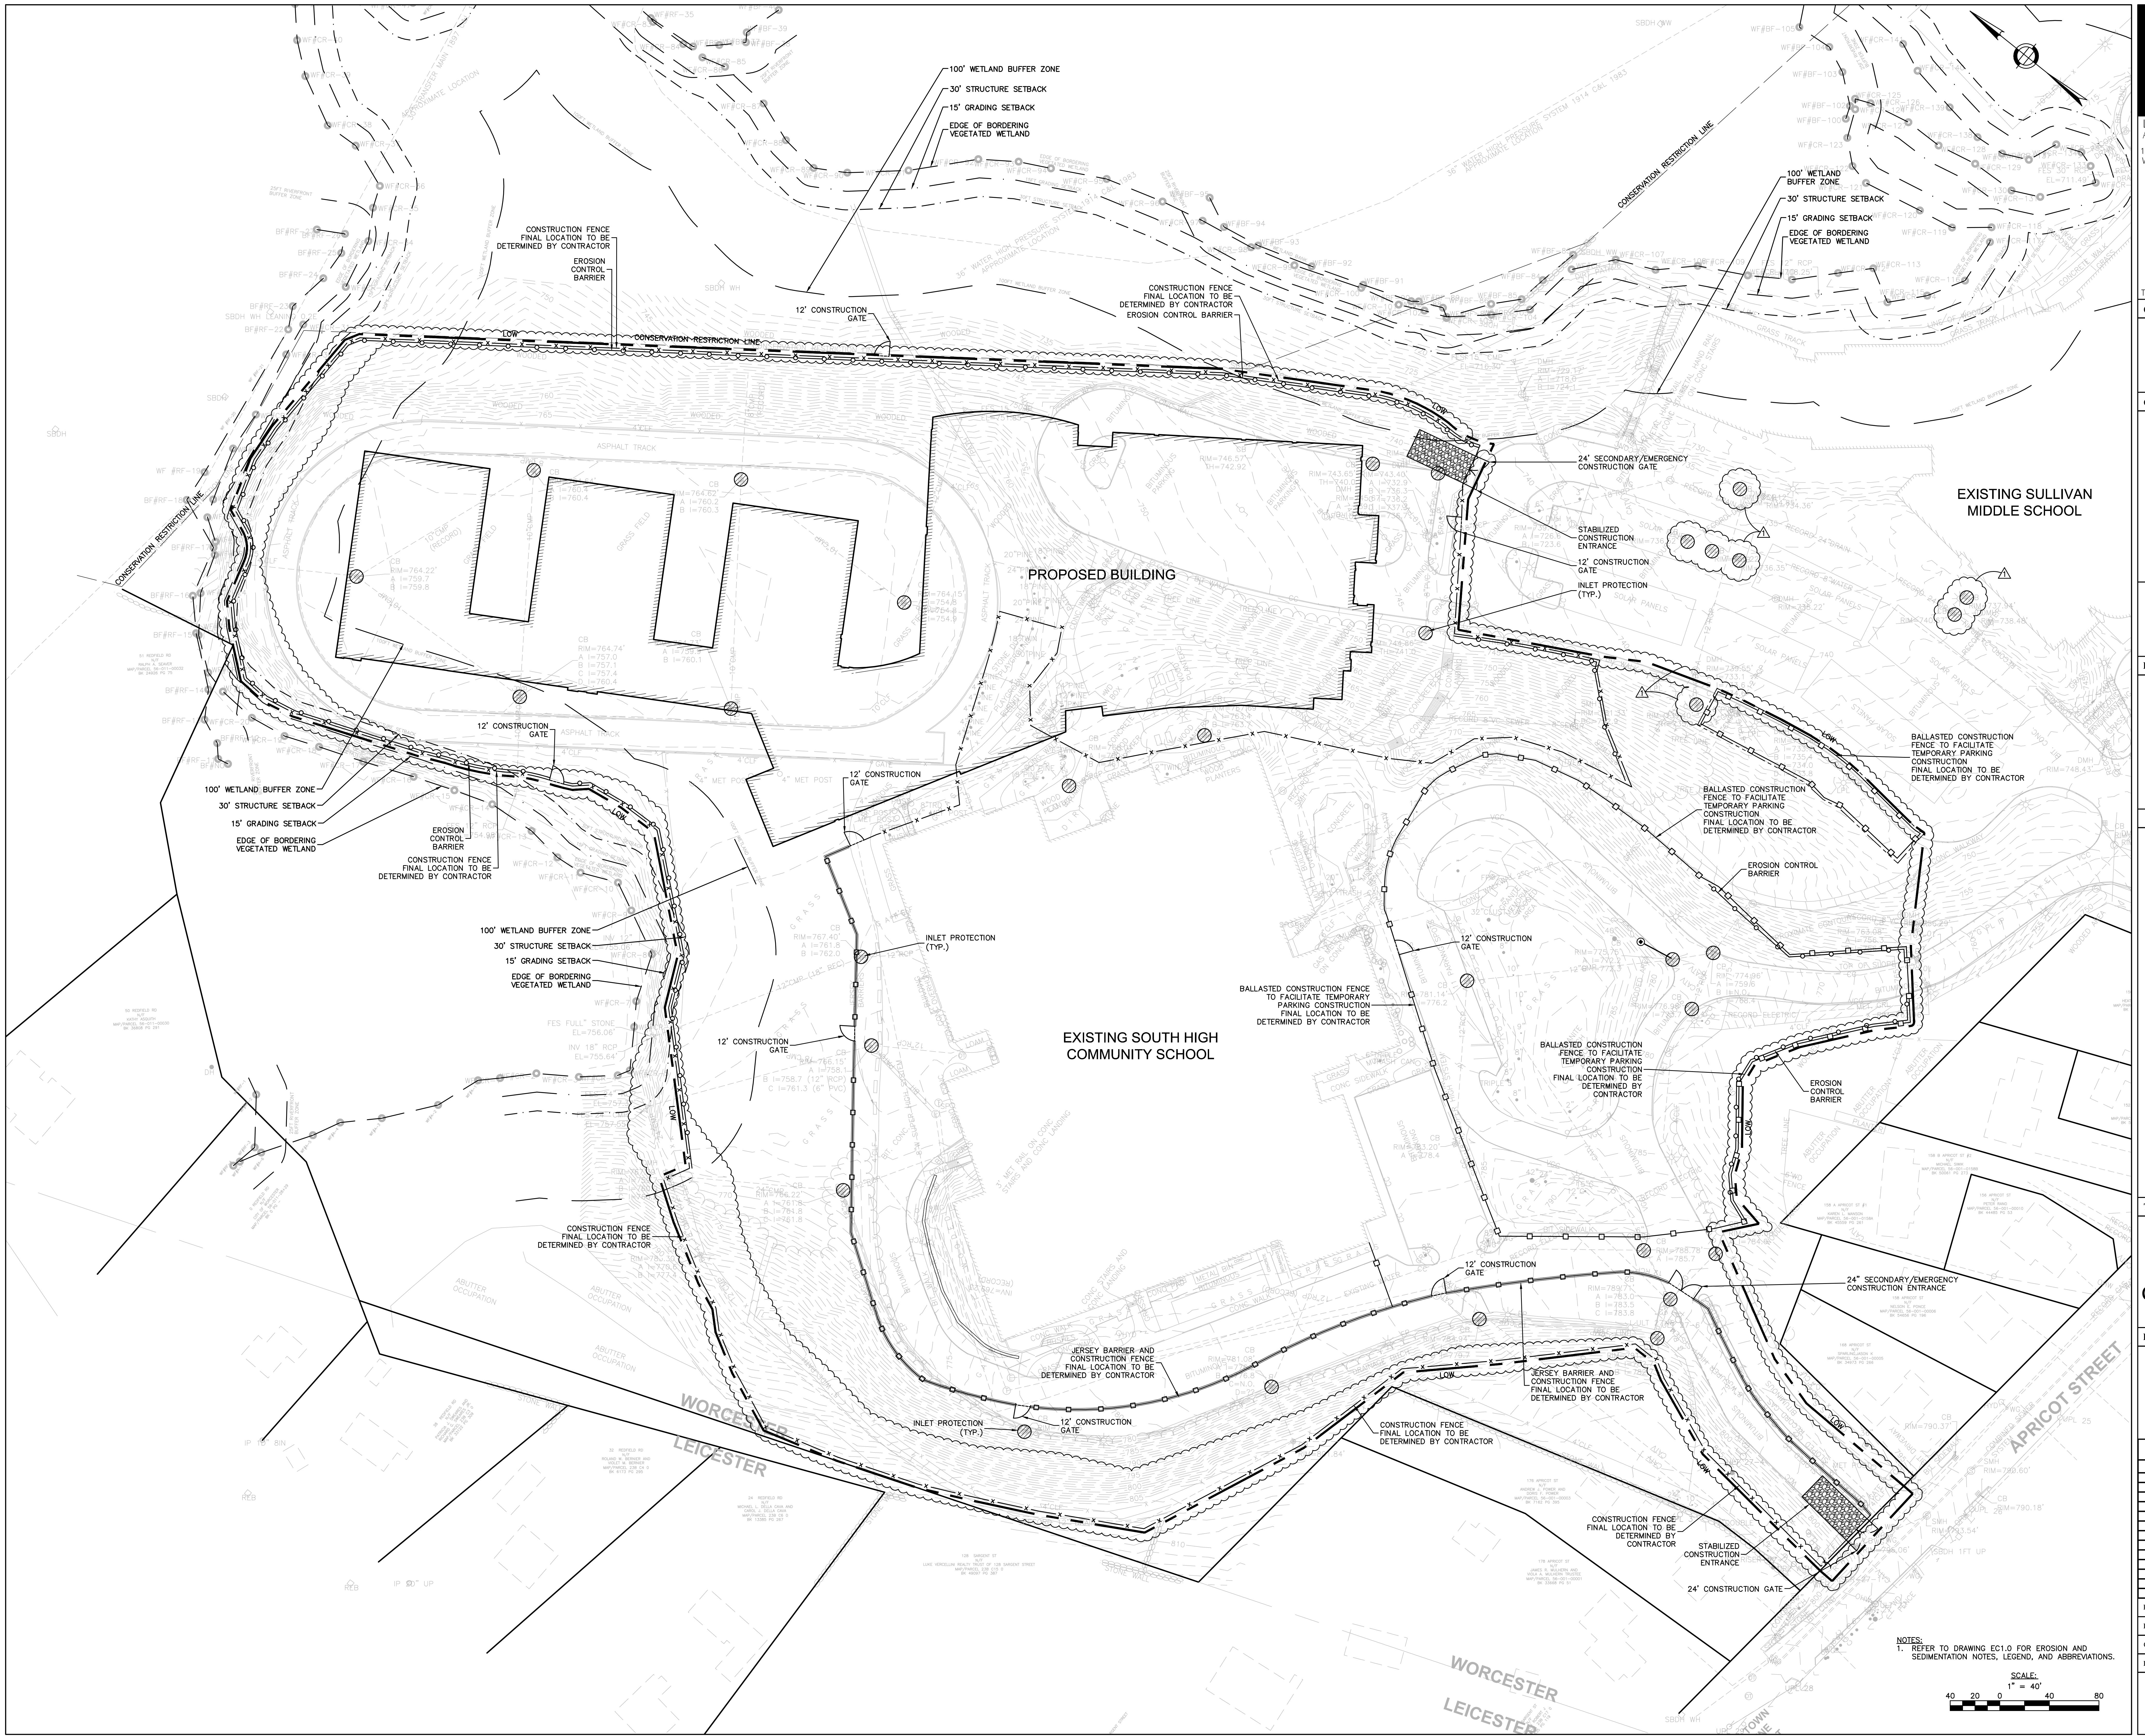

NOTES:
1. REFER TO DRAWING EC1.0 FOR EROSION AND SEDIMENTATION NOTES, LEGEND, AND ABBREVIATIONS.

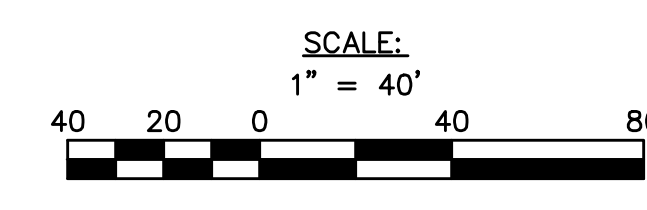

Client: Lamoureux Pagano & Associates, Inc.	Location: Worcester, MA
Project Name: Proposed Worcester South High School	Contractor: Fontaine Bros., Inc.
LGCI Project Number: 1644	Owner: City of Worcester
Date: 7/11/2018	Weather: 90's /Sunny
LGCI Representative: Abdelmajid M. Lahlaf	Present at the site: Leo Parker – Lamoureux Pagano Associates (LPA) David Fontaine / Fontaine Bros., Inc. (Fontaine) Stephen Sanderson / Fontaine Bros., Inc. (Fontaine) James Blume / Fontaine Bros., Inc. (Fontaine) Mark Lydon / Heery Project Management (OPM) Marwan Abi Elias / Heery Project Management (OPM) Amy Chagnon / T & M Equipment Corp. (site contractor) Joe Rosati / T & M Equipment Corp. (site contractor) Fran Dean / T & M Equipment Corp. (site contractor)
Field Contact: Marwan Abi Elias (OPM)	
Arrived at: 9:00 AM	Field Time Including Travel: 4.8 hours
	Mileage: 120 miles

Purpose - The purpose for today's site visit is to observe test pits at the site to further explore the depth and extent of the existing fill. The test pits were excavated in the presence of representatives of LPA, Fontaine, Heery, and T & M.

Field Observations -

1. Five (5) test pits (TP-201 to TP-205) were excavated near the proposed building footprint as follow:

TP-201 near TP-7:

The excavation was advanced through a layer of 1.5 to 3.0 feet of fill overlying the natural silty sand with gravel which is consistent with TP-7 and with the site topography.

TP-202 near TP-6:

The excavation was advanced through a layer of 2 feet of top soil and fill on the western side and 3 feet of topsoil and fill on the eastern side overlying the natural silty sand, which is consistent with TP-7 and with the site topography.

TP-203 about 20 feet east of TP-111:

The excavation was advanced through a layer of 4.0 feet of fill overlying a layer of 1 foot of buried topsoil, overlying a layer of 5 feet of fill, i.e., about 10 feet of fill over the natural silty sand which is consistent with TP-111 and with the site topography.

TP-204 north of was TP-101-IT:

The excavation advanced through a layer of 6.0 feet of fill overlying a layer of 1 foot of buried topsoil, i.e., about 7 feet of fill overlying the natural silty sand which is consistent with TP-111 and site topography.

TP-205 west of TP-113:

The excavation advanced through a layer of 9.5 feet of organic fill over the natural sand which is consistent with TP-113 and site topography.

The test pits generally indicated subsurface conditions that were consistent with those described in our Geotechnical Report dated April 9, 2018.

Submitted to: Eric Moore / Lamoureux Pagano & Associates, Inc.
 Copies to: Leo Parker / Lamoureux Pagano & Associates, Inc.
 File

Submitted by:
Lahlaf Geotechnical Consulting, Inc.
 100 Chelmsford Rd, Suite 2
 Billerica, MA 01861



Photo No. 1: Test pit TP-201.



Photo No. 2: Test pit TP-202.




Photo No. 3: Test pit TP-203.




Photo No. 4: Test pit TP-204.



Photo No. 5: Test pit TP-205.

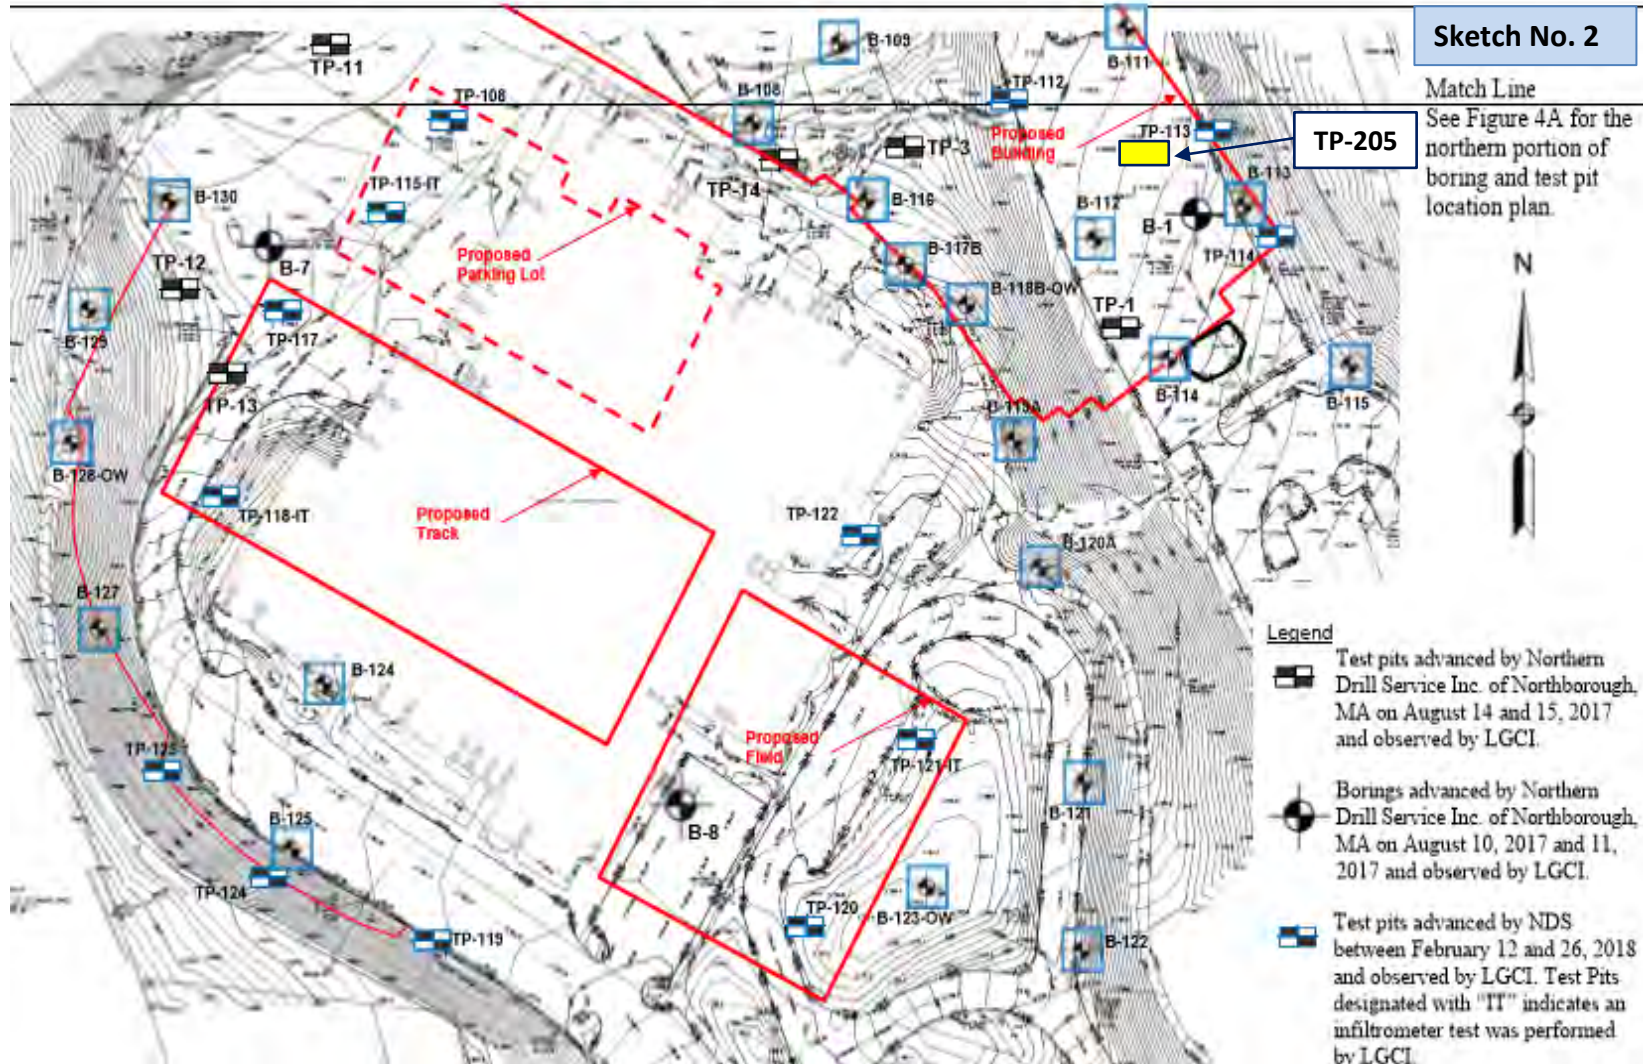

Sketch based on figure 4-A, titled: "Boring and Test Pit Location Plan (North), Proposed Worcester South High School, Worcester, MA" dated April 2018 and prepared by LGCI.

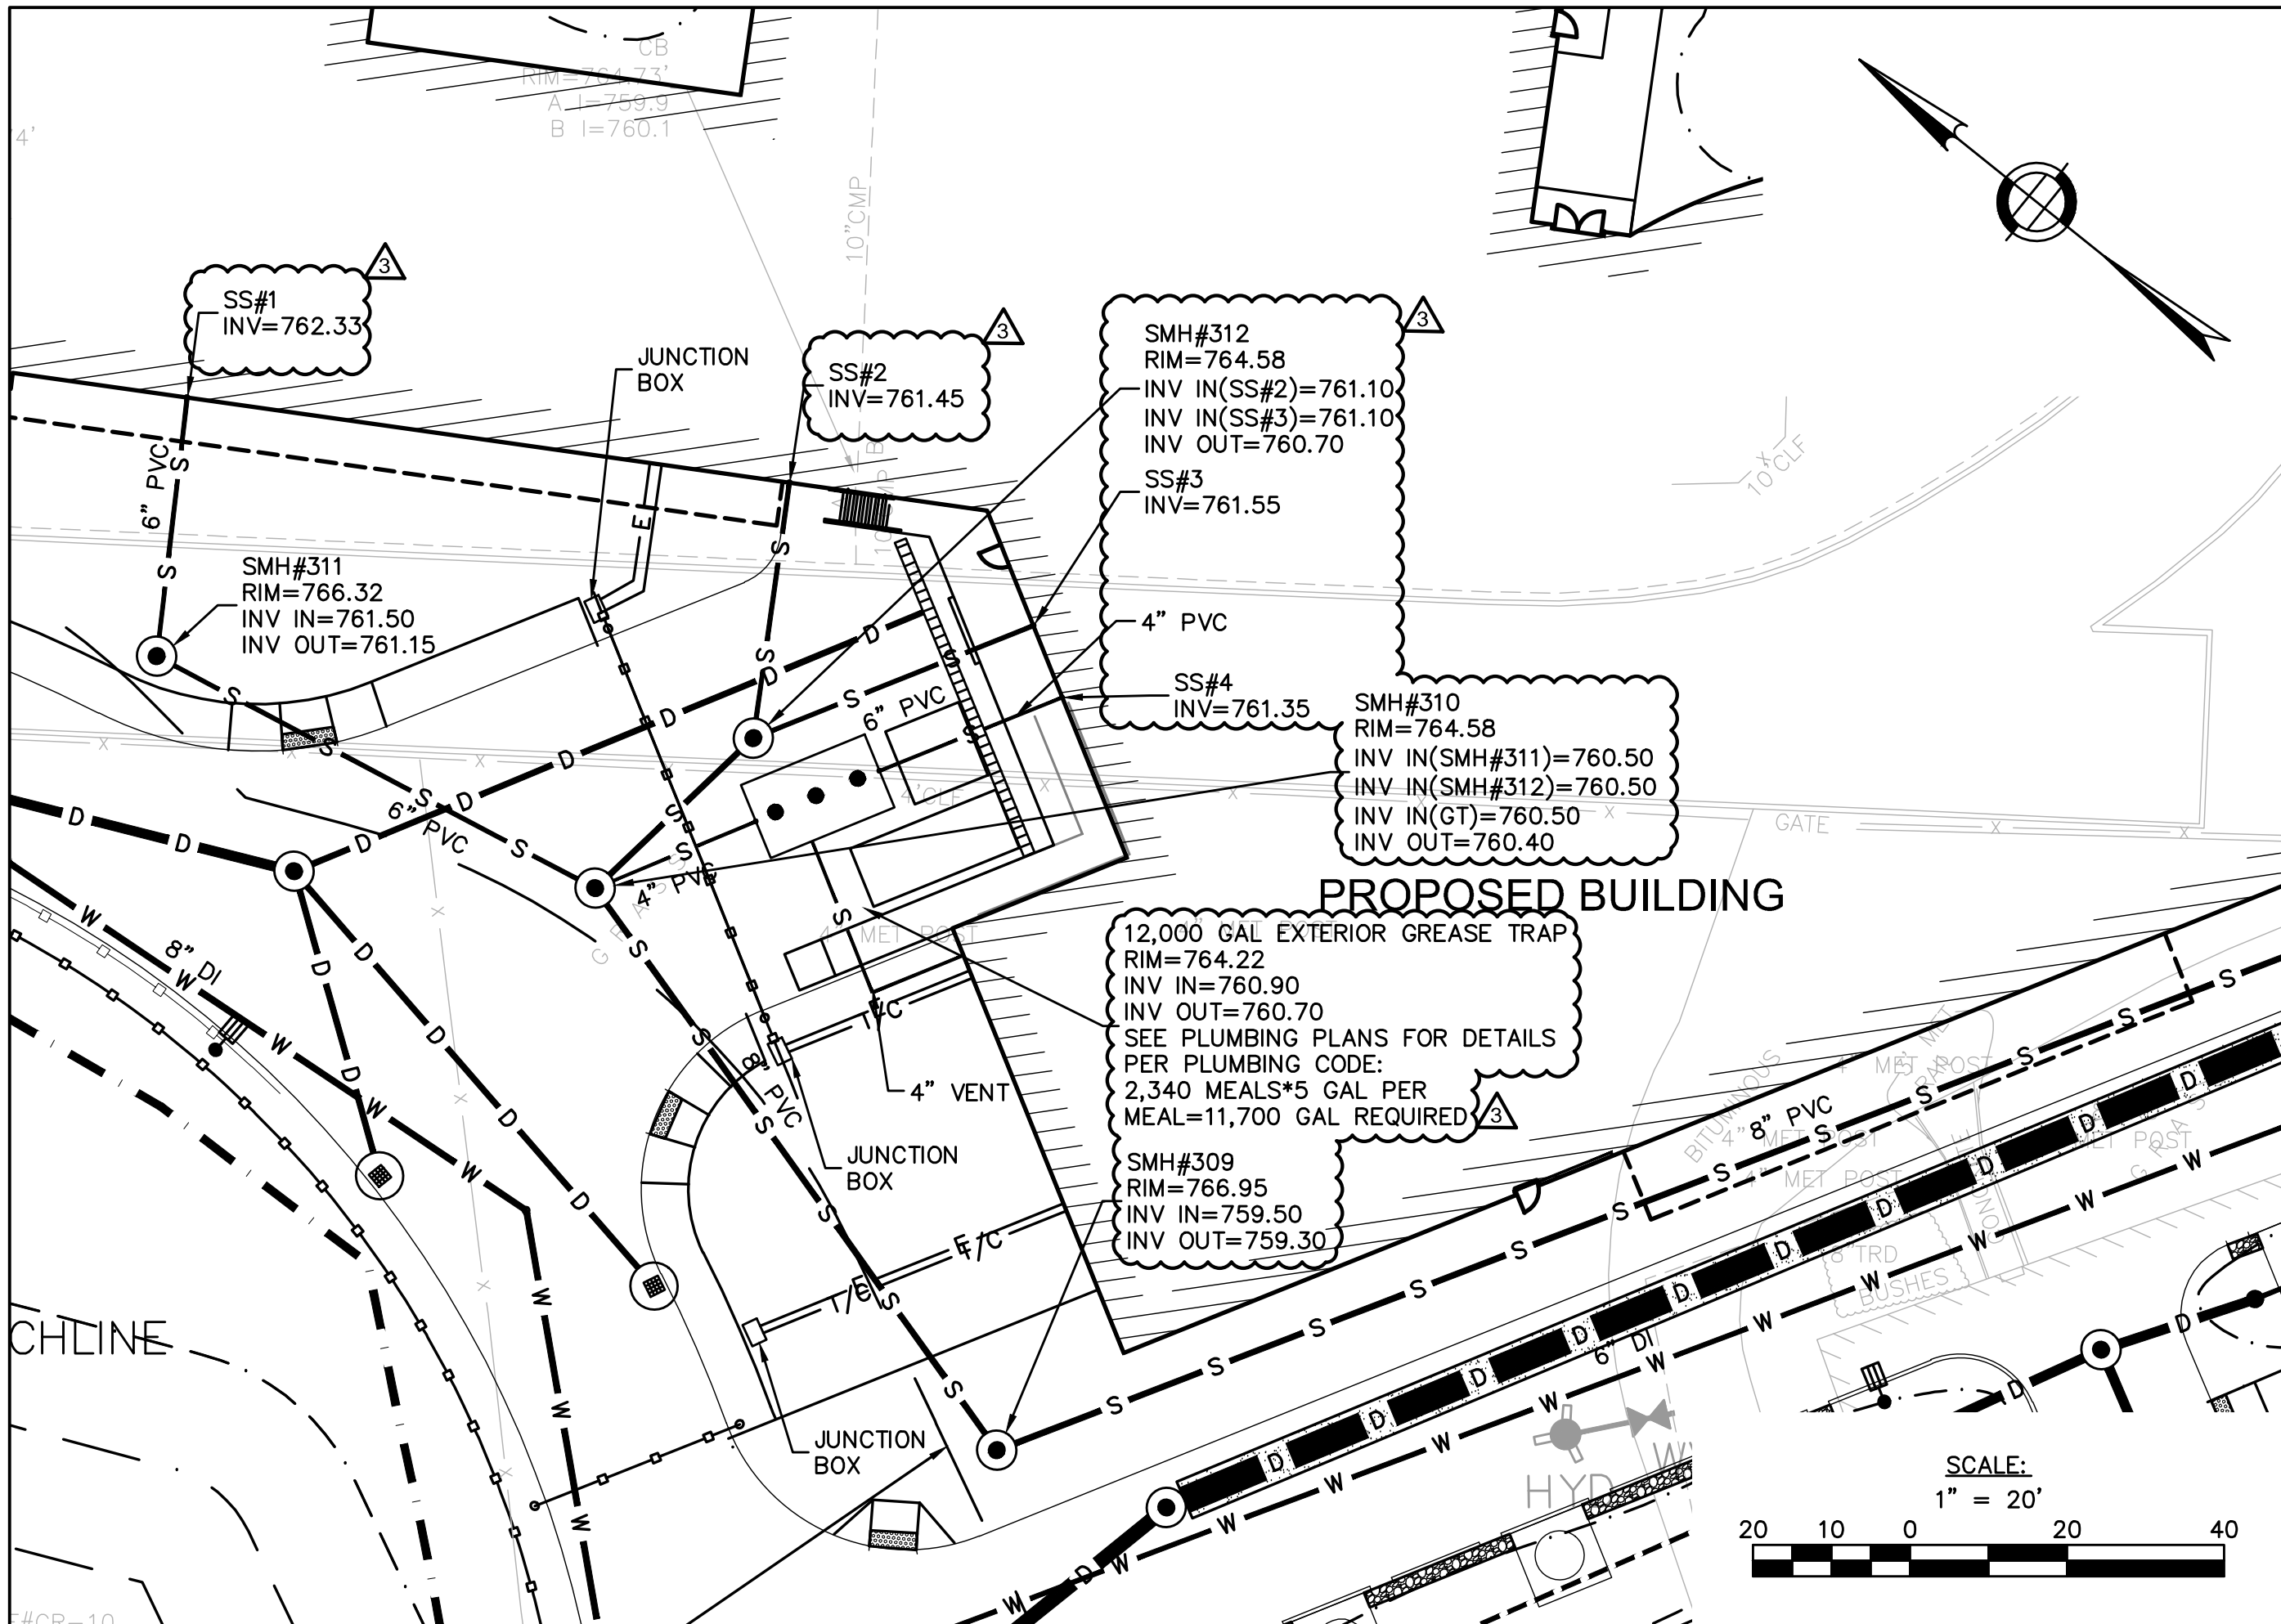

SHEET REF. NO.	C8.0
DRAWING NUMBER:	ADD-3 C-003
DRAWING NAME:	Site Utility Plan Sketch
DATE:	09/17/18
SCALE:	1" = 20'


PROJECT TITLE:
EARLY SITE BID PACKAGE #2
South High Community School
 170 Apricot Street, Worcester, MA 01603

CLIENT INFORMATION:
 Worcester Public Schools



City of Worcester
 Massachusetts, 01603

MEMBER OF
 THE AMERICAN INSTITUTE OF ARCHITECTS





PAVANO ASSOCIATES ARCHITECTS
 108 STATE STREET, SUITE 400
 WORCESTER, MASSACHUSETTS 01603

PROPOSED BUILDING

12,000 GAL EXTERIOR GREASE TRAP
 RIM=764.22
 INV IN=760.90
 INV OUT=760.70
 SEE PLUMBING PLANS FOR DETAILS
 PER PLUMBING CODE:
 2,340 MEALS*5 GAL PER
 MEAL=11,700 GAL REQUIRED

SMH#309
 RIM=766.95
 INV IN=759.50
 INV OUT=759.30

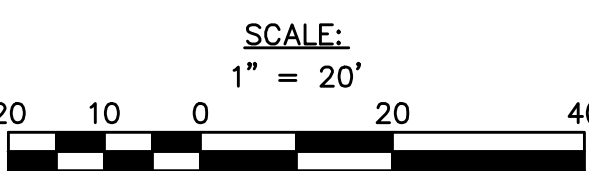

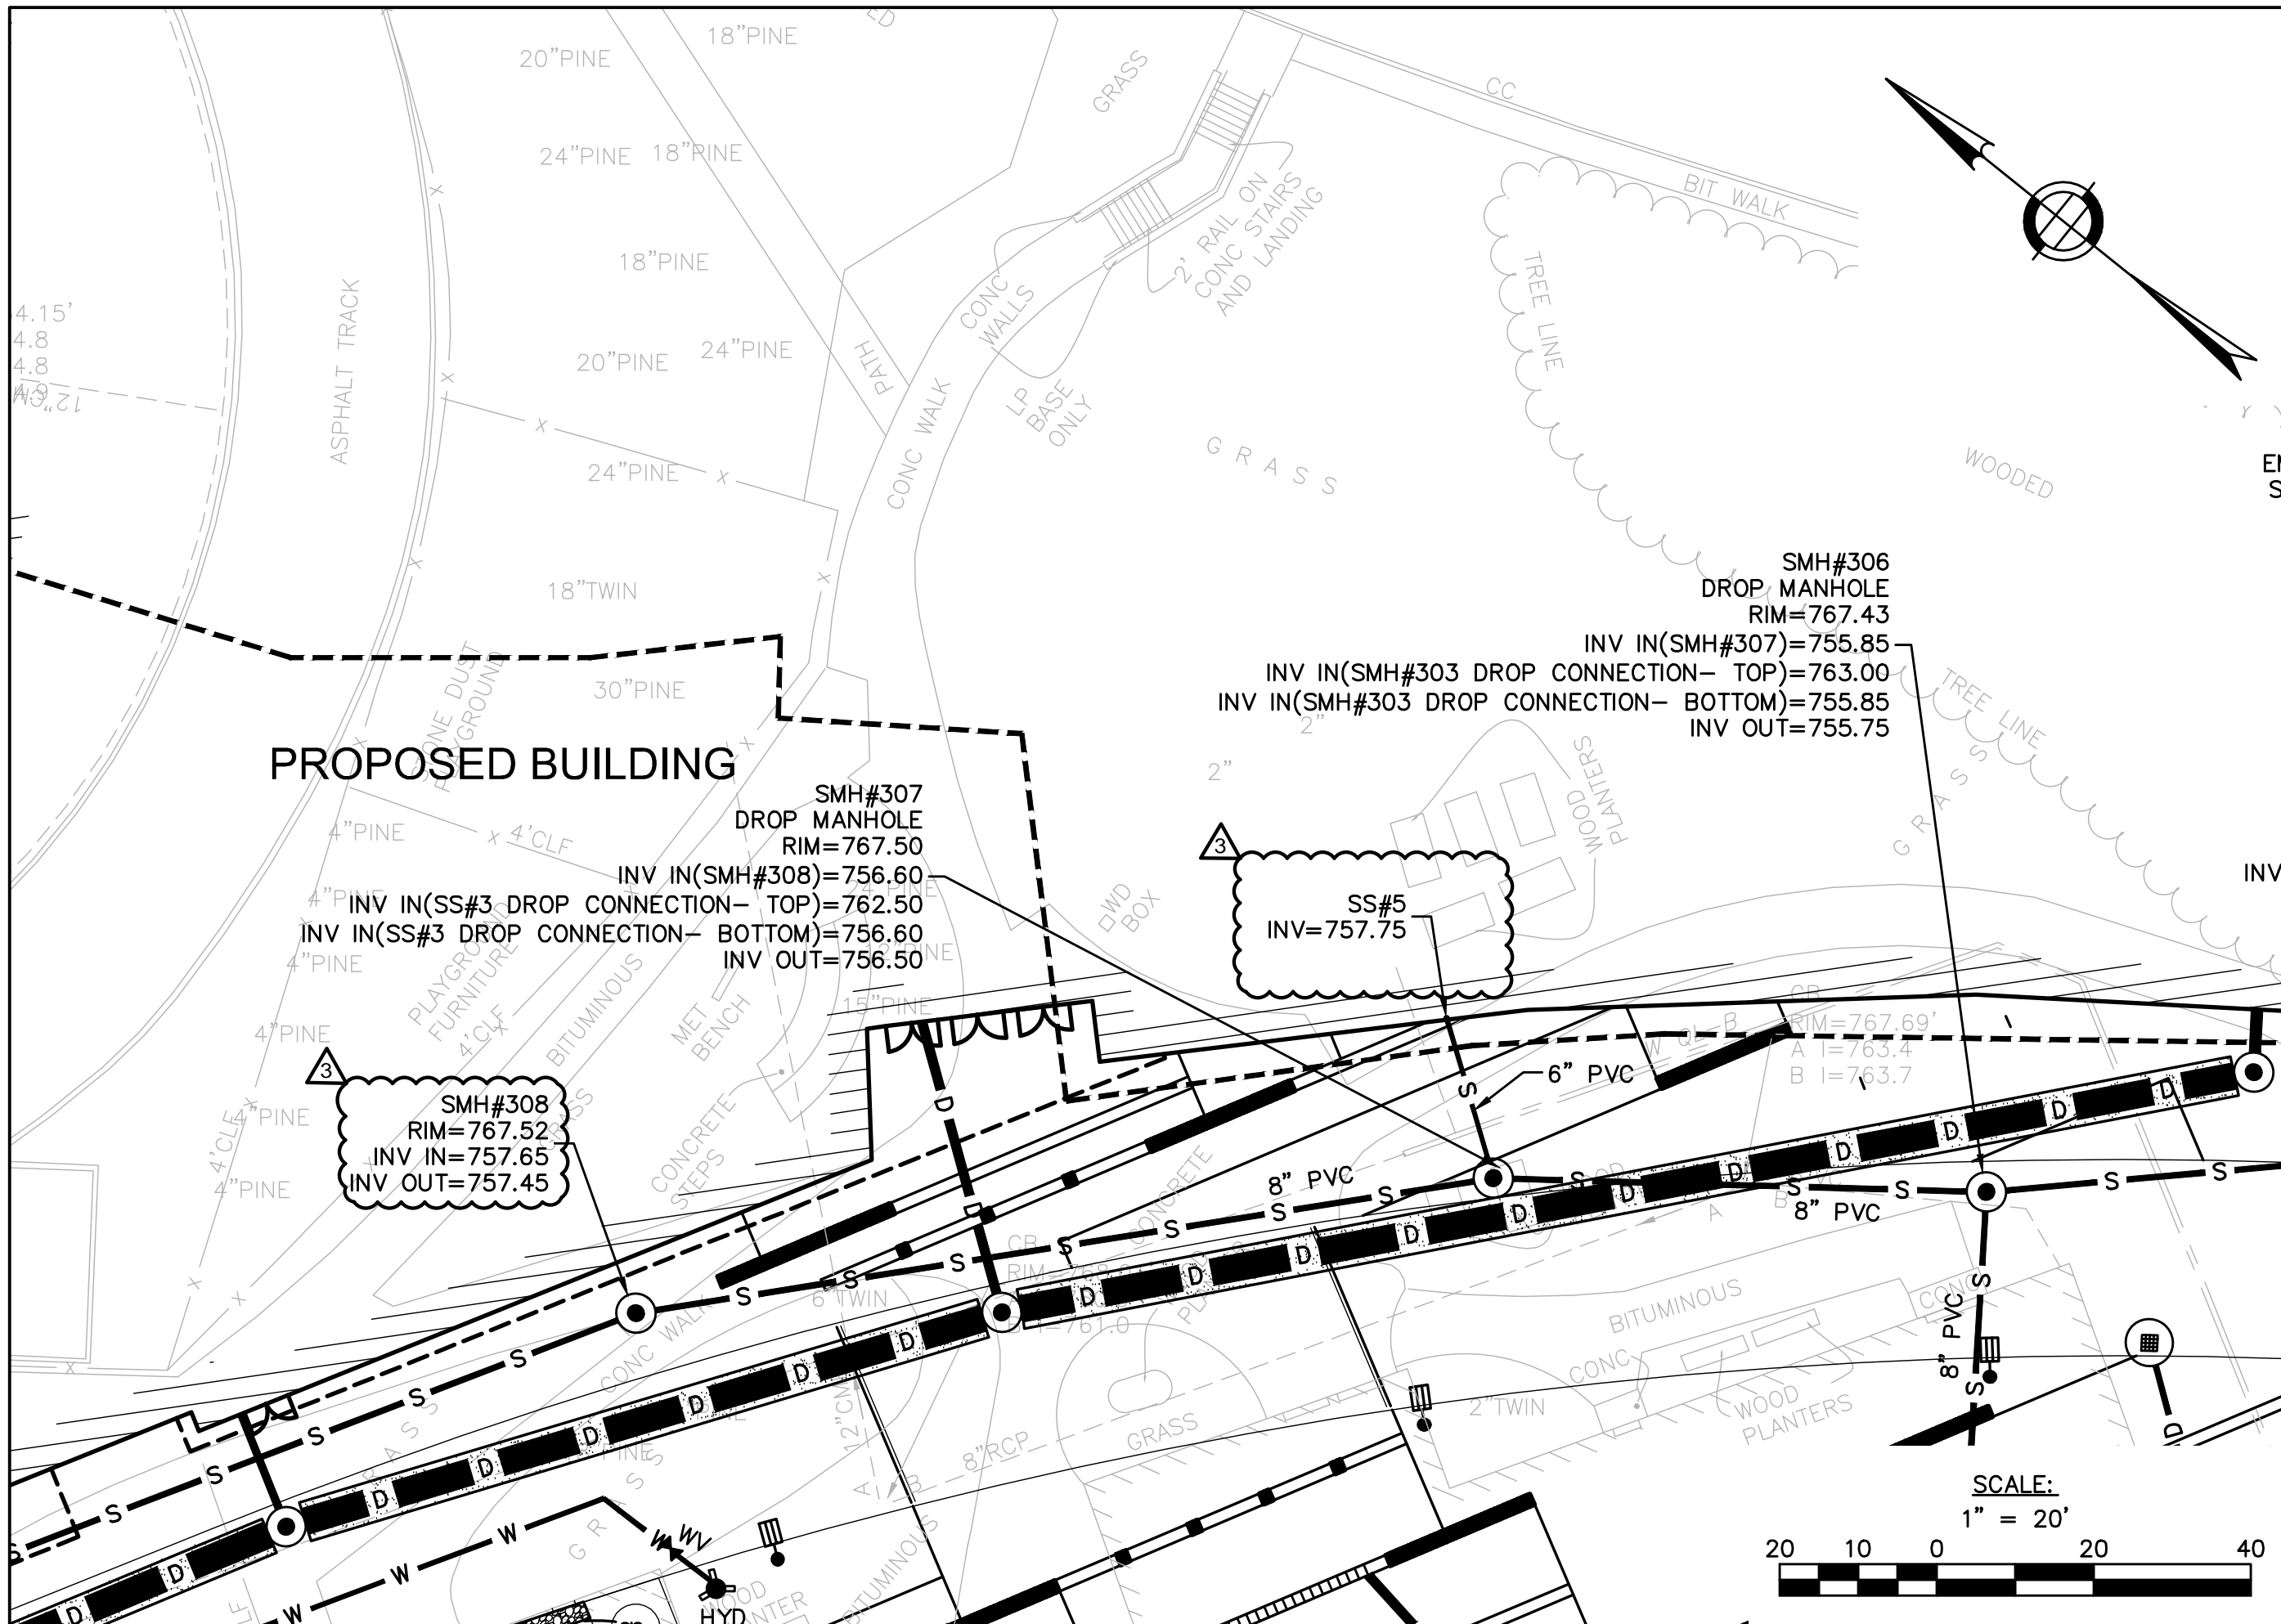

PROPOSED BUILDING



SMH#307
 DROP MANHOLE
 RIM=767.50
 INV IN(SMH#308)=756.60
 INV IN(SS#3 DROP CONNECTION- TOP)=762.50
 INV IN(SS#3 DROP CONNECTION- BOTTOM)=756.60
 INV OUT=756.50

SMH#308
 RIM=767.52
 INV IN=757.65
 INV OUT=757.45


SMH#306
 DROP MANHOLE
 RIM=767.43
 INV IN(SMH#307)=755.85
 INV IN(SMH#303 DROP CONNECTION- TOP)=763.00
 INV IN(SMH#303 DROP CONNECTION- BOTTOM)=755.85
 INV OUT=755.75

SS#5
 INV=757.75

RIM=767.69'
 A I=763.4
 B I=763.7

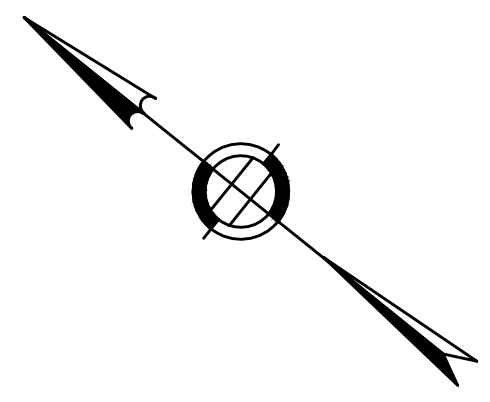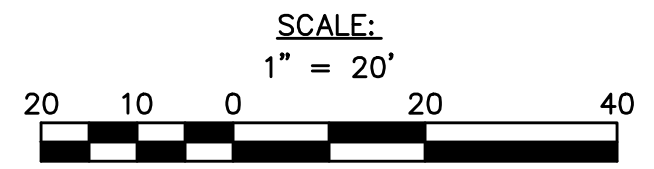

SHEET REF. NO. C8.0	DRAWING NUMBER: ADD-3 C-004
DRAWING NAME: Site Utility Plan Sketch	
PROJECT TITLE: EARLY SITE BID PACKAGE #2 South High Community School 170 Apricot Street, Worcester, MA 01603	
CLIENT INFORMATION: Worcester Public Schools	
MEMBER OF THE AMERICAN INSTITUTE OF ARCHITECTS	

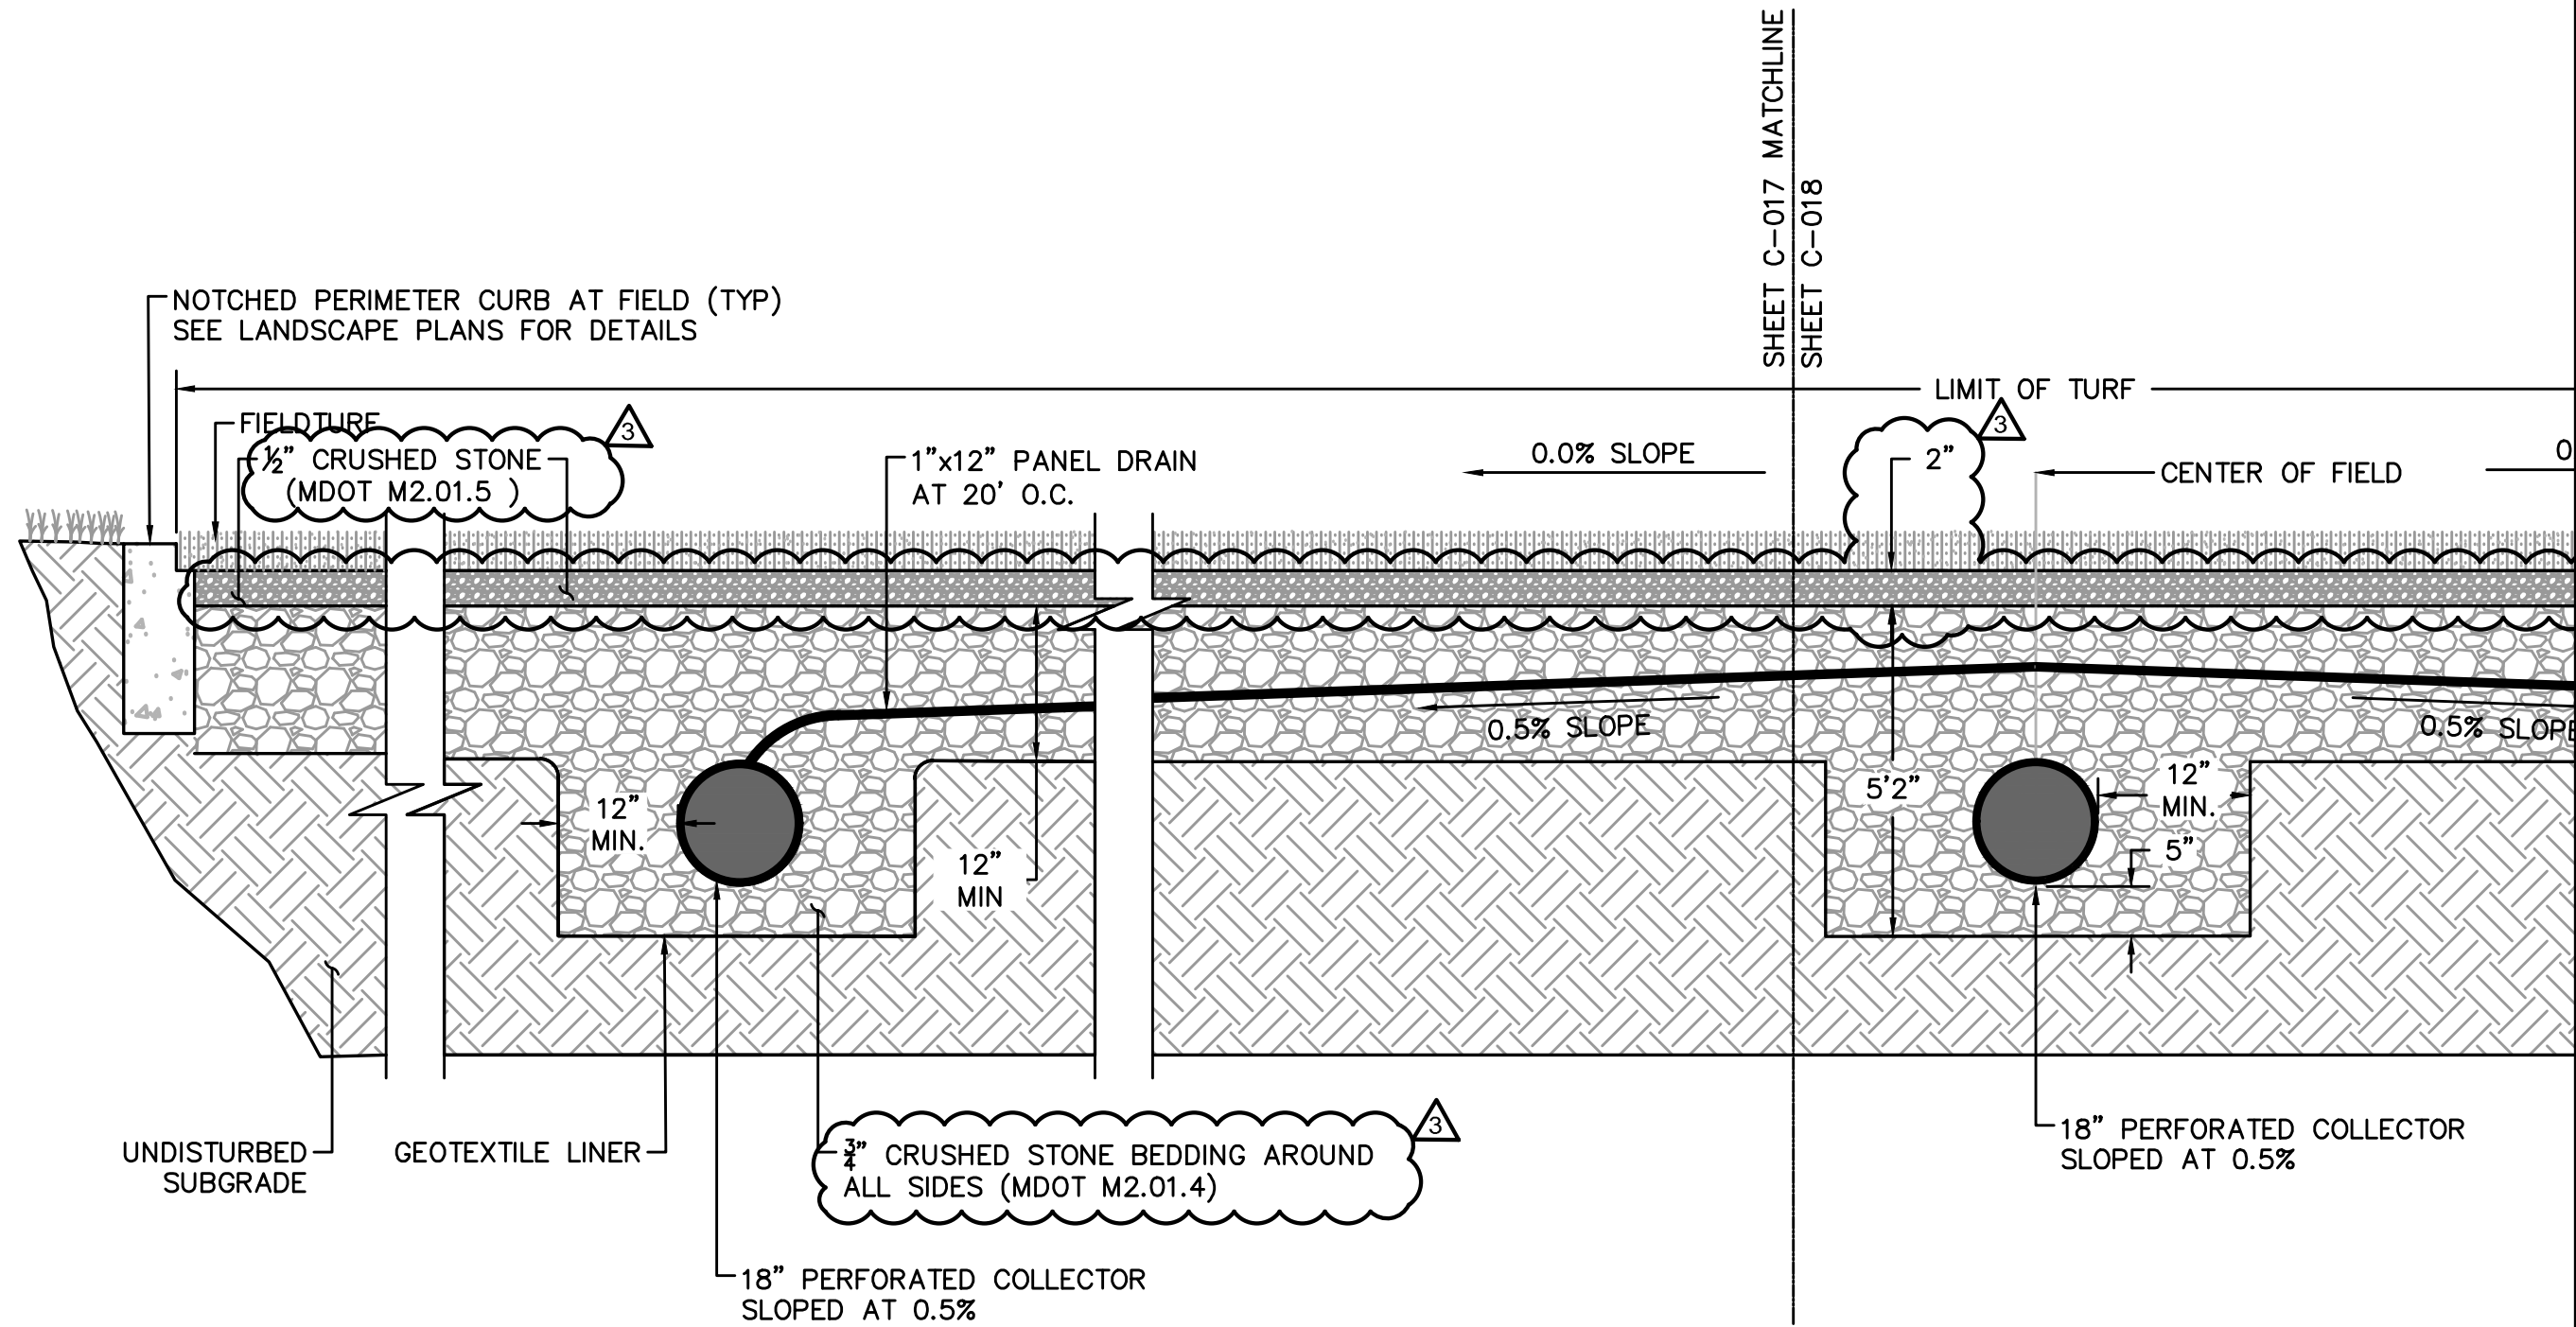

SYNTHETIC TURF FIELD SYSTEM DETAIL


NOT TO SCALE

SHEET C-017 MATCHLINE
SHEET C-018

DRAWING NAME: Civil Detail Sketch	SHEET REF. NO. C11.2
DATE: 09/17/18	DRAWING NUMBER: ADD-3
SCALE: As Noted	C-017


PROJECT TITLE:
EARLY SITE BID PACKAGE #2

South High Community School
170 Apricot Street, Worcester, MA 01603

CLIENT INFORMATION:
Worcester Public Schools

City of Worcester
Massachusetts, 01605


LAMORTIUS PAGANO
ASSOCIATES ARCHITECTS
108 COLLE & REESE SUITE 400
WORCESTER, MASSACHUSETTS 01605

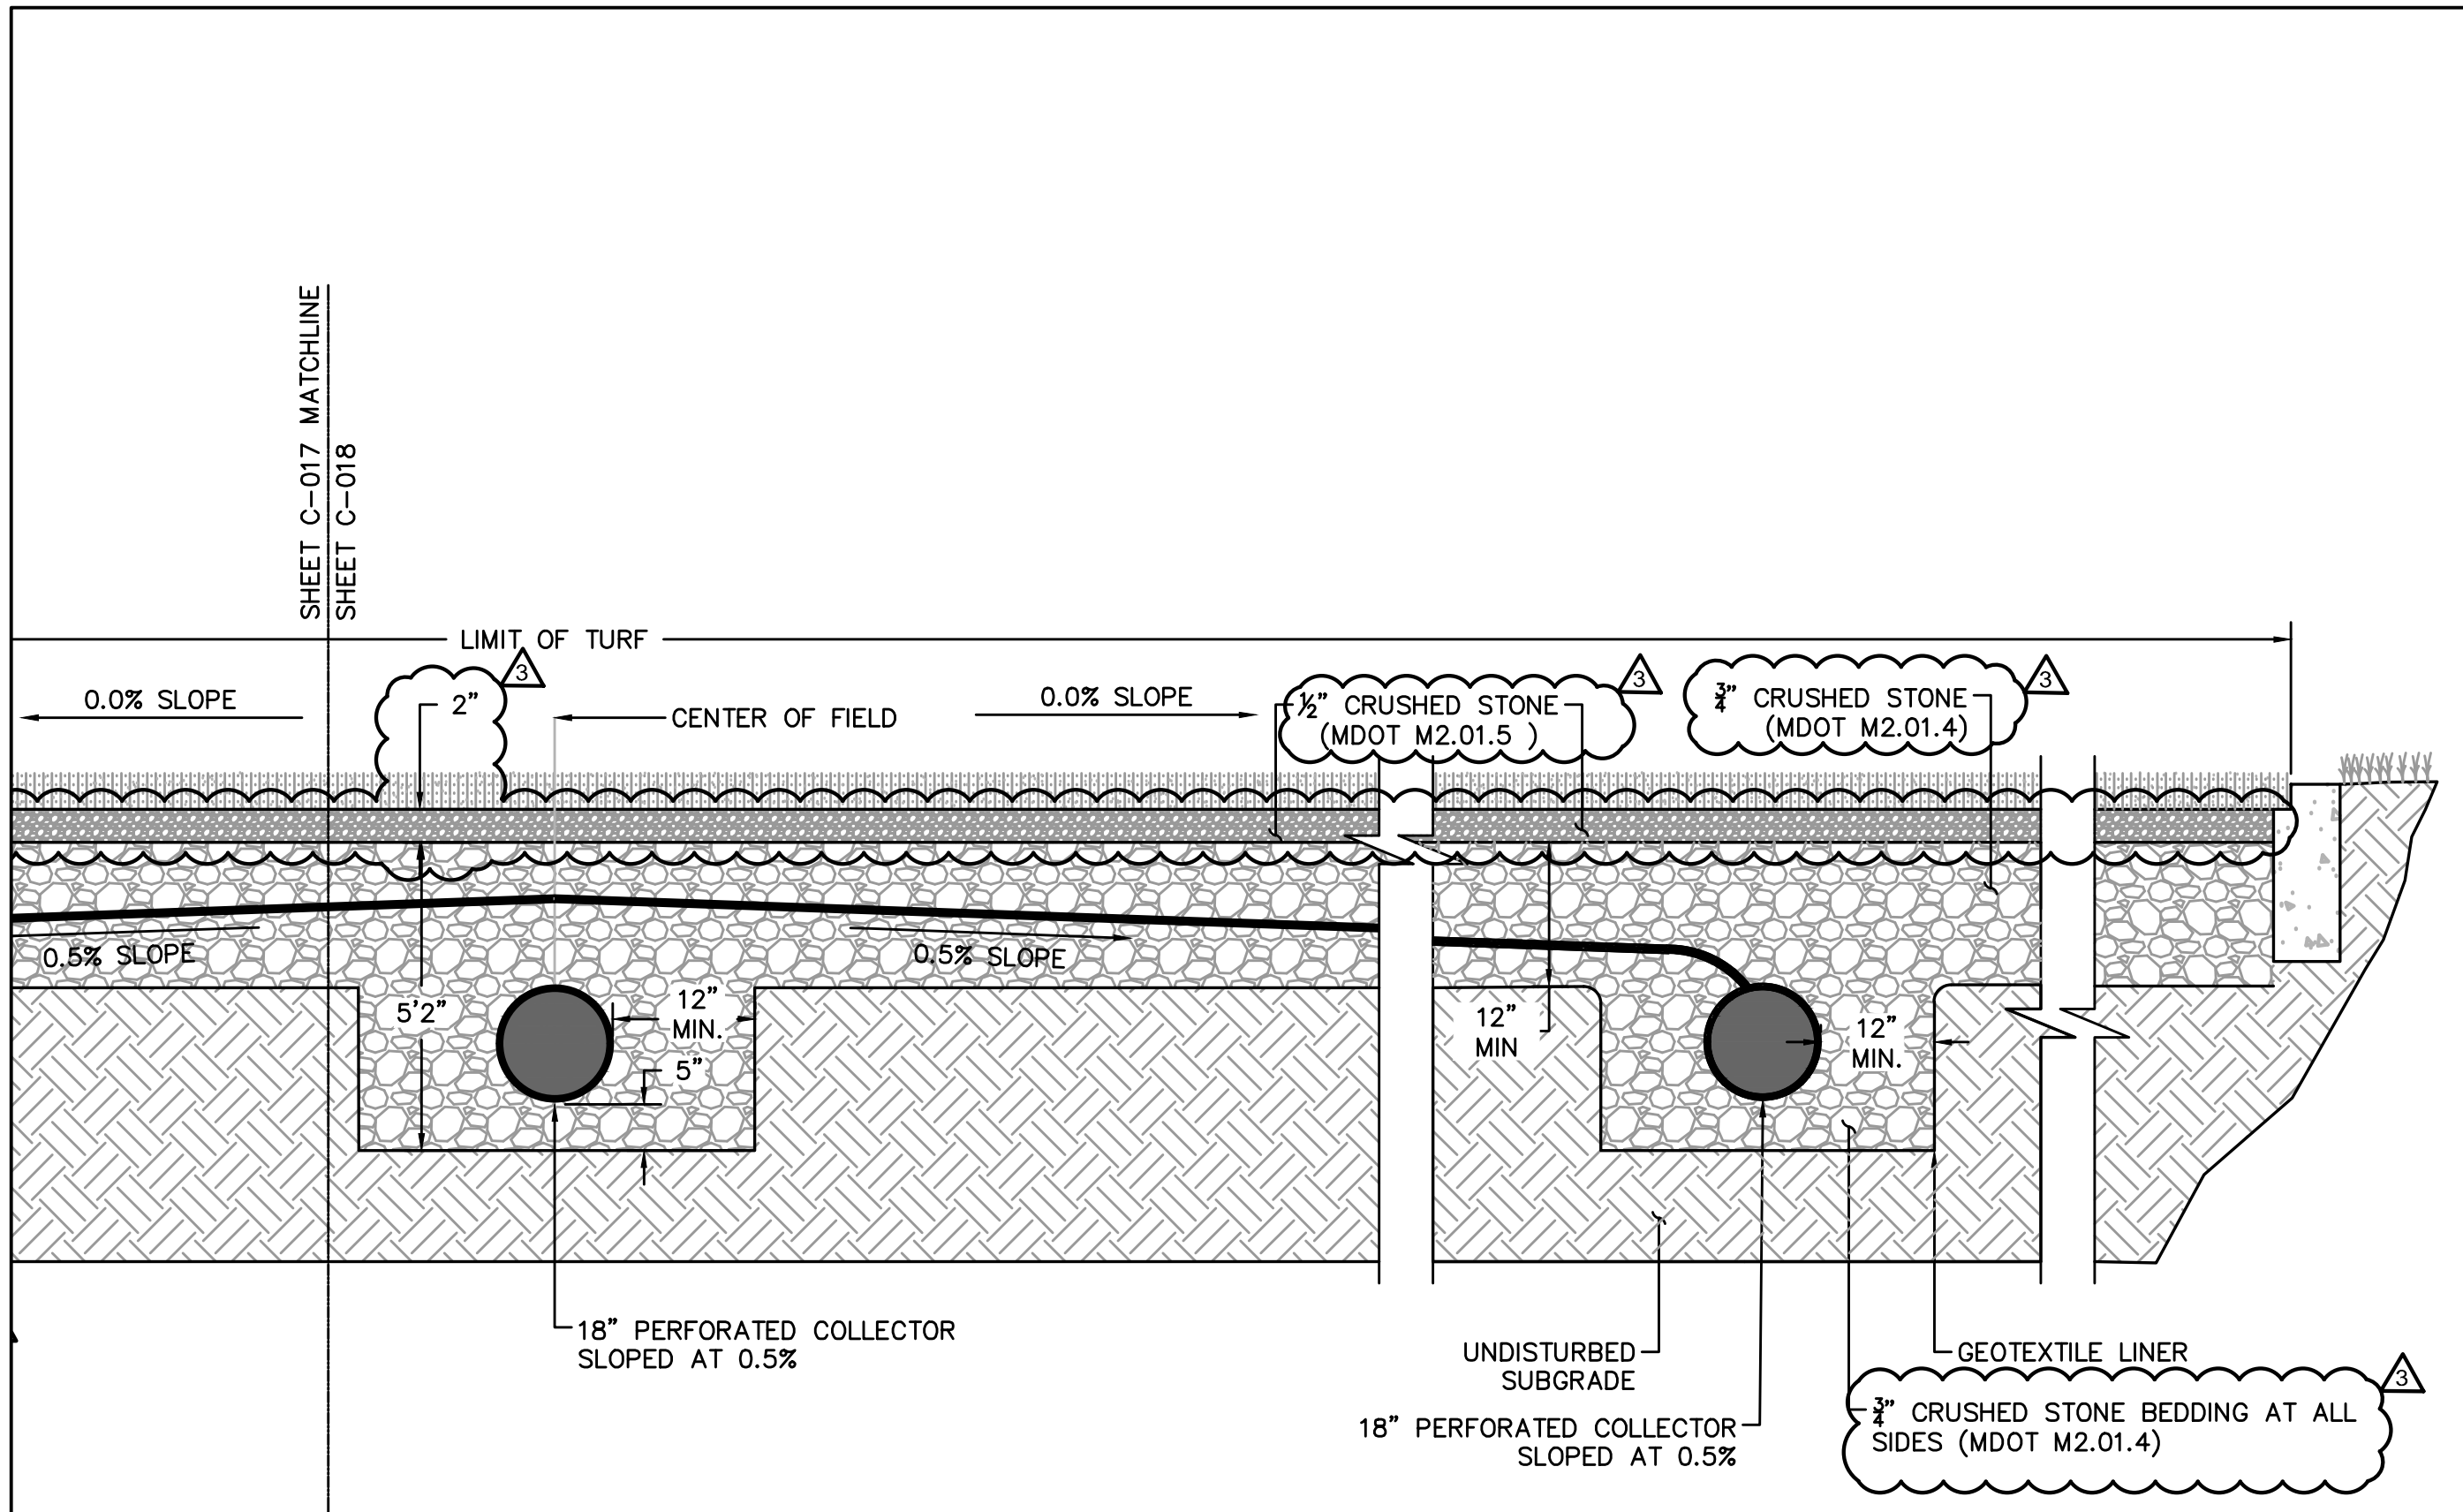

MEMBER OF
THE AMERICAN INSTITUTE OF ARCHITECTS





SYNTHETIC TURF FIELD SYSTEM DETAIL

NOT TO SCALE



SHEET C-017 MATCHLINE
SHEET C-018

DRAWING NAME: Civil Detail Sketch	SHEET REF. NO. C11.2
	DRAWING NUMBER: ADD-3 C-018
DATE: 09/17/18	PROJECT TITLE: EARLY SITE BID PACKAGE #2 South High Community School 170 Apricot Street, Worcester, MA 01603
SCALE: As Noted	
CLIENT INFORMATION: Worcester Public Schools	 <p>City of Worcester Worcester, Massachusetts, 01605</p>
 <p>LAMORTIUS PAGANO ASSOCIATES, ARCHITECTS 108 COLE & BEEKER SUITE 400 WORCESTER, MASSACHUSETTS 01605</p>	<p>THE AMERICAN INSTITUTE OF ARCHITECTS</p>

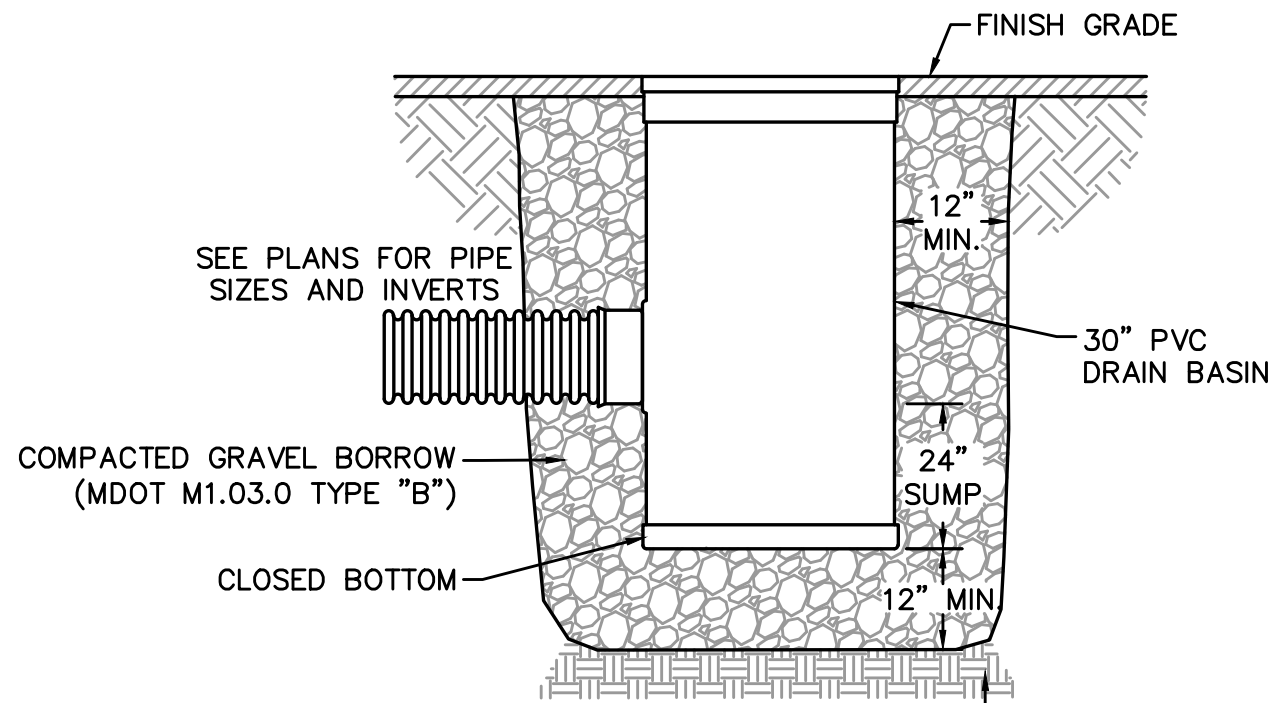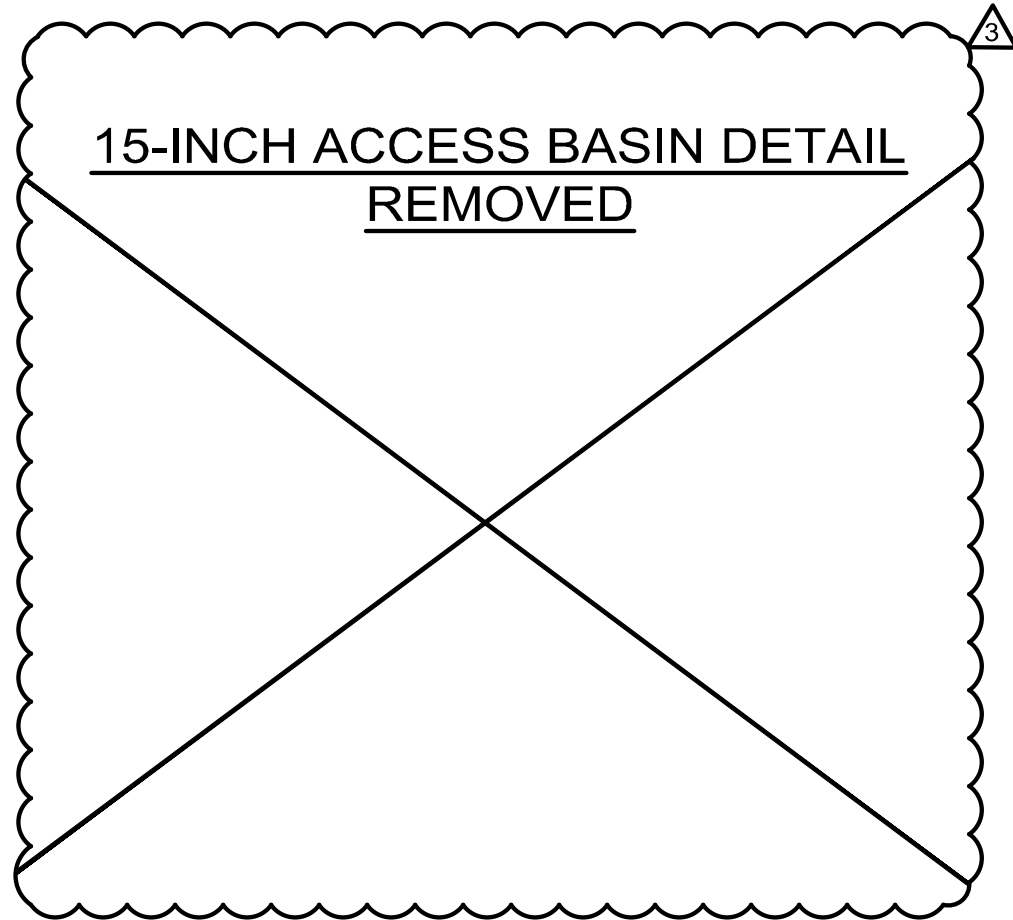

COMPACTED SUBGRADE, REMOVE UNSUITABLE MATERIAL & REPLACE WITH GRAVEL BORROW (MDOT M1.03.0 TYPE "B") COMPACTED IN 6" LAYERS

SECTION VIEW

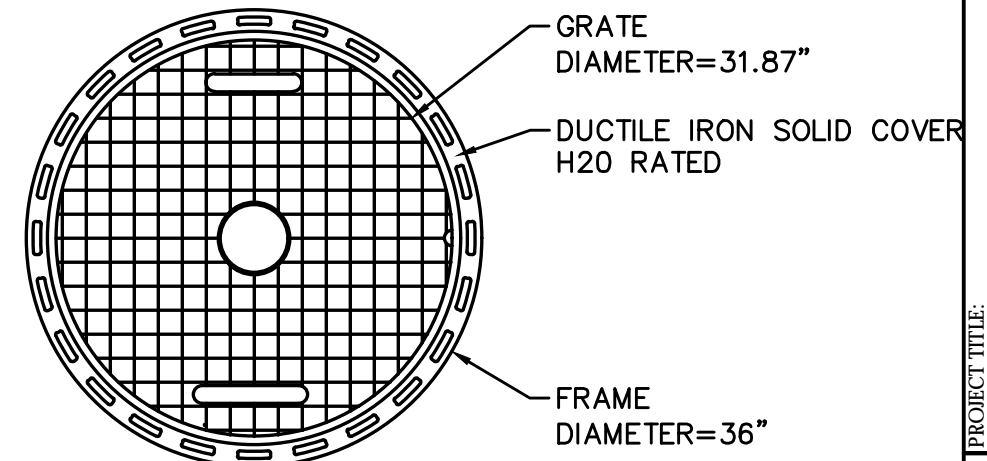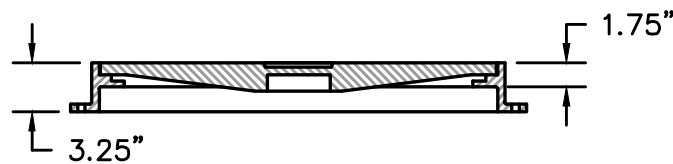

SOLID COVER

NOTES:

1. FRAME AND COVER SHALL BE DUCTILE IRON CONFORMING TO ASTM A536 GRADE 70-50-05.
2. 30" ACCESS BASINS SHALL BE NYLOPLAST MODEL 3099CGC AS MANUFACTURED BY ADVANCED DRAINAGE SYSTEMS, INC., OR APPROVED EQUAL.
3. ACCESS BASINS SHALL BE CUSTOM MANUFACTURED ACCORDING TO THE PLANS AND DETAIL.
4. CASTINGS SHALL BE FURNISHED WITH A BLACK PAINT.
5. SEE PLANS FOR LAYOUT AND ELEVATIONS OF DRAIN PIPES TO ACCESS BASINS.

30" ACCESS BASIN DETAIL (AB#256, AB#257, & AB#266)

NOT TO SCALE

SHEET REF. NO.
C11.1/C11.2

DRAWING NAME:
Civil Detail Sketch

DRAWING NUMBER:
ADD-3
C-020

PROJECT TITLE:
EARLY SITE BID PACKAGE #2

South High Community School

170 Apricot Street, Worcester, MA 01603

CLIENT INFORMATION:
Worcester Public Schools




City of Worcester
Massachusetts, 01605




LAMOURIS PAGANO
ASSOCIATES, ARCHITECTS
108 GLOBE STREET, SUITE 400
WORCESTER, MASSACHUSETTS 01605

MEMBER OF
THE AMERICAN INSTITUTE OF ARCHITECTS

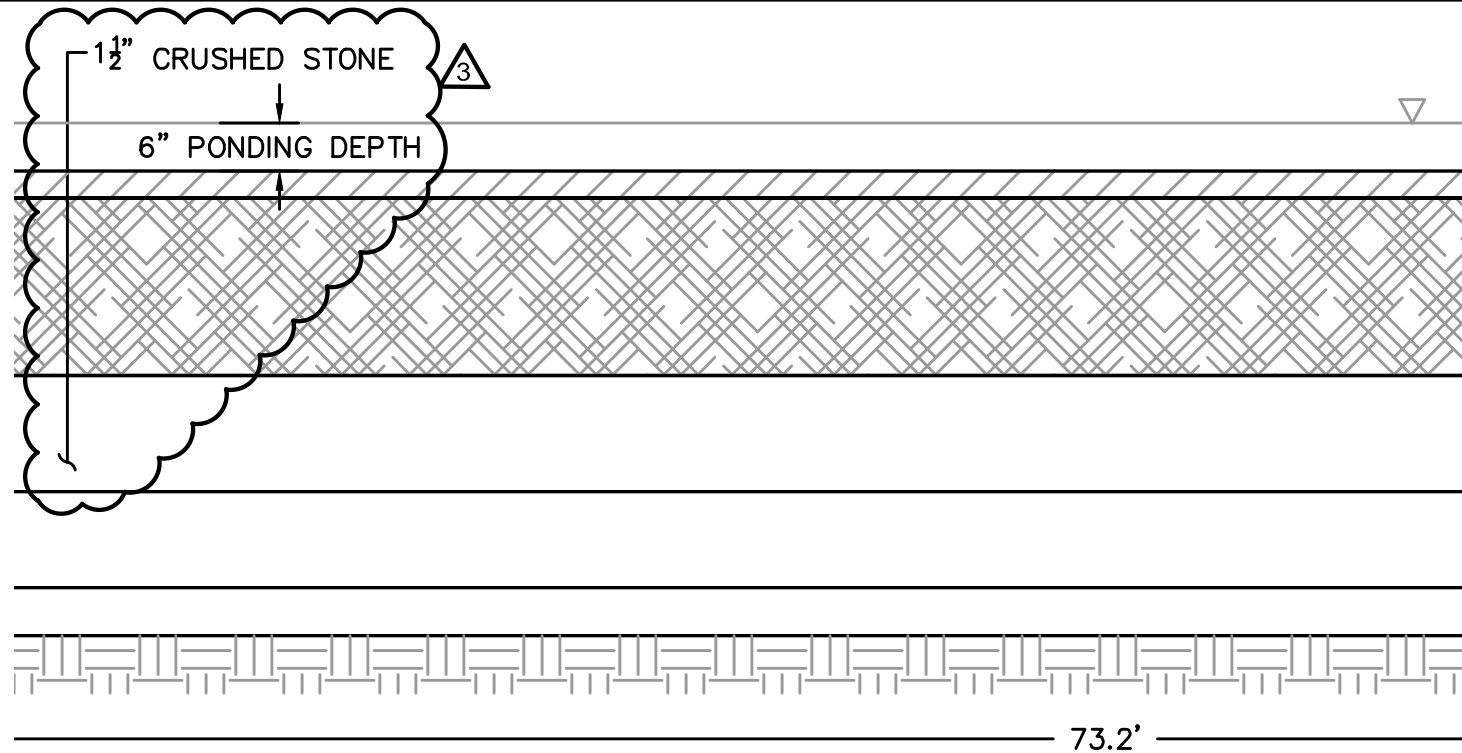

SECTION B-B
RAIN GARDEN #1 AND #2
NOT TO SCALE

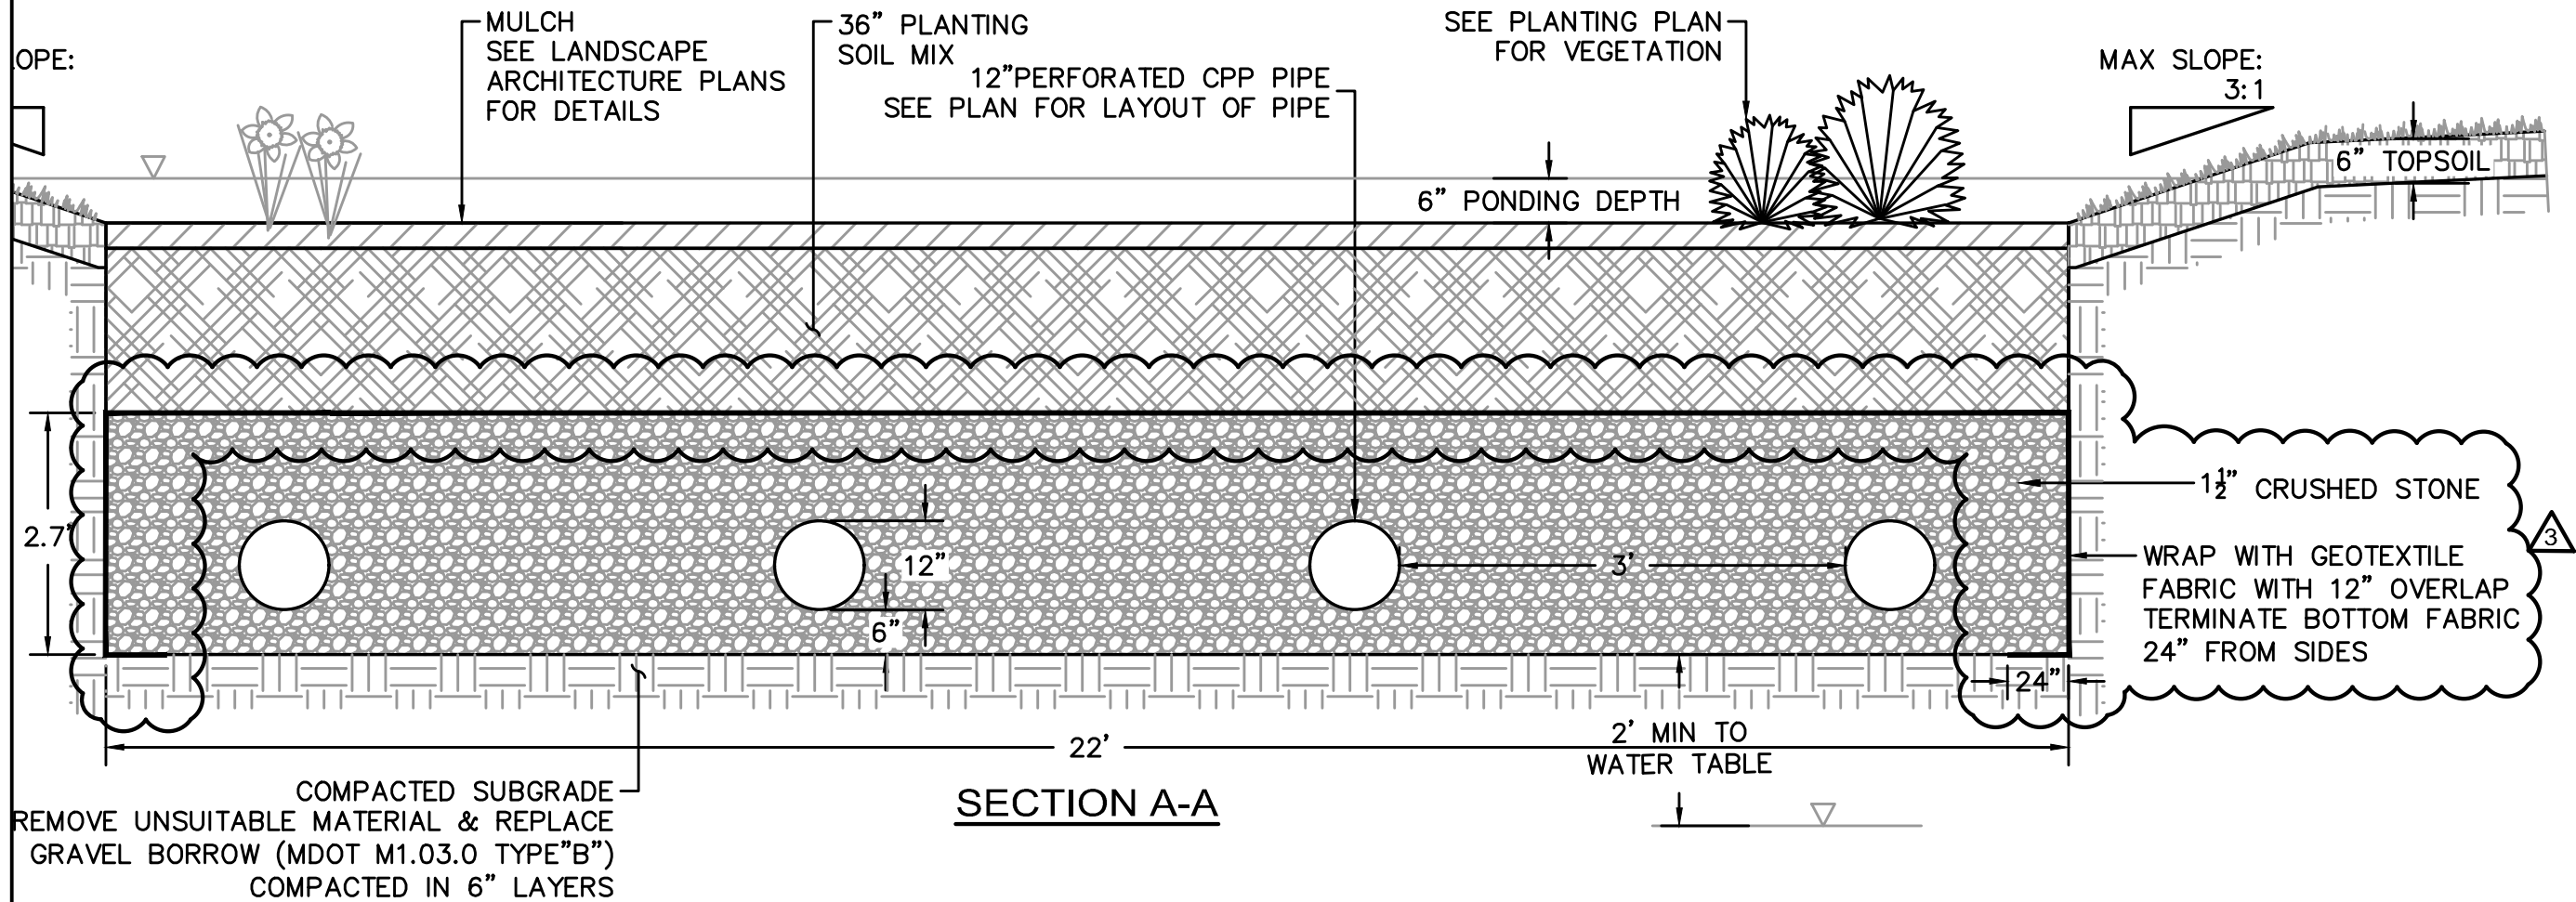


DRAWING NAME: Civil Detail Sketch
SHEET REF. NO. C11.3

DATE: 09/17/18
SCALE: NTS
DRAWING NUMBER: ADD-3
C-021

PROJECT TITLE: EARLY SITE BID PACKAGE #2
South High Community School
170 Apricot Street, Worcester, MA 01603

CLIENT INFORMATION:
Worcester Public Schools




City of Worcester
Worcester, Massachusetts, 01605




LAMOURTUS PACANO
ASSOCIATES ARCHITECTS
108 COLE & BEEKS SUITE 400
WORCESTER, MASSACHUSETTS 01605

MEMBER OF
THE AMERICAN INSTITUTE OF ARCHITECTS

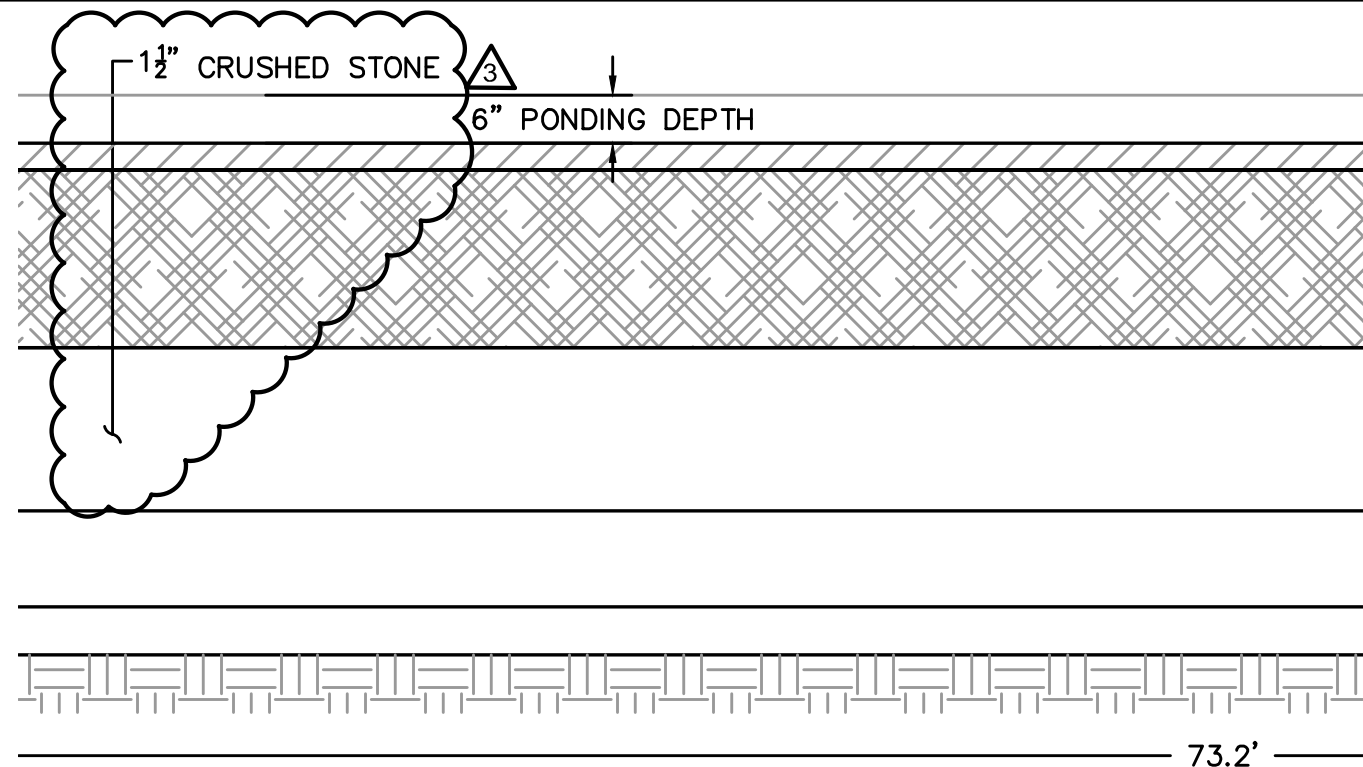




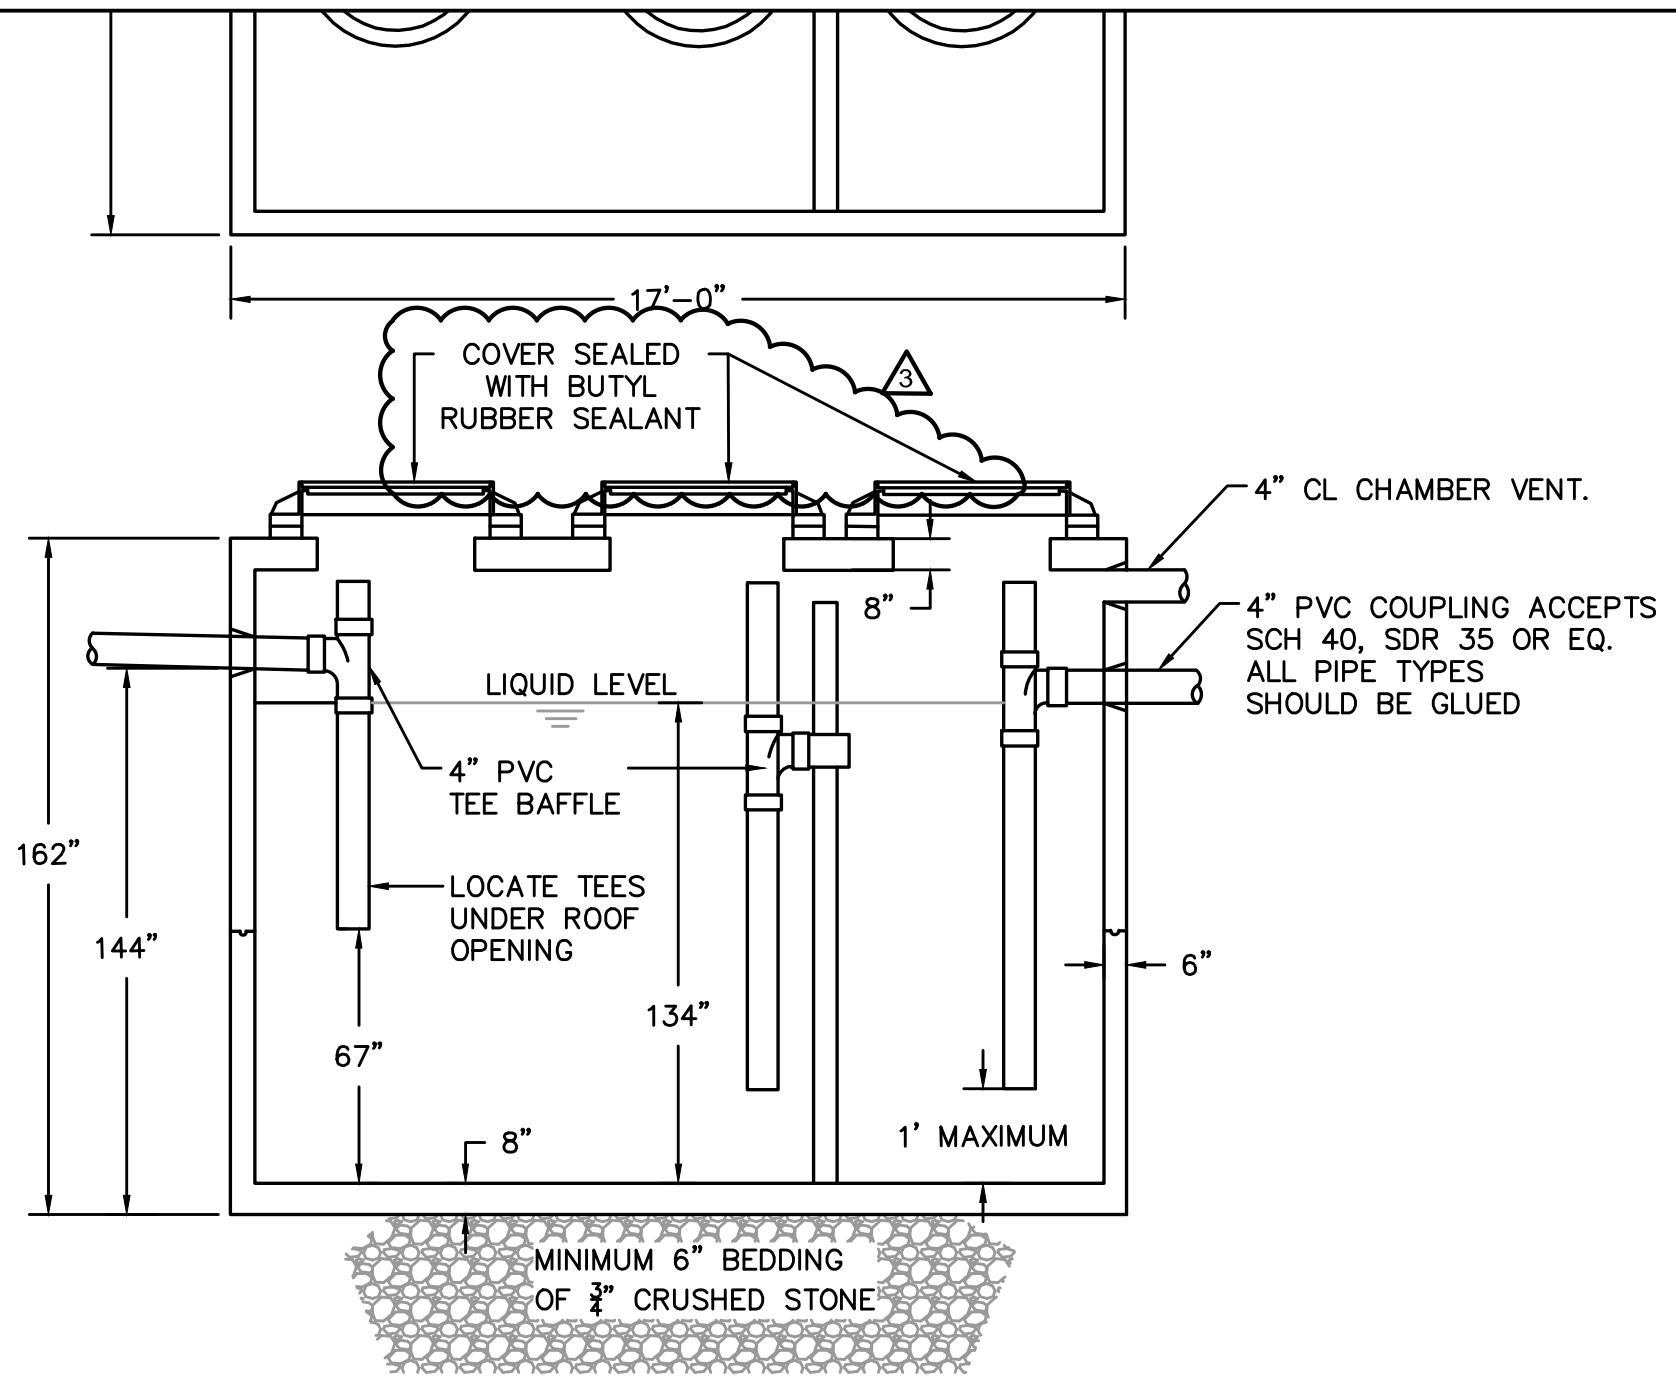
SECTION B-B
RAIN GARDEN #3

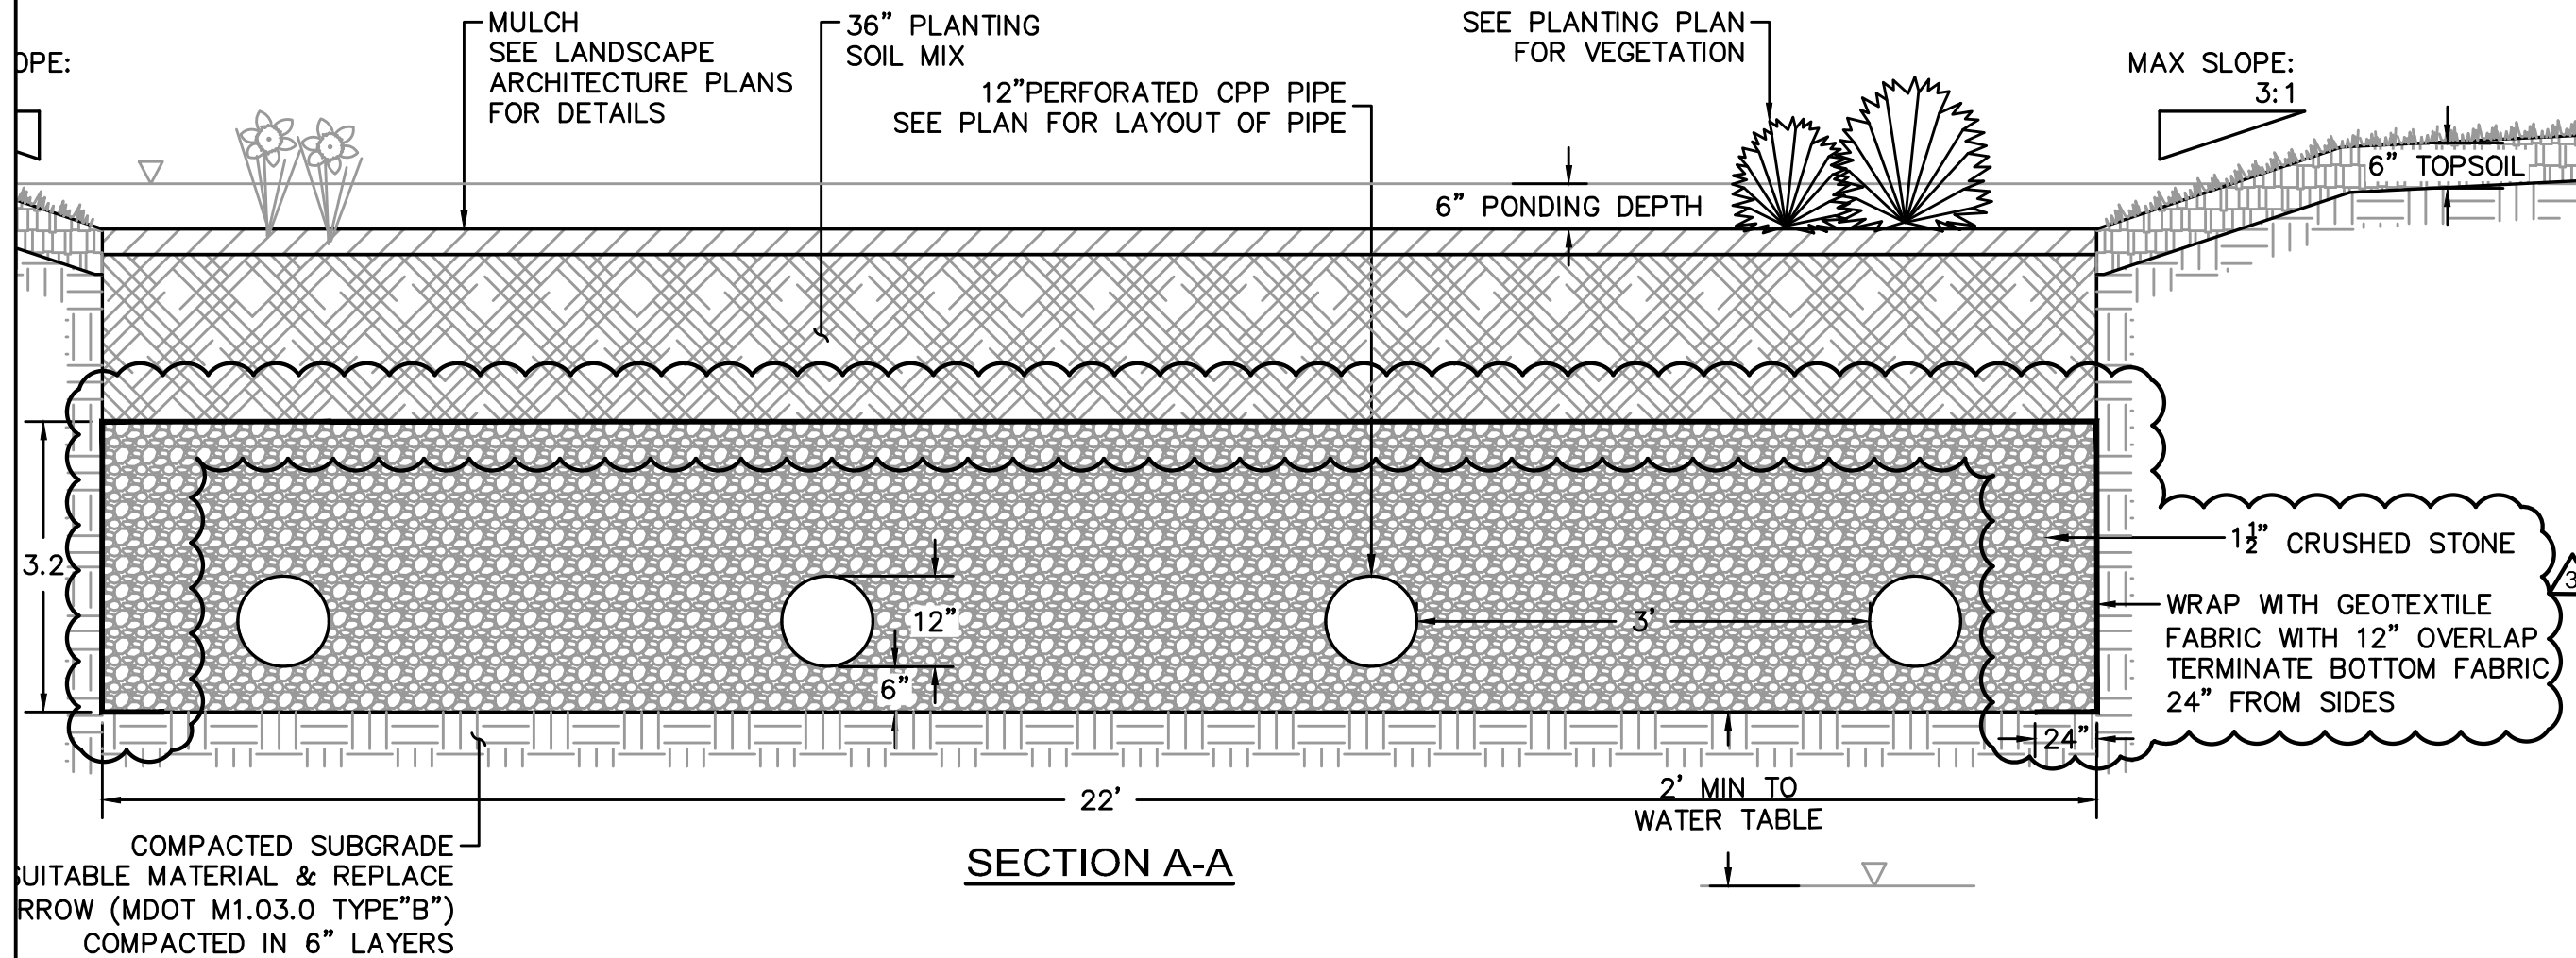NOT TO SCALE



SECTION A-A

DRAWING NAME: Civil Detail Sketch	SHEET REF. NO. C11.3
	DRAWING NUMBER: ADD-3 C-022
DATE: 09/17/18	PROJECT TITLE: EARLY SITE BID PACKAGE #2 South High Community School 170 Apricot Street, Worcester, MA 01603
SCALE: NTS	
CLIENT INFORMATION: Worcester Public Schools	 <p>City of Worcester Massachusetts, 01605</p>
 <p>LAMORTIUS PAGANO ASSOCIATES ARCHITECTS 108 FOLEY STREET, SUITE 400 WORCESTER, MASSACHUSETTS 01605</p>	 <p>MEMBER OF THE AMERICAN INSTITUTE OF ARCHITECTS</p>



GENERAL NOTES:

CONCRETE SPECIFICATIONS:

1. 4000 PSI @ 28 DAYS
2. 4%-6% ENTRAINED AIR
3. TANK PENETRATIONS ARE INTEGRALLY CAST
4. ALL JOINTS SEALED WITH BUTYL RUBBER JOINT SEALANT

GREASE TRAP INFORMATION:

1. TANKS SHOULD BE PUMPED AS NEEDED
2. ACCESS COVERS SHOULD HAVE RISERS TO BRING COVER ACCESS TO GRADE

CHAMBER VENT INFORMATION:

1. THE REQUIRED CHAMBER VENT SHALL BE PIPES INTO BUILDING PER 248 CNR10.16.5(e)
2. THE VENT SHALL BE OF CAST IRON, AND HAVE A MINIMUM DIAMETER OF 4"

**WORCESTER STANDARD 2 COMPARTMENT
GREASE INTERCEPTOR
(12,000 GALLON)
NOT TO SCALE**

SHEET REF. NO. C11.4	DRAWING NUMBER: ADD-3 C-023
DRAWING NAME: Civil Detail Sketch	
DATE: 09/17/18	SCALE: NTS

PROJECT TITLE:
EARLY SITE BID PACKAGE #2

South High Community School
170 Apricot Street, Worcester, MA 01603

CLIENT INFORMATION:
Worcester Public Schools






City of Worcester
Worcester, Massachusetts, 01605



LAMORTUS PAGANO
ASSOCIATES ARCHITECTS
178 FOLEY & BEEKER SUITE 400
WORCESTER, MASSACHUSETTS 01605

MEMBER OF
THE AMERICAN INSTITUTE OF ARCHITECTS

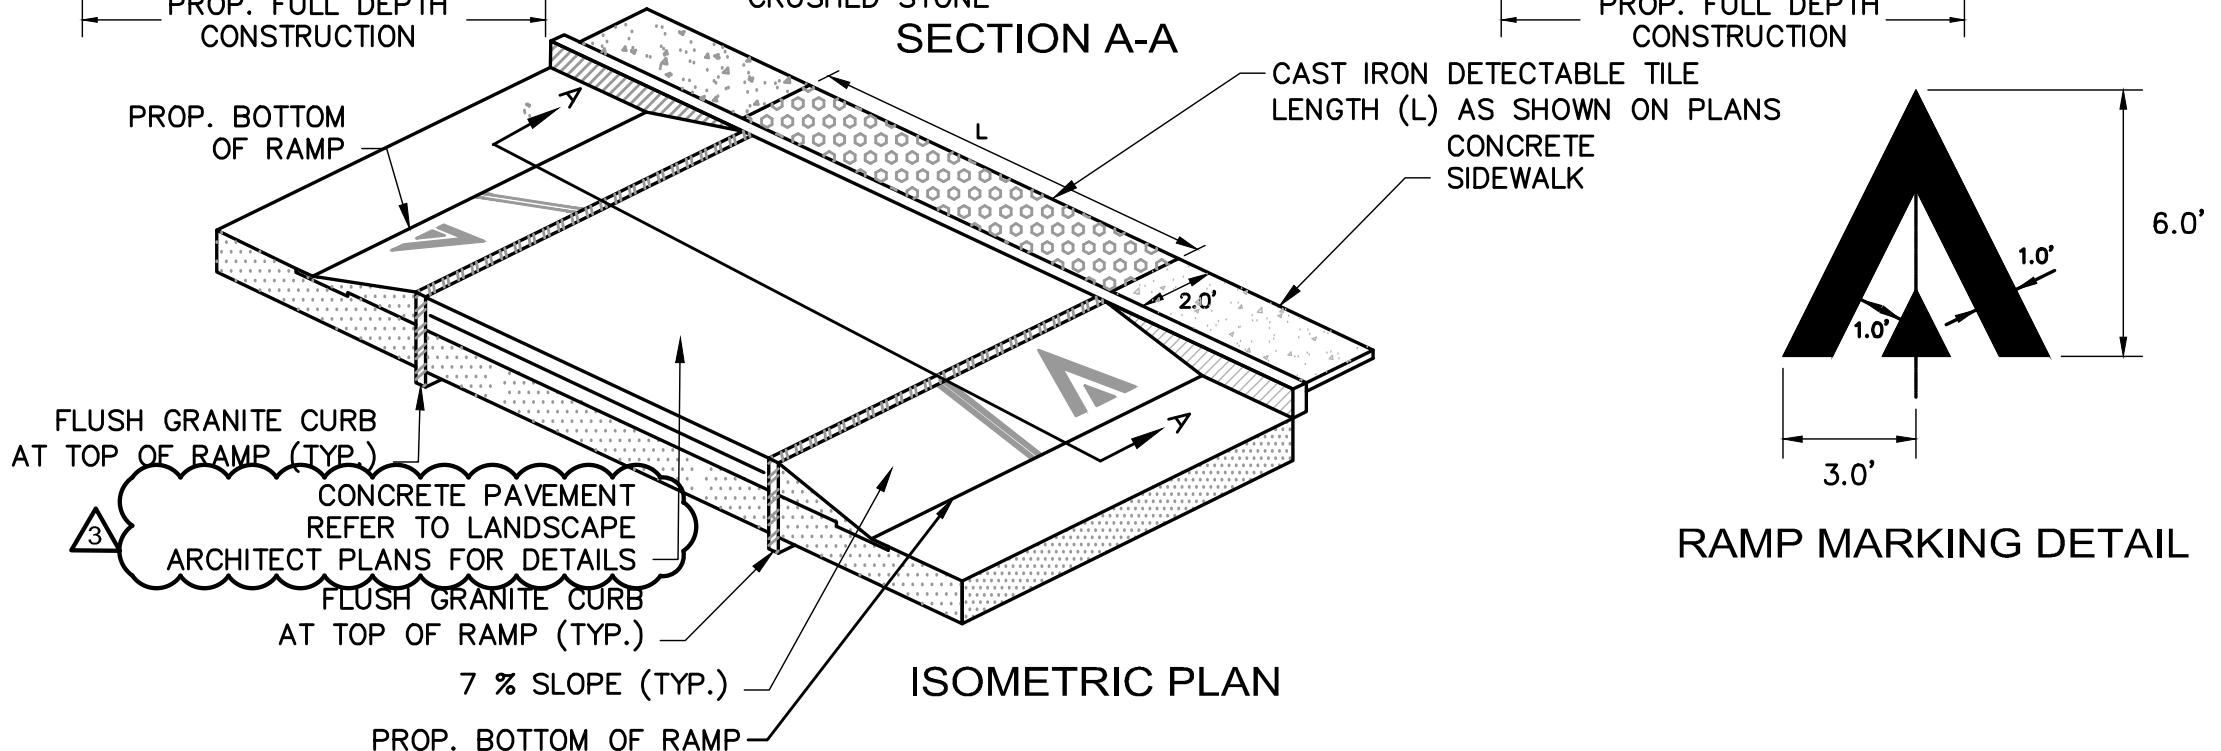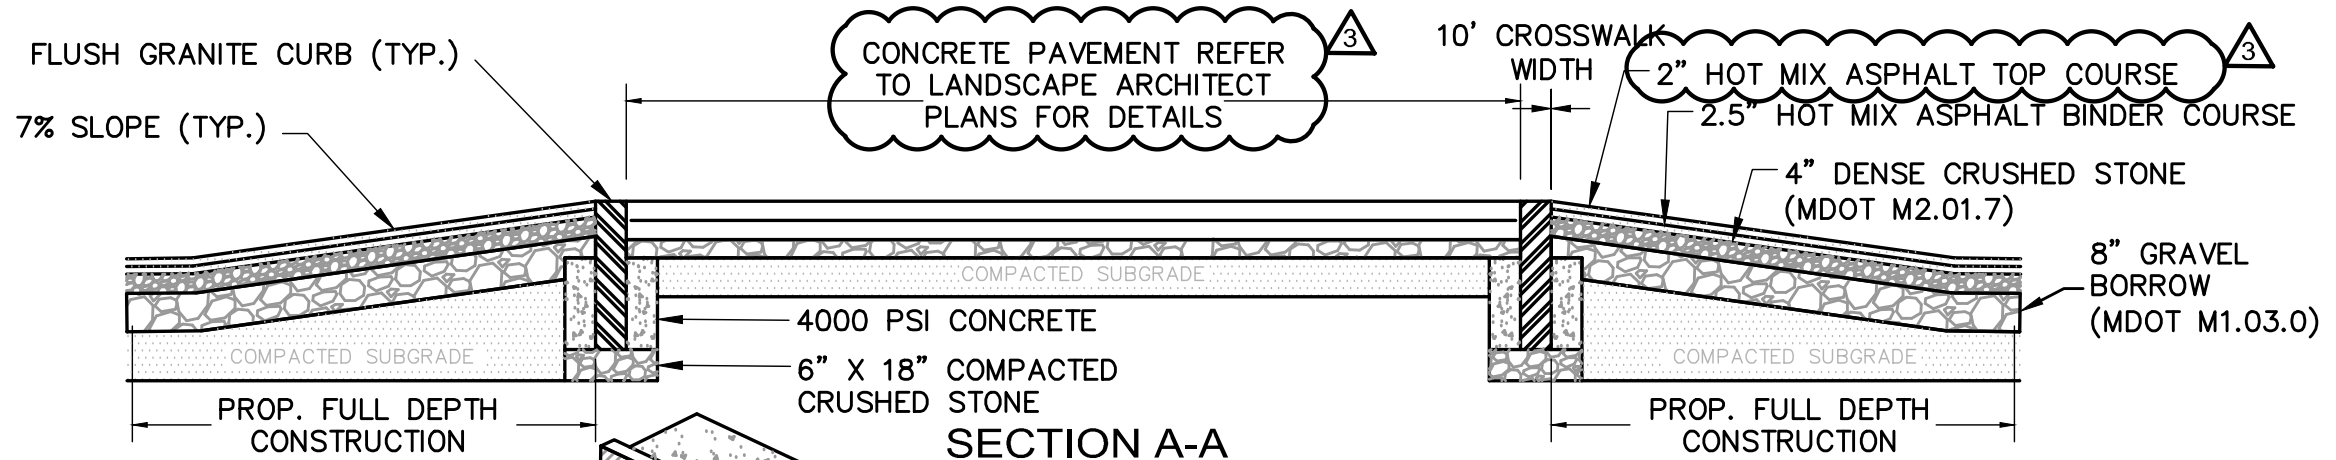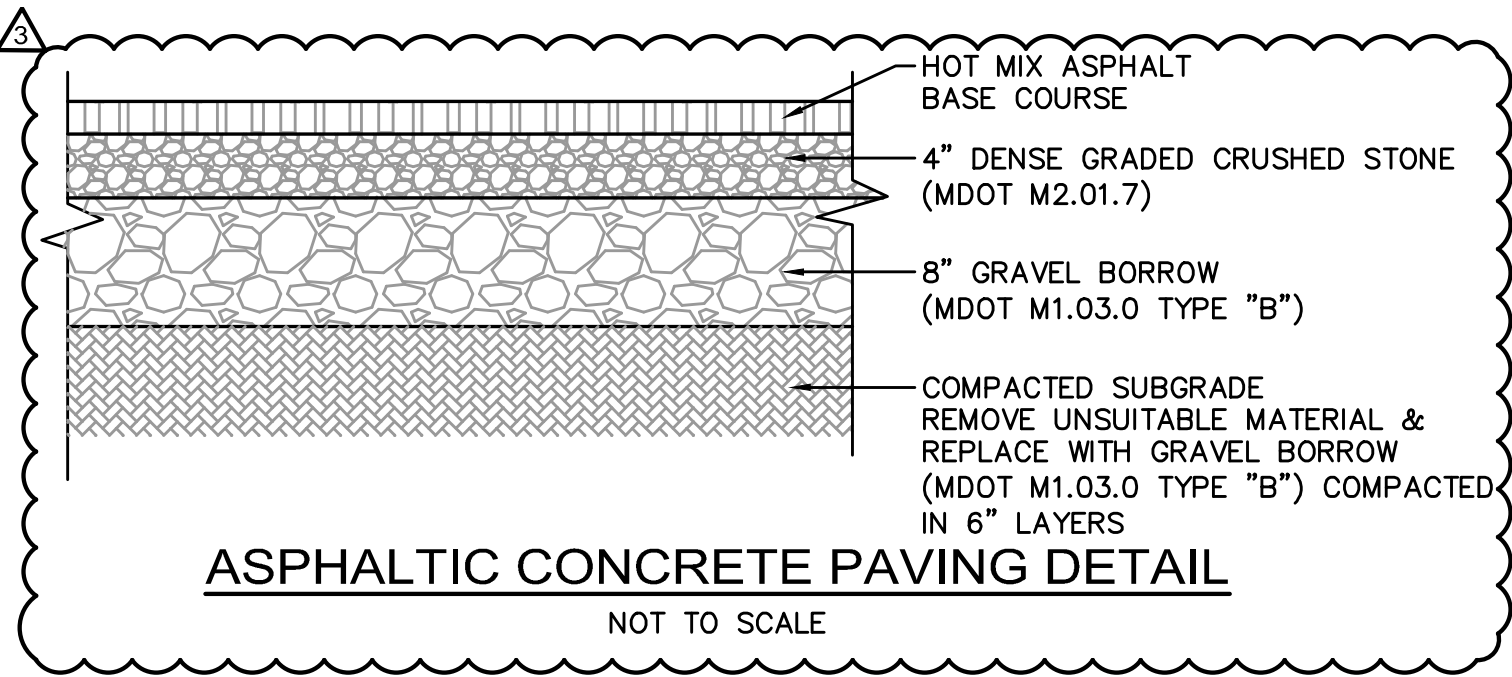

MID-BLOCK RAISED CROSSWALK DETAIL
NOT TO SCALE

SHEET REF. NO. C11.5
DRAWING NAME: Civil Detail Sketch
DRAWING NUMBER: ADD-3
DATE: 09/17/18
SCALE: NTS
C-024

EARLY SITE BID PACKAGE #2

South High Community School

170 Apricot Street, Worcester, MA 01603

CLIENT INFORMATION:
Worcester Public Schools




City of Worcester
Massachusetts, 01605






LAMOURTUS PAGANO
ASSOCIATES ARCHITECTS
108 COLE & BEEKS SUITE 400
WORCESTER, MASSACHUSETTS 01605


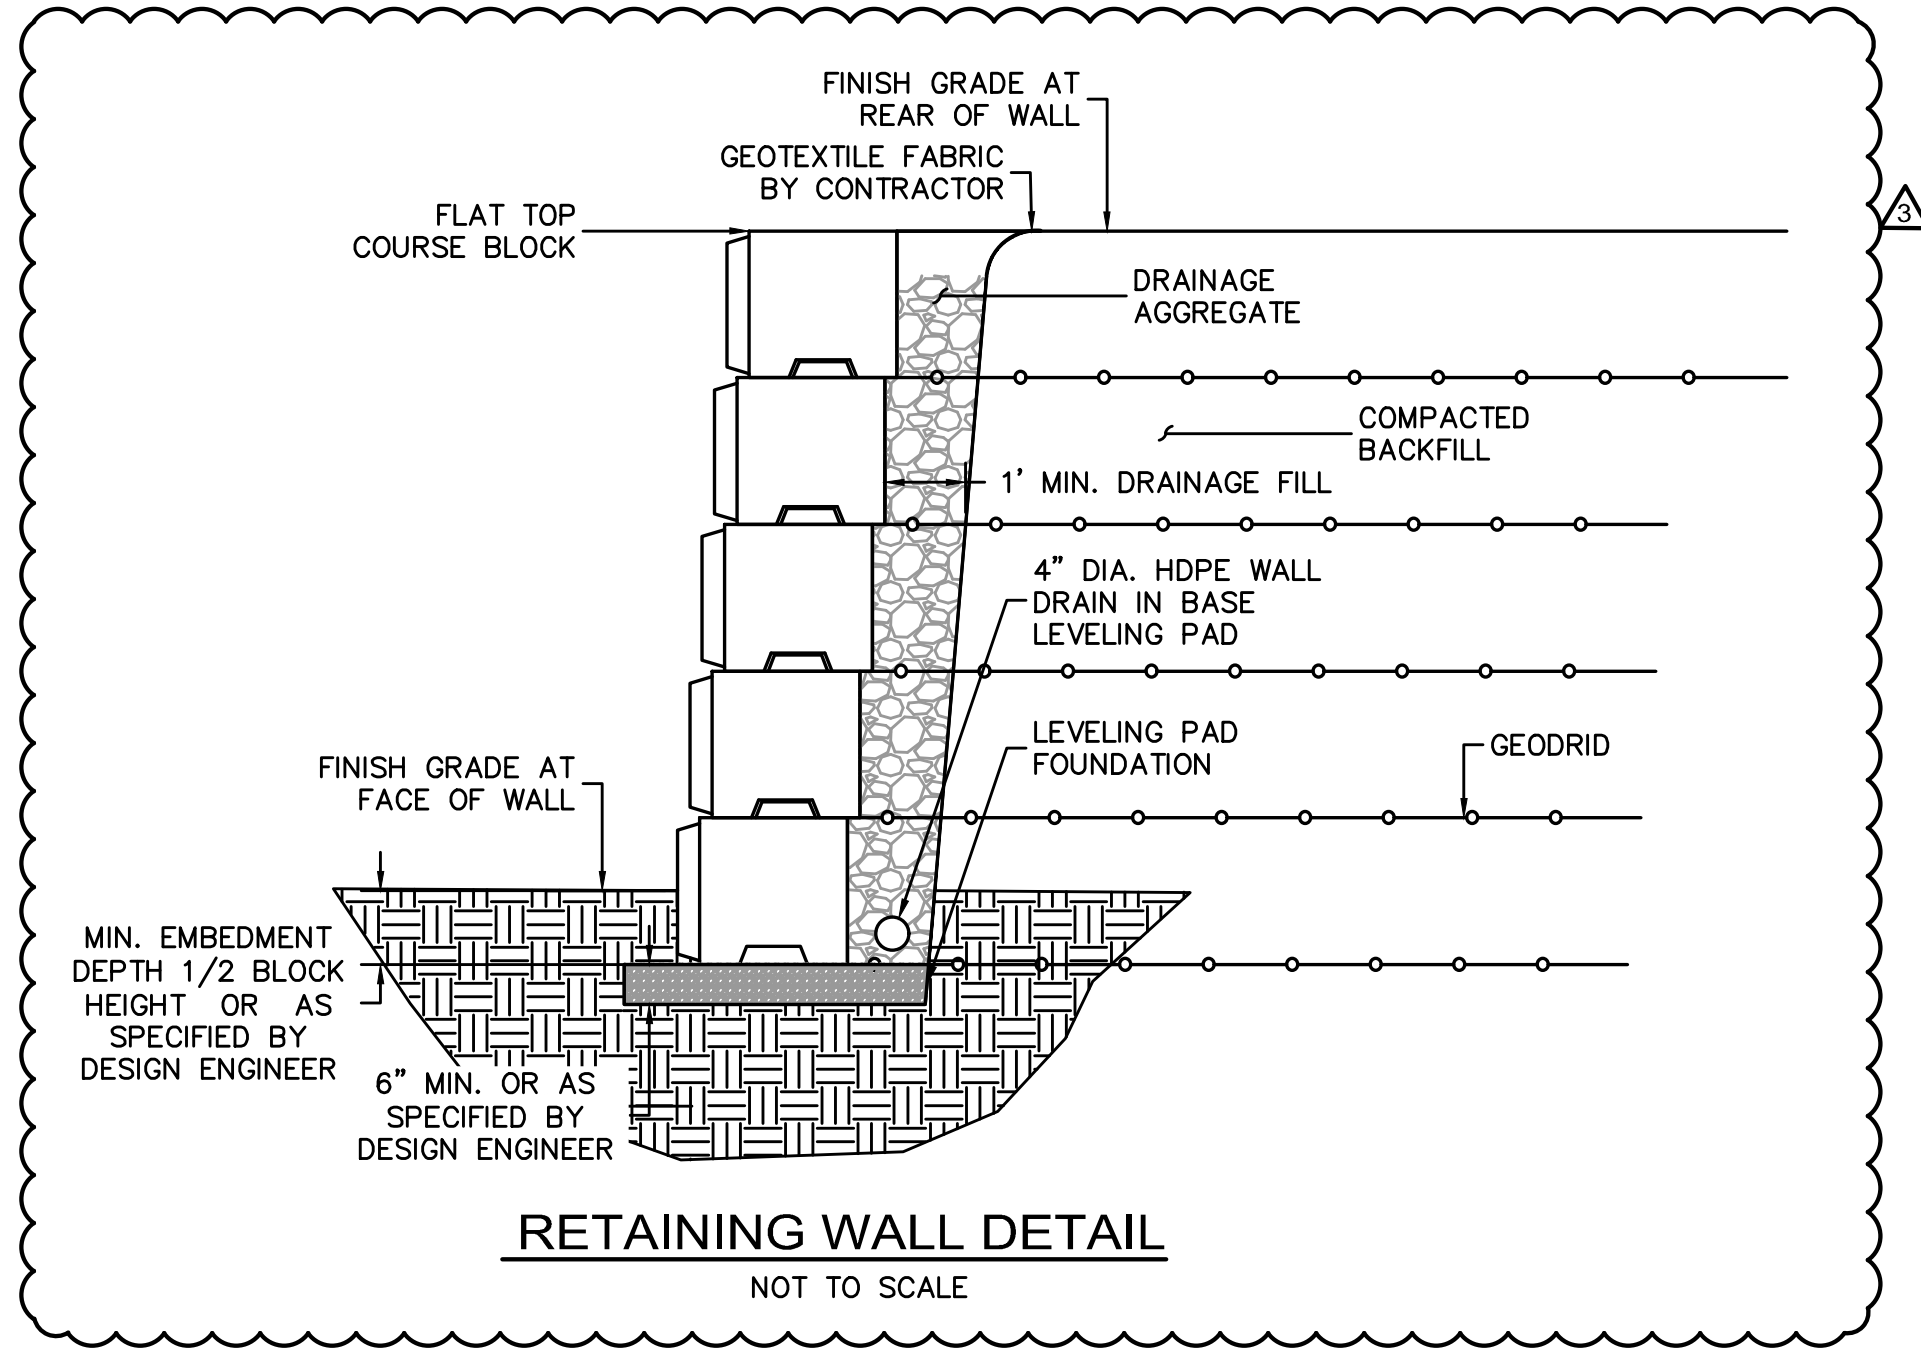
MEMBER OF
THE AMERICAN INSTITUTE OF ARCHITECTS

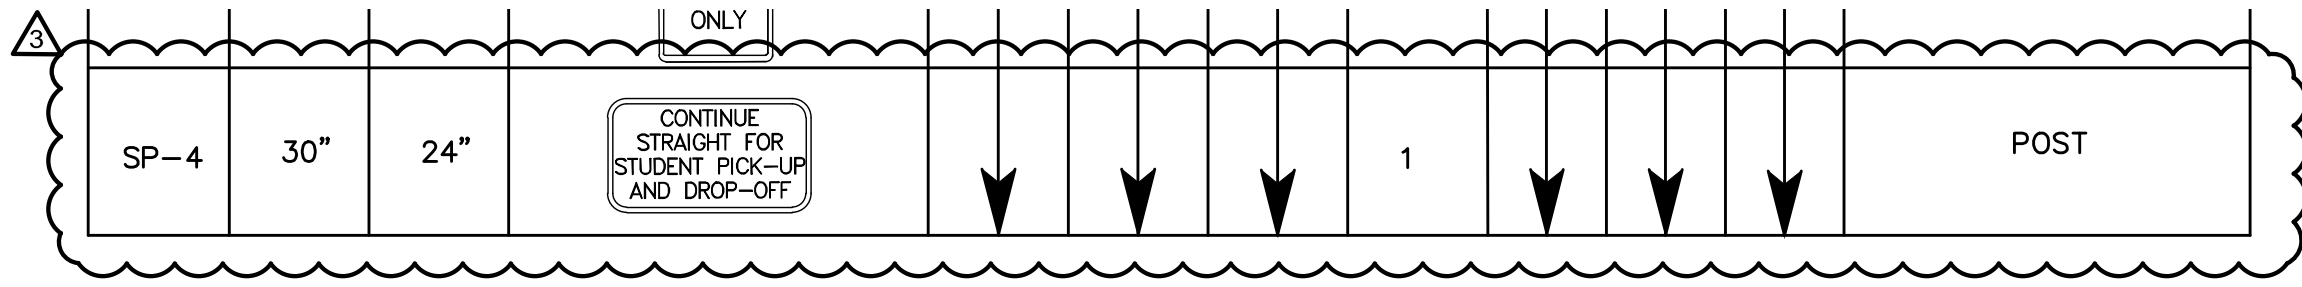

RETAINING WALL DETAIL
NOT TO SCALE




SHEET REF. NO. C11.6	DRAWING NAME: Civil Detail Sketch	DRAWING NUMBER: ADD-3 C-025
PROJECT TITLE: EARLY SITE BID PACKAGE #2 South High Community School 170 Apricot Street, Worcester, MA 01603		
CLIENT INFORMATION: Worcester Public Schools	 City of Worcester Massachusetts, 01605	 LAMORTIUS PAGANO ASSOCIATES ARCHITECTS 178 GLOBE STREET, SUITE 400 WORCESTER, MASSACHUSETTS 01605

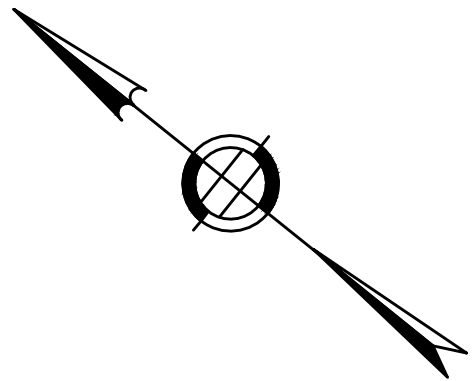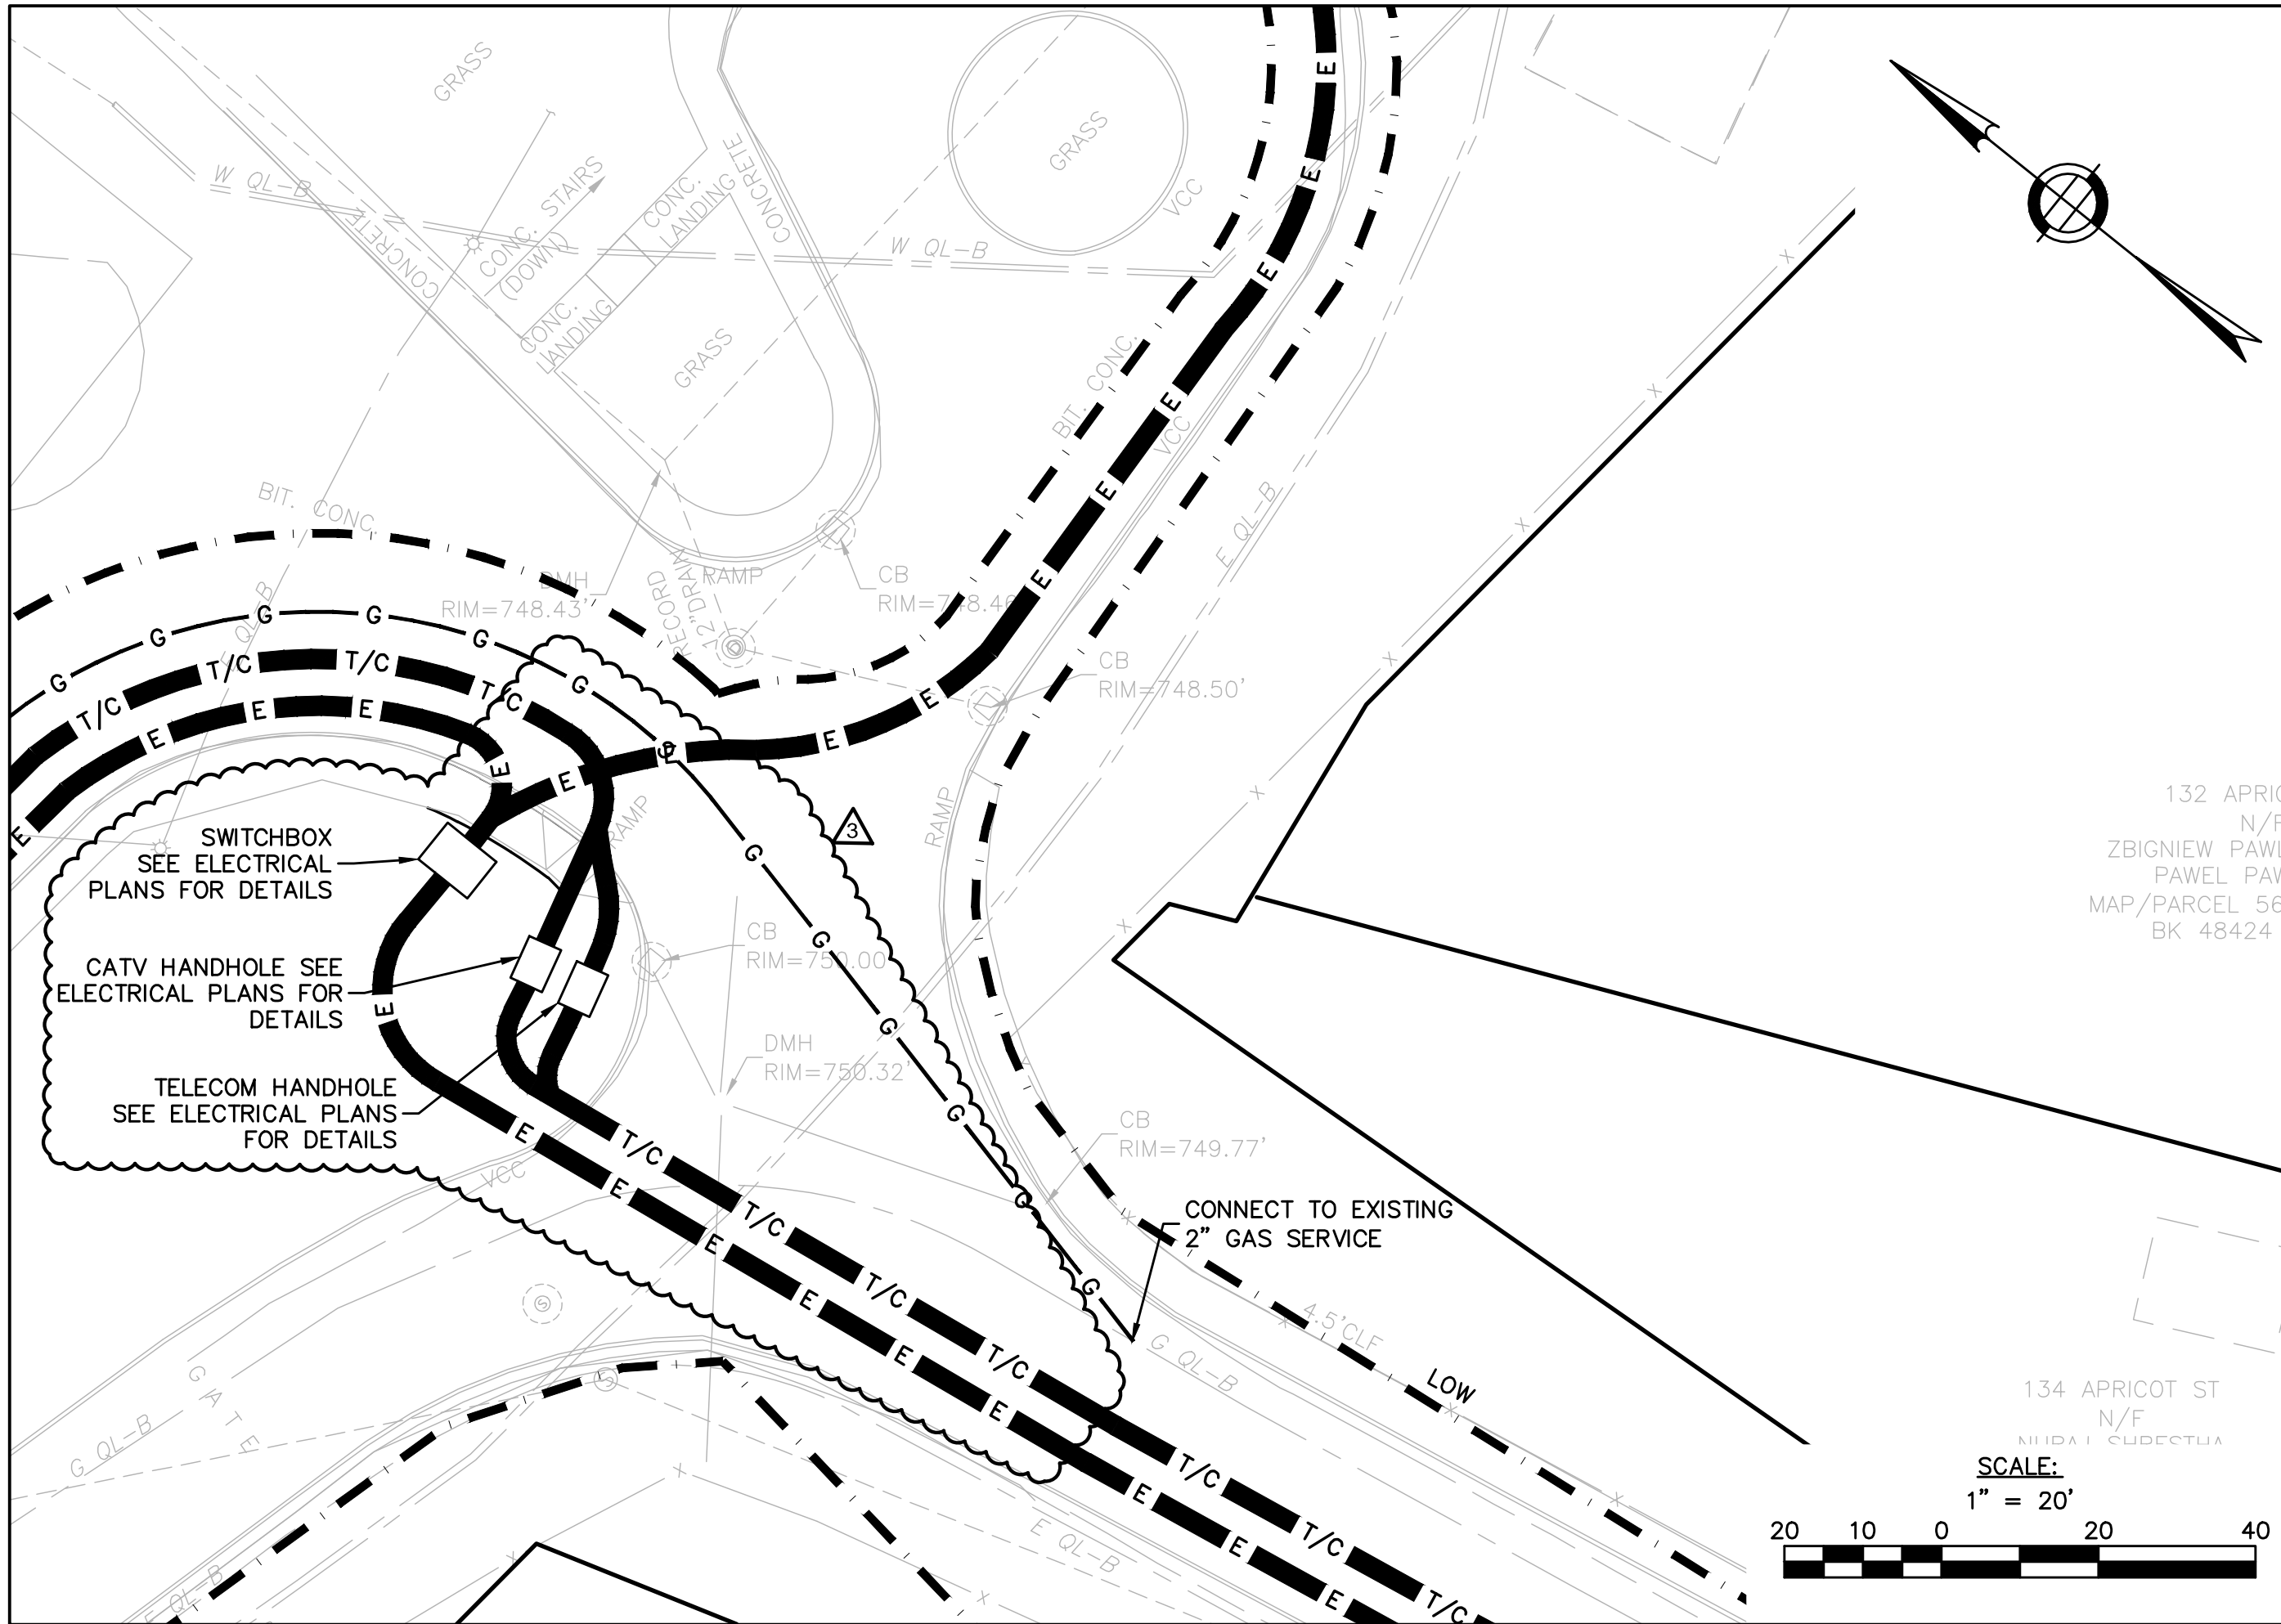

132 APRICOT ST
N/F
ZBIGNIEW PAWLAK
PAWEL PAWLAK
MAP/PARCEL 56-01
BK 48424

134 APRICOT ST
N/F
NIIDA I SUBECTUA

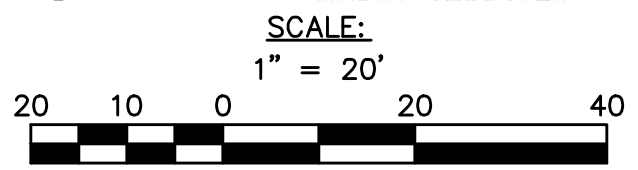

DRAWING NAME: Site Utility Plan Sketch	SHEET REF. NO. C8.3
	DRAWING NUMBER: ADD-3 C-026
DATE: 09/17/18	SCALE: 1"=20'


PROJECT TITLE:
EARLY SITE BID PACKAGE #2

South High Community School
170 Apricot Street, Worcester, MA 01603

CLIENT INFORMATION:
Worcester Public Schools

City of Worcester
Massachusetts, 01605

MEMBER OF
THE AMERICAN INSTITUTE OF ARCHITECTS

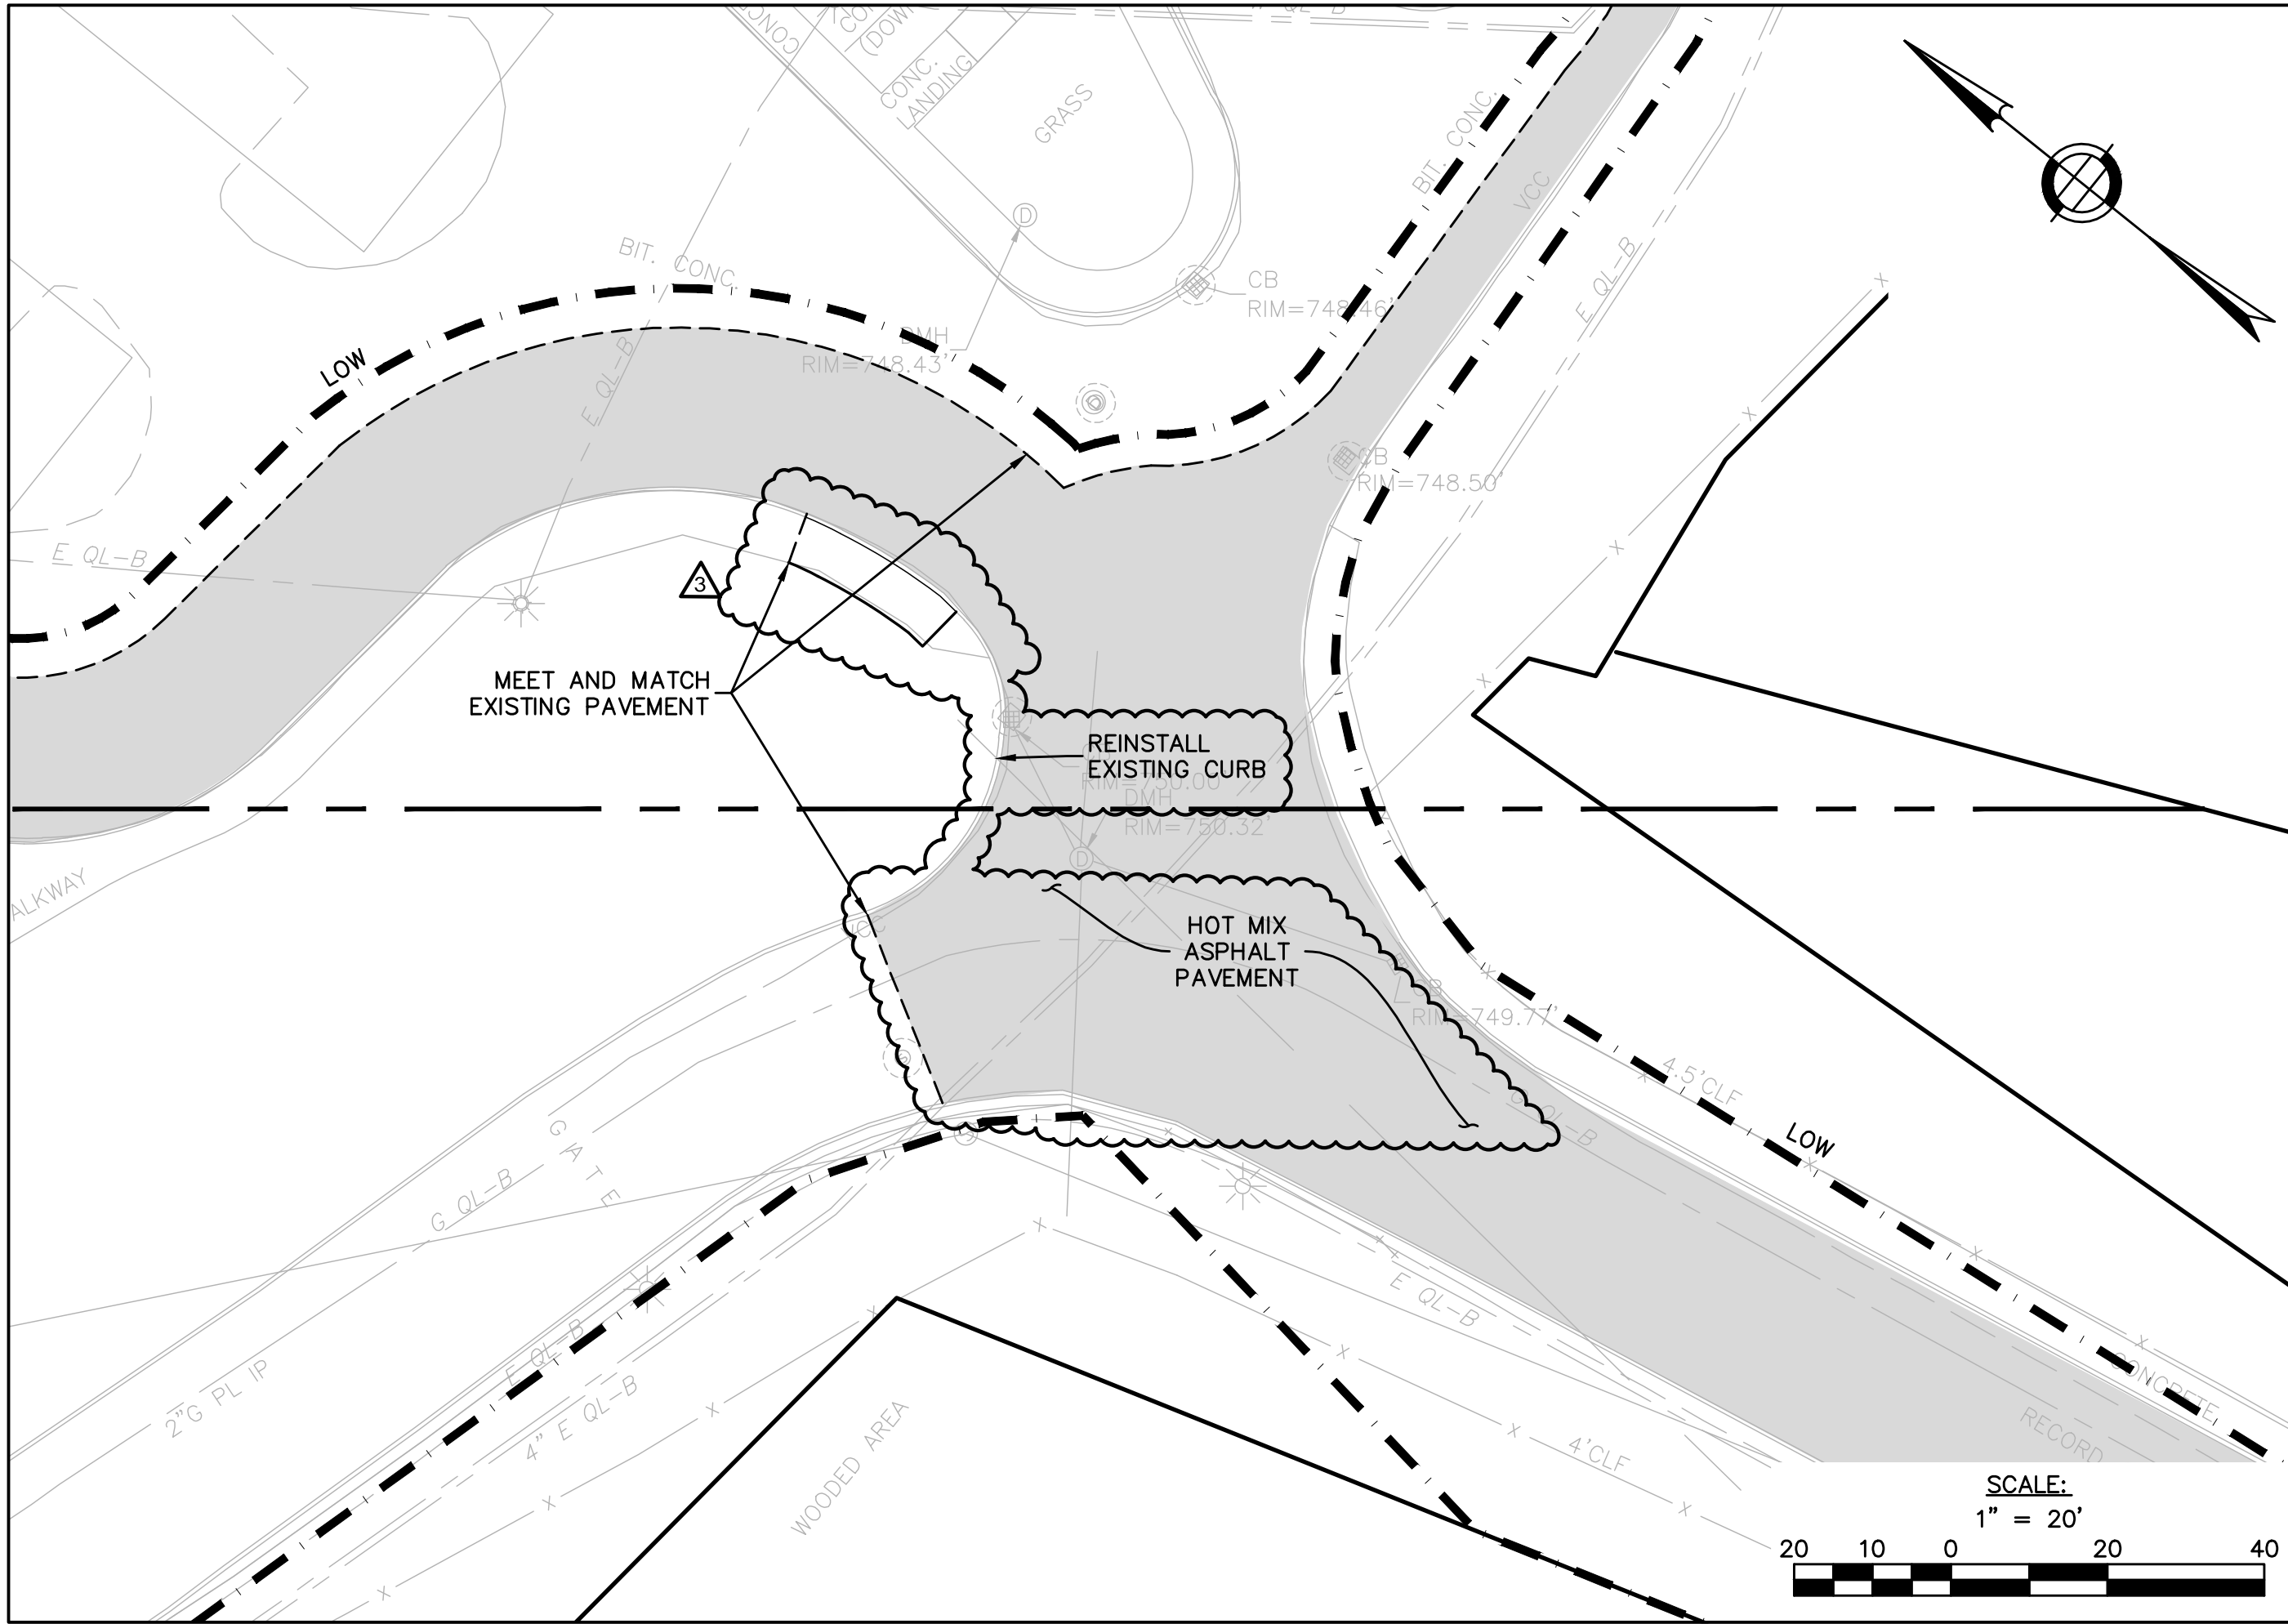

SHEET REF. NO. C5.3

DRAWING NAME: Roadway Layout and Materials Plan Sketch

DATE: 09/17/18

SCALE: As Noted

DRAWING NUMBER: ADD-3
C-027

PROJECT TITLE: EARLY SITE BID PACKAGE #2

South High Community School


170 Apricot Street, Worcester, MA 01603

CLIENT INFORMATION: Worcester Public Schools



LAMOUROUX PAGANO ASSOCIATES, ARCHITECTS
108 GROVE STREET, SUITE 200
WORCESTER, MASSACHUSETTS 01605

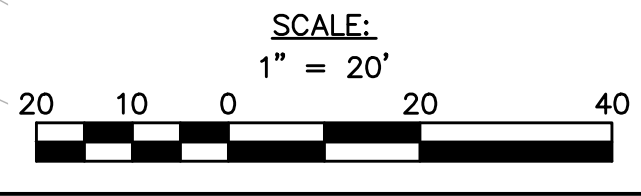


THE AMERICAN INSTITUTE OF ARCHITECTS




SITE DEMOLITION NOTES:

1. SITE DEMOLITION, SITE LAYOUT, AND SITE UTILITY SYSTEMS ARE SHOWN FOR COMPLETE CONSTRUCTION PERIOD. REFER TO PROJECT PHASING PLAN FOR SEQUENCE OF SITE DEMOLITION AND CONSTRUCTION ELEMENTS, AND MATERIALS AND ACCESS MAINTENANCE/PROTECTION REQUIREMENTS DURING VARIOUS PROJECT PHASES
2. REFER TO ENABLING PHASE BID PACKAGE FOR COMPLETED WORK TO BE DEMOLISHED

SITE DEMOLITION LEGEND

-  REMOVE AND DISPOSE OF ASPHALT PAVEMENT, CURB, CONCRETE PAVEMENT, STAIRS, AND WALLS
-  REMOVE AND DISPOSE OF TREE
-  EXISTING UTILITY TO BE ABANDONED, REMOVED AND DISPOSED OF IF IN CONFLICT WITH NEW SITE IMPROVEMENTS, OR AS INDICATED ON DRAWINGS

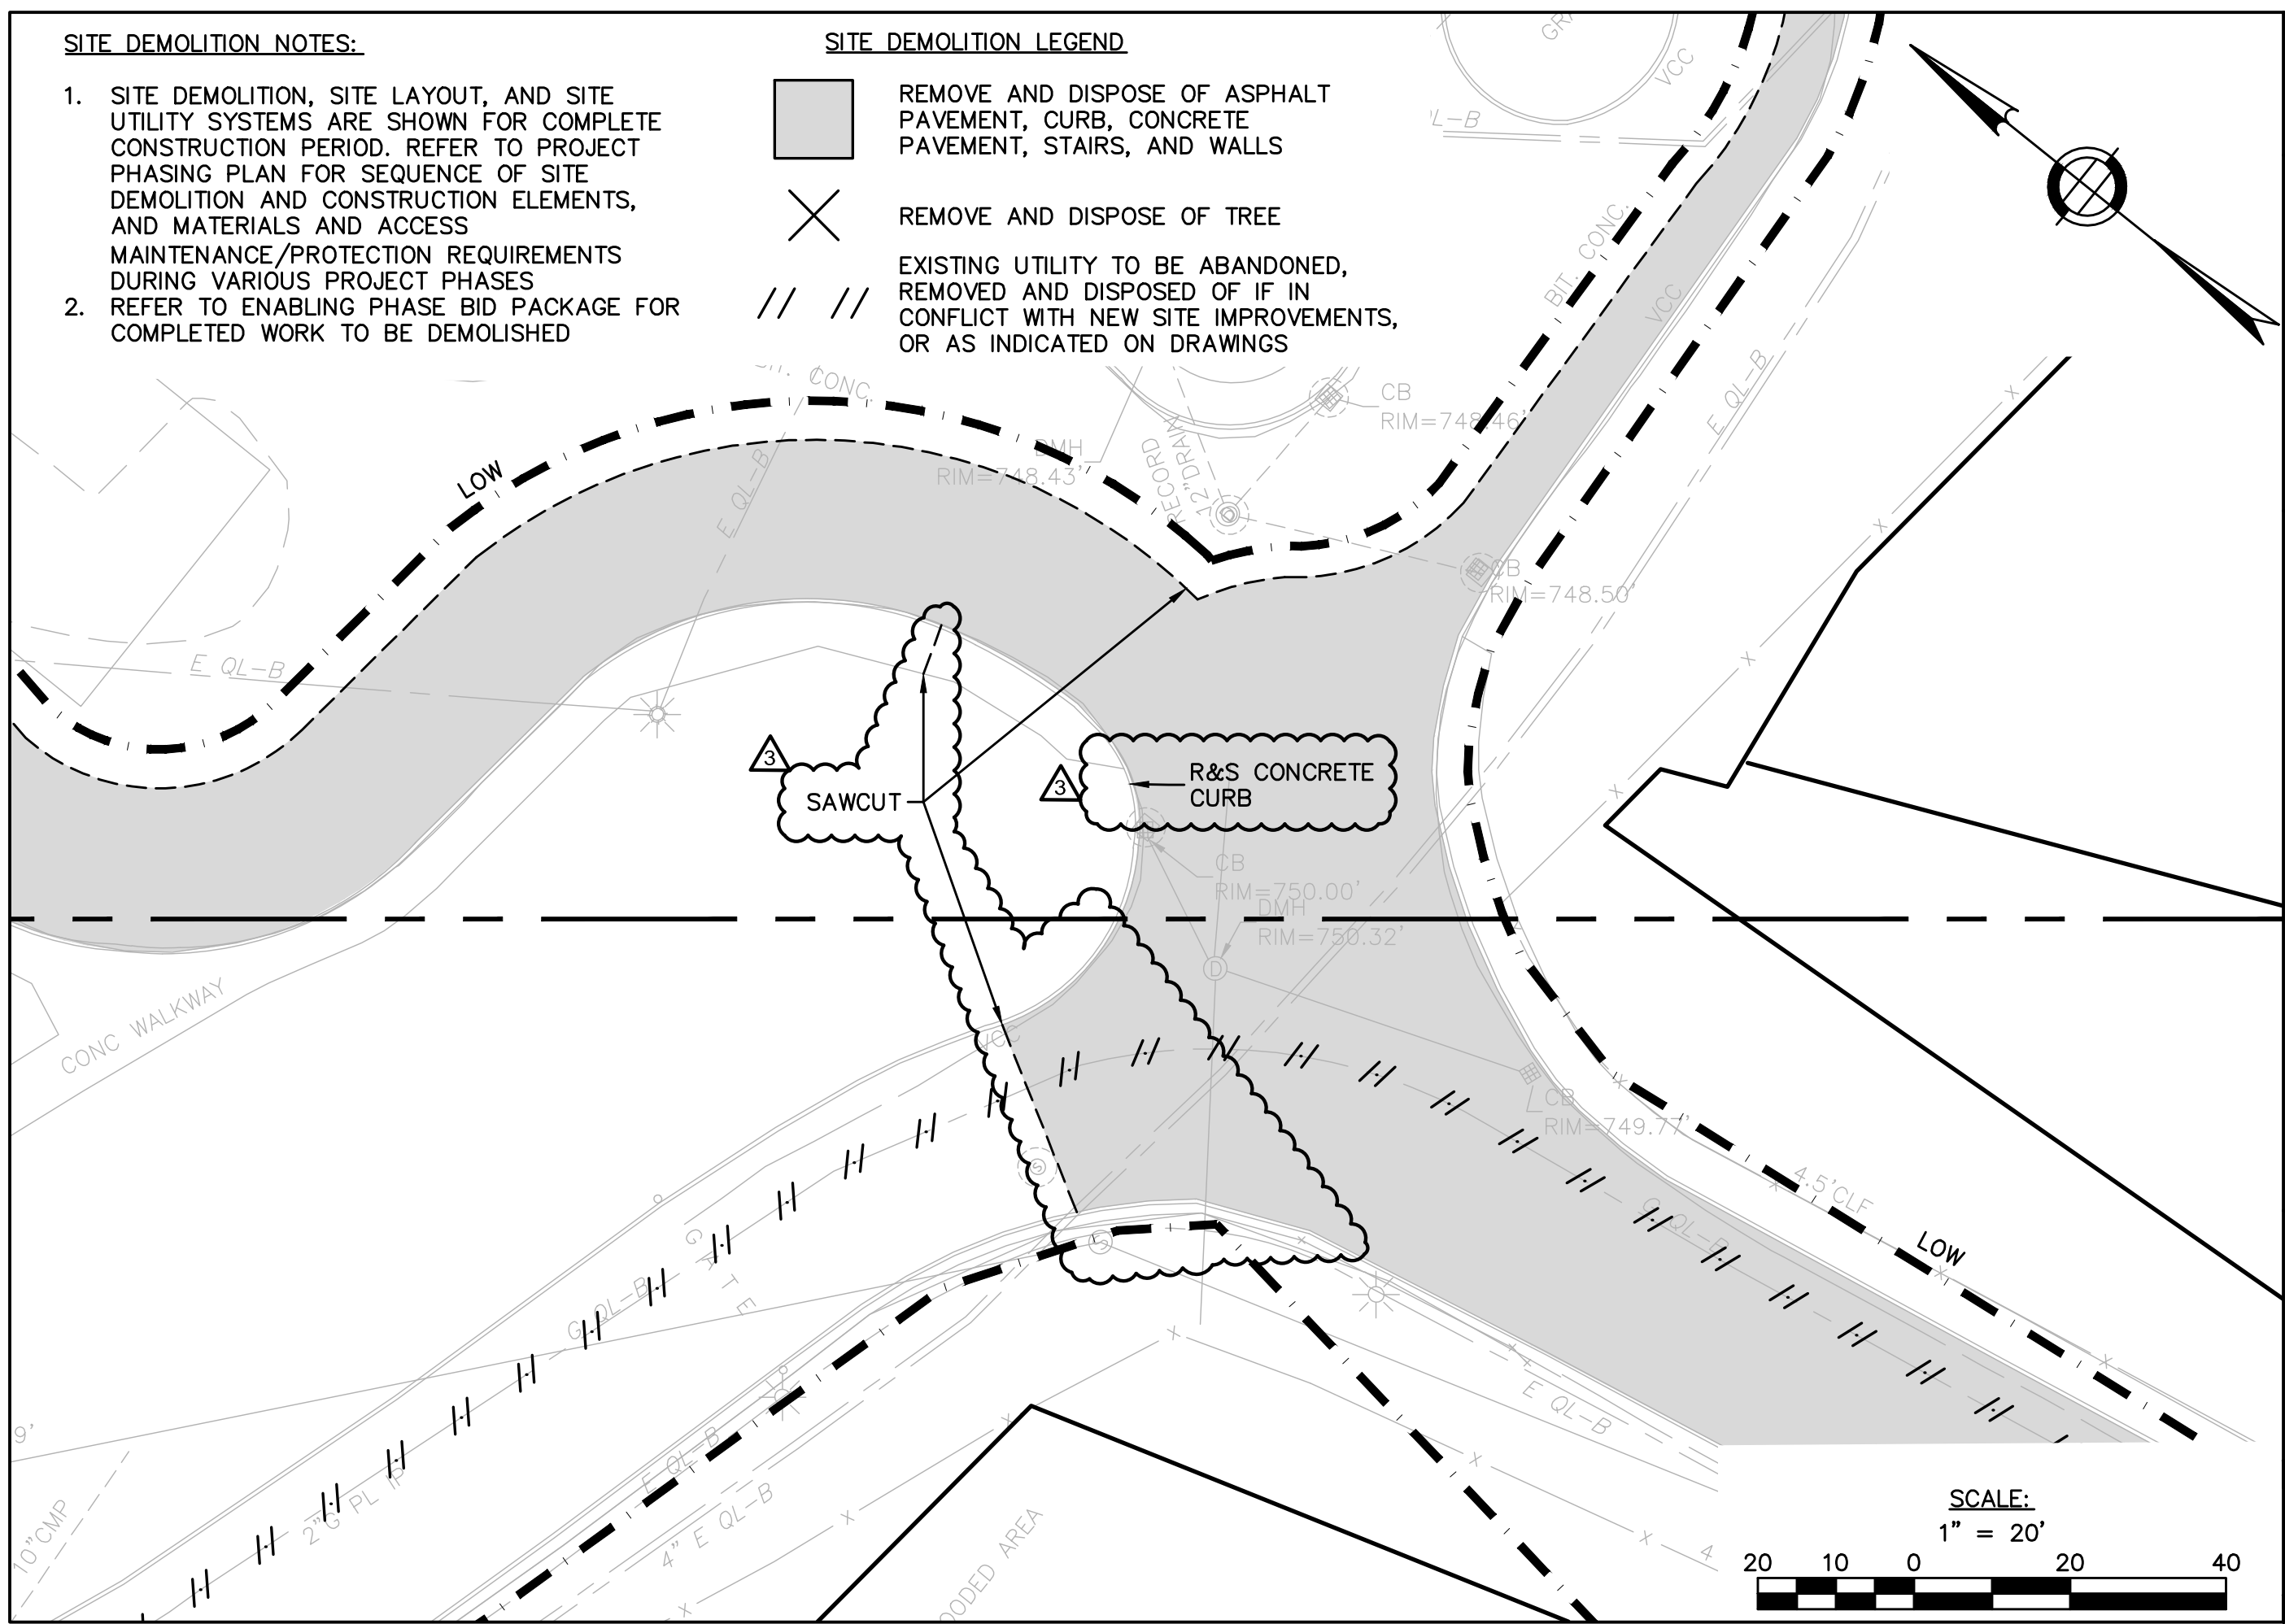

DRAWING NUMBER: ADD-3 C-028	SHEET REF. NO. C3.3
	DRAWING NAME: Site Demolition Plan Sketch
DATE: 09/17/18	SCALE: AS NOTED


PROJECT TITLE:
EARLY SITE BID PACKAGE #2

South High Community School
170 Apricot Street, Worcester, MA 01603

CLIENT INFORMATION:
Worcester Public Schools




City of Worcester
Massachusetts, 01605



LAMOREUX, PAGANO
ASSOCIATES, ARCHITECTS
100 GUYE STREET, SUITE 200
WORCESTER, MASSACHUSETTS 01605

MEMBER OF
THE AMERICAN INSTITUTE OF ARCHITECTS

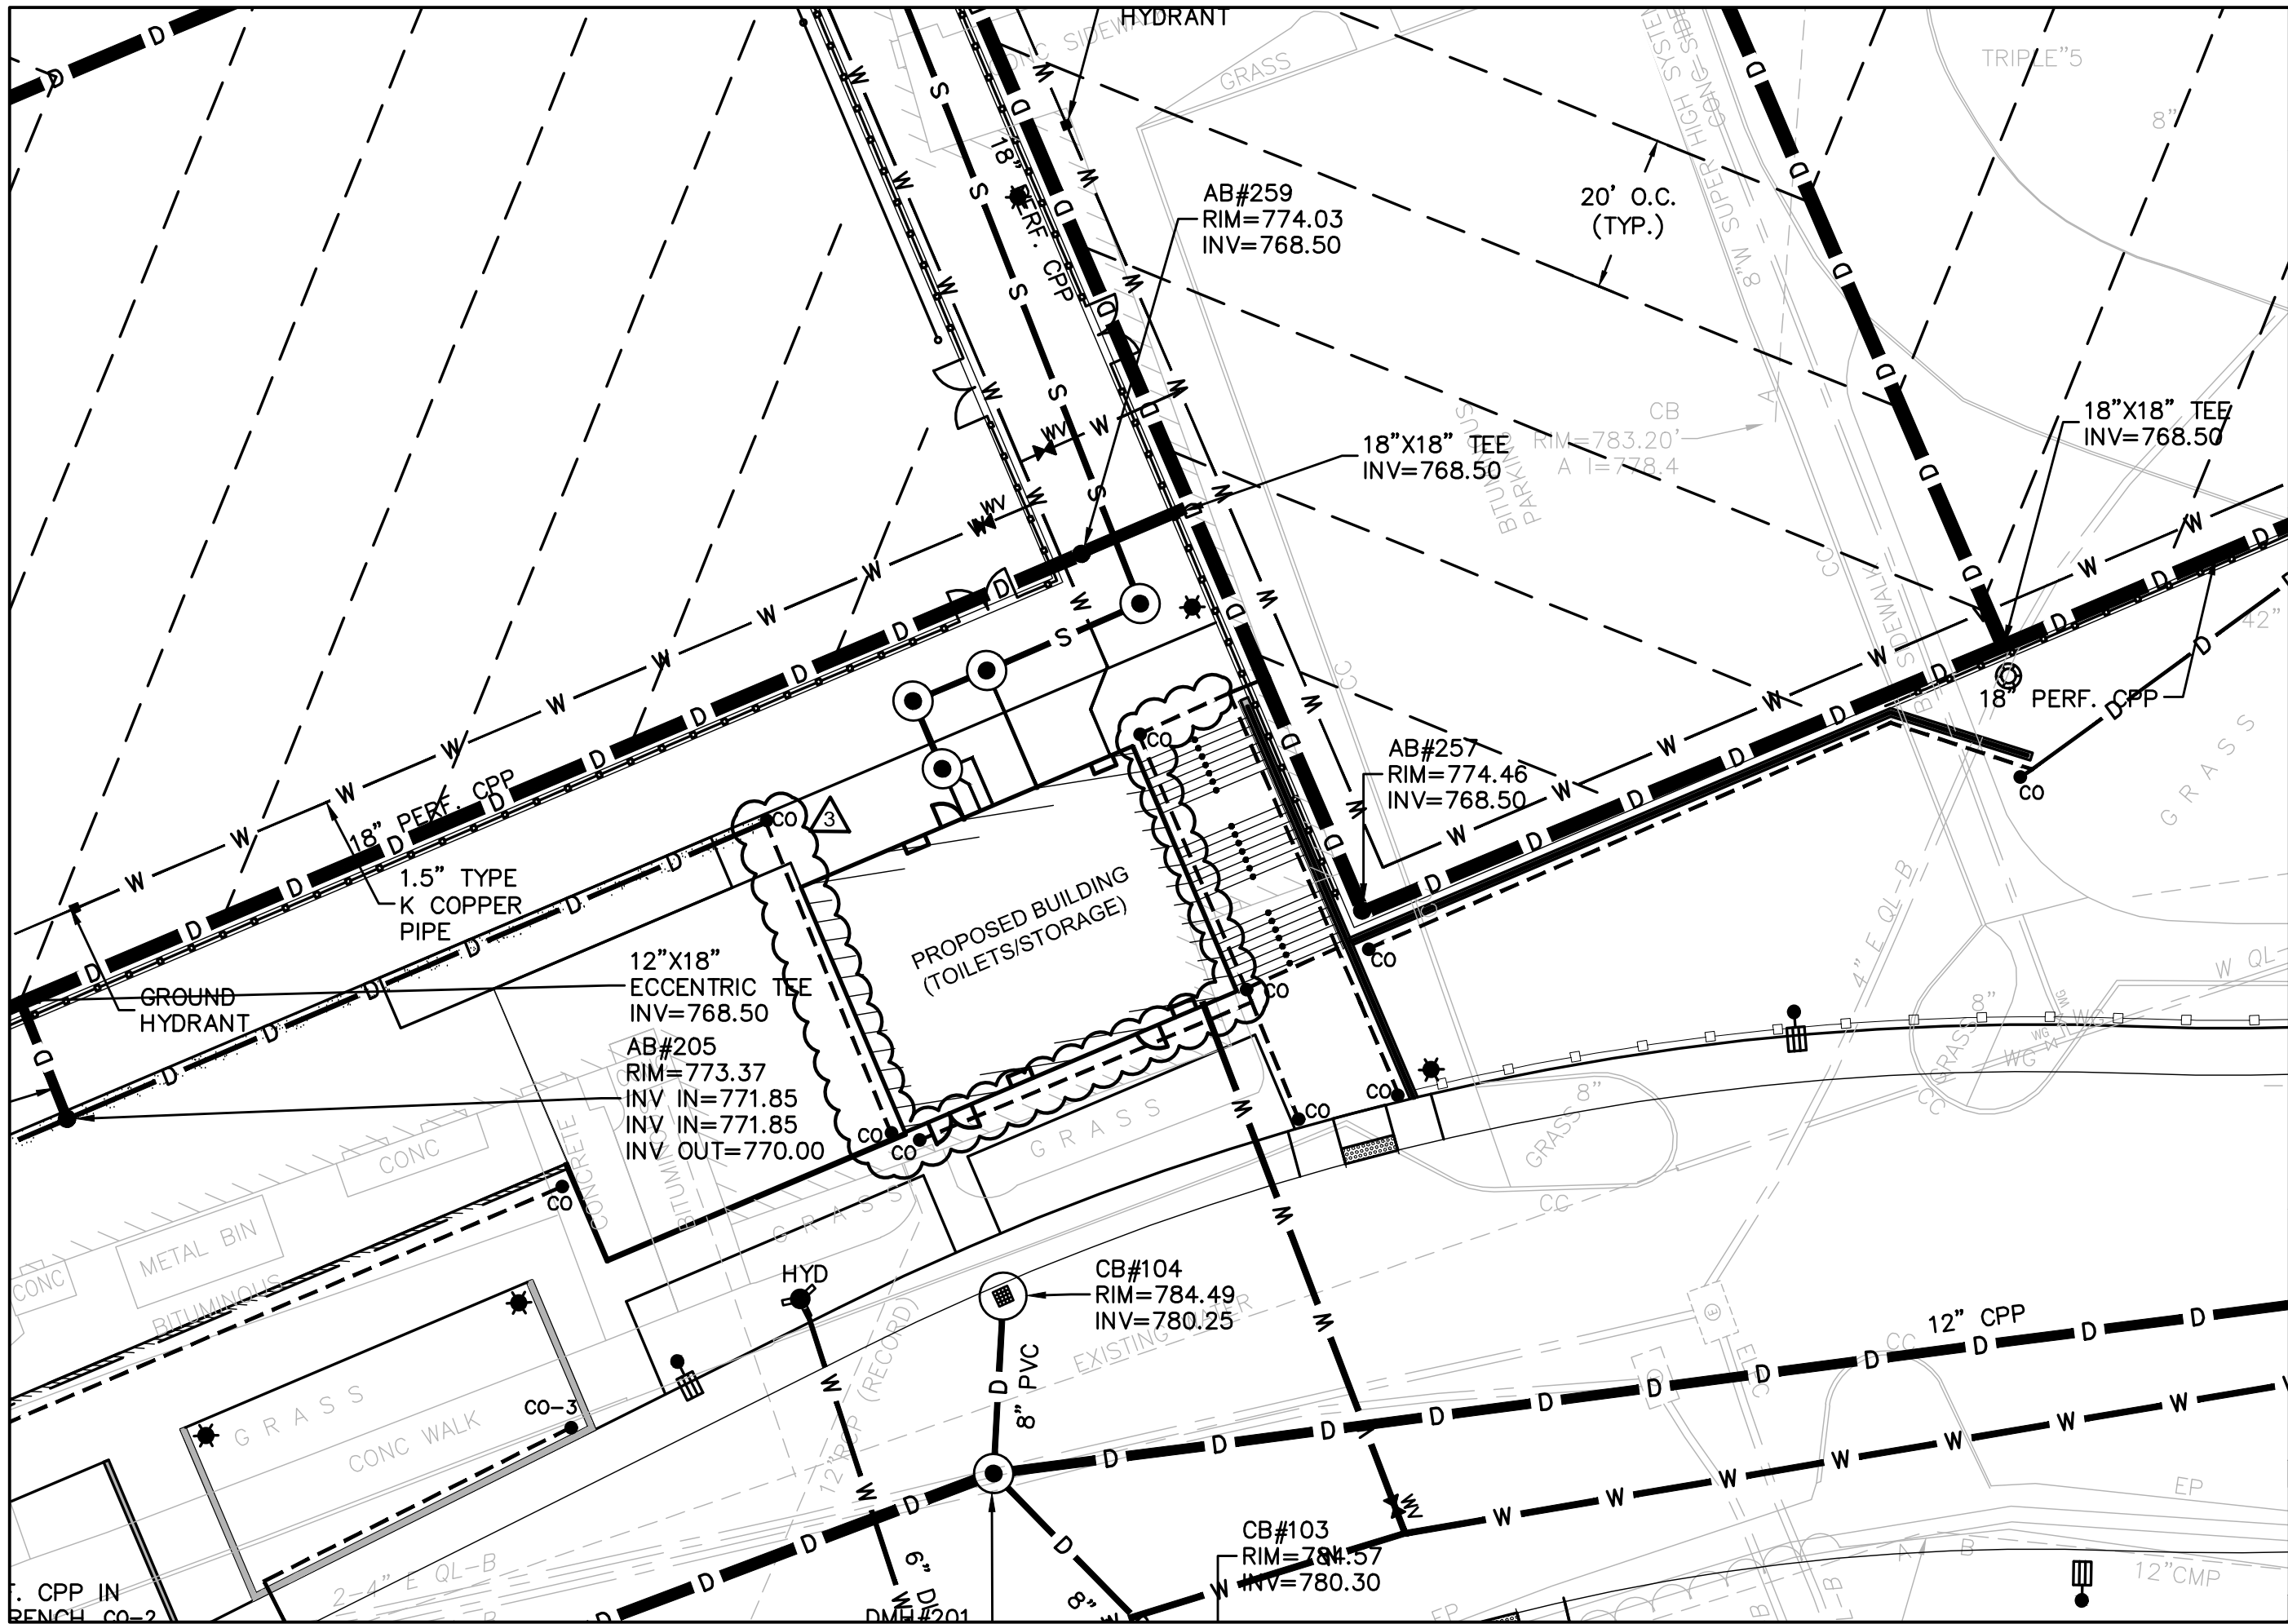


SHEET REF. NO.	C9.2
DRAWING NUMBER:	ADD-3 C-029
DATE:	09/17/18
SCALE:	1"=20'

DRAWING NAME:
Site Drainage Plan Sketch

PROJECT TITLE:
EARLY SITE BID PACKAGE #2
South High Community School

170 Apricot Street, Worcester, MA 01603

CLIENT INFORMATION:
Worcester Public Schools








City of Worcester
Massachusetts, 01603


MEMBER OF
THE AMERICAN INSTITUTE OF ARCHITECTS

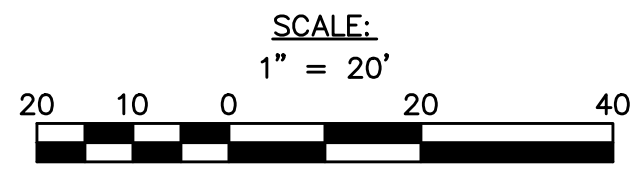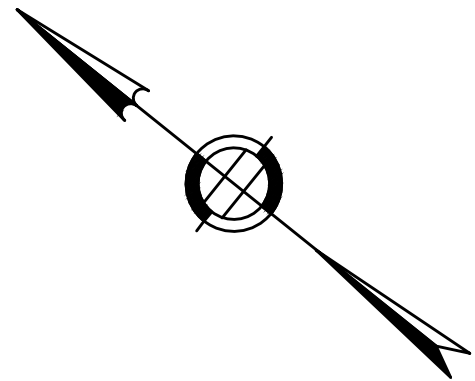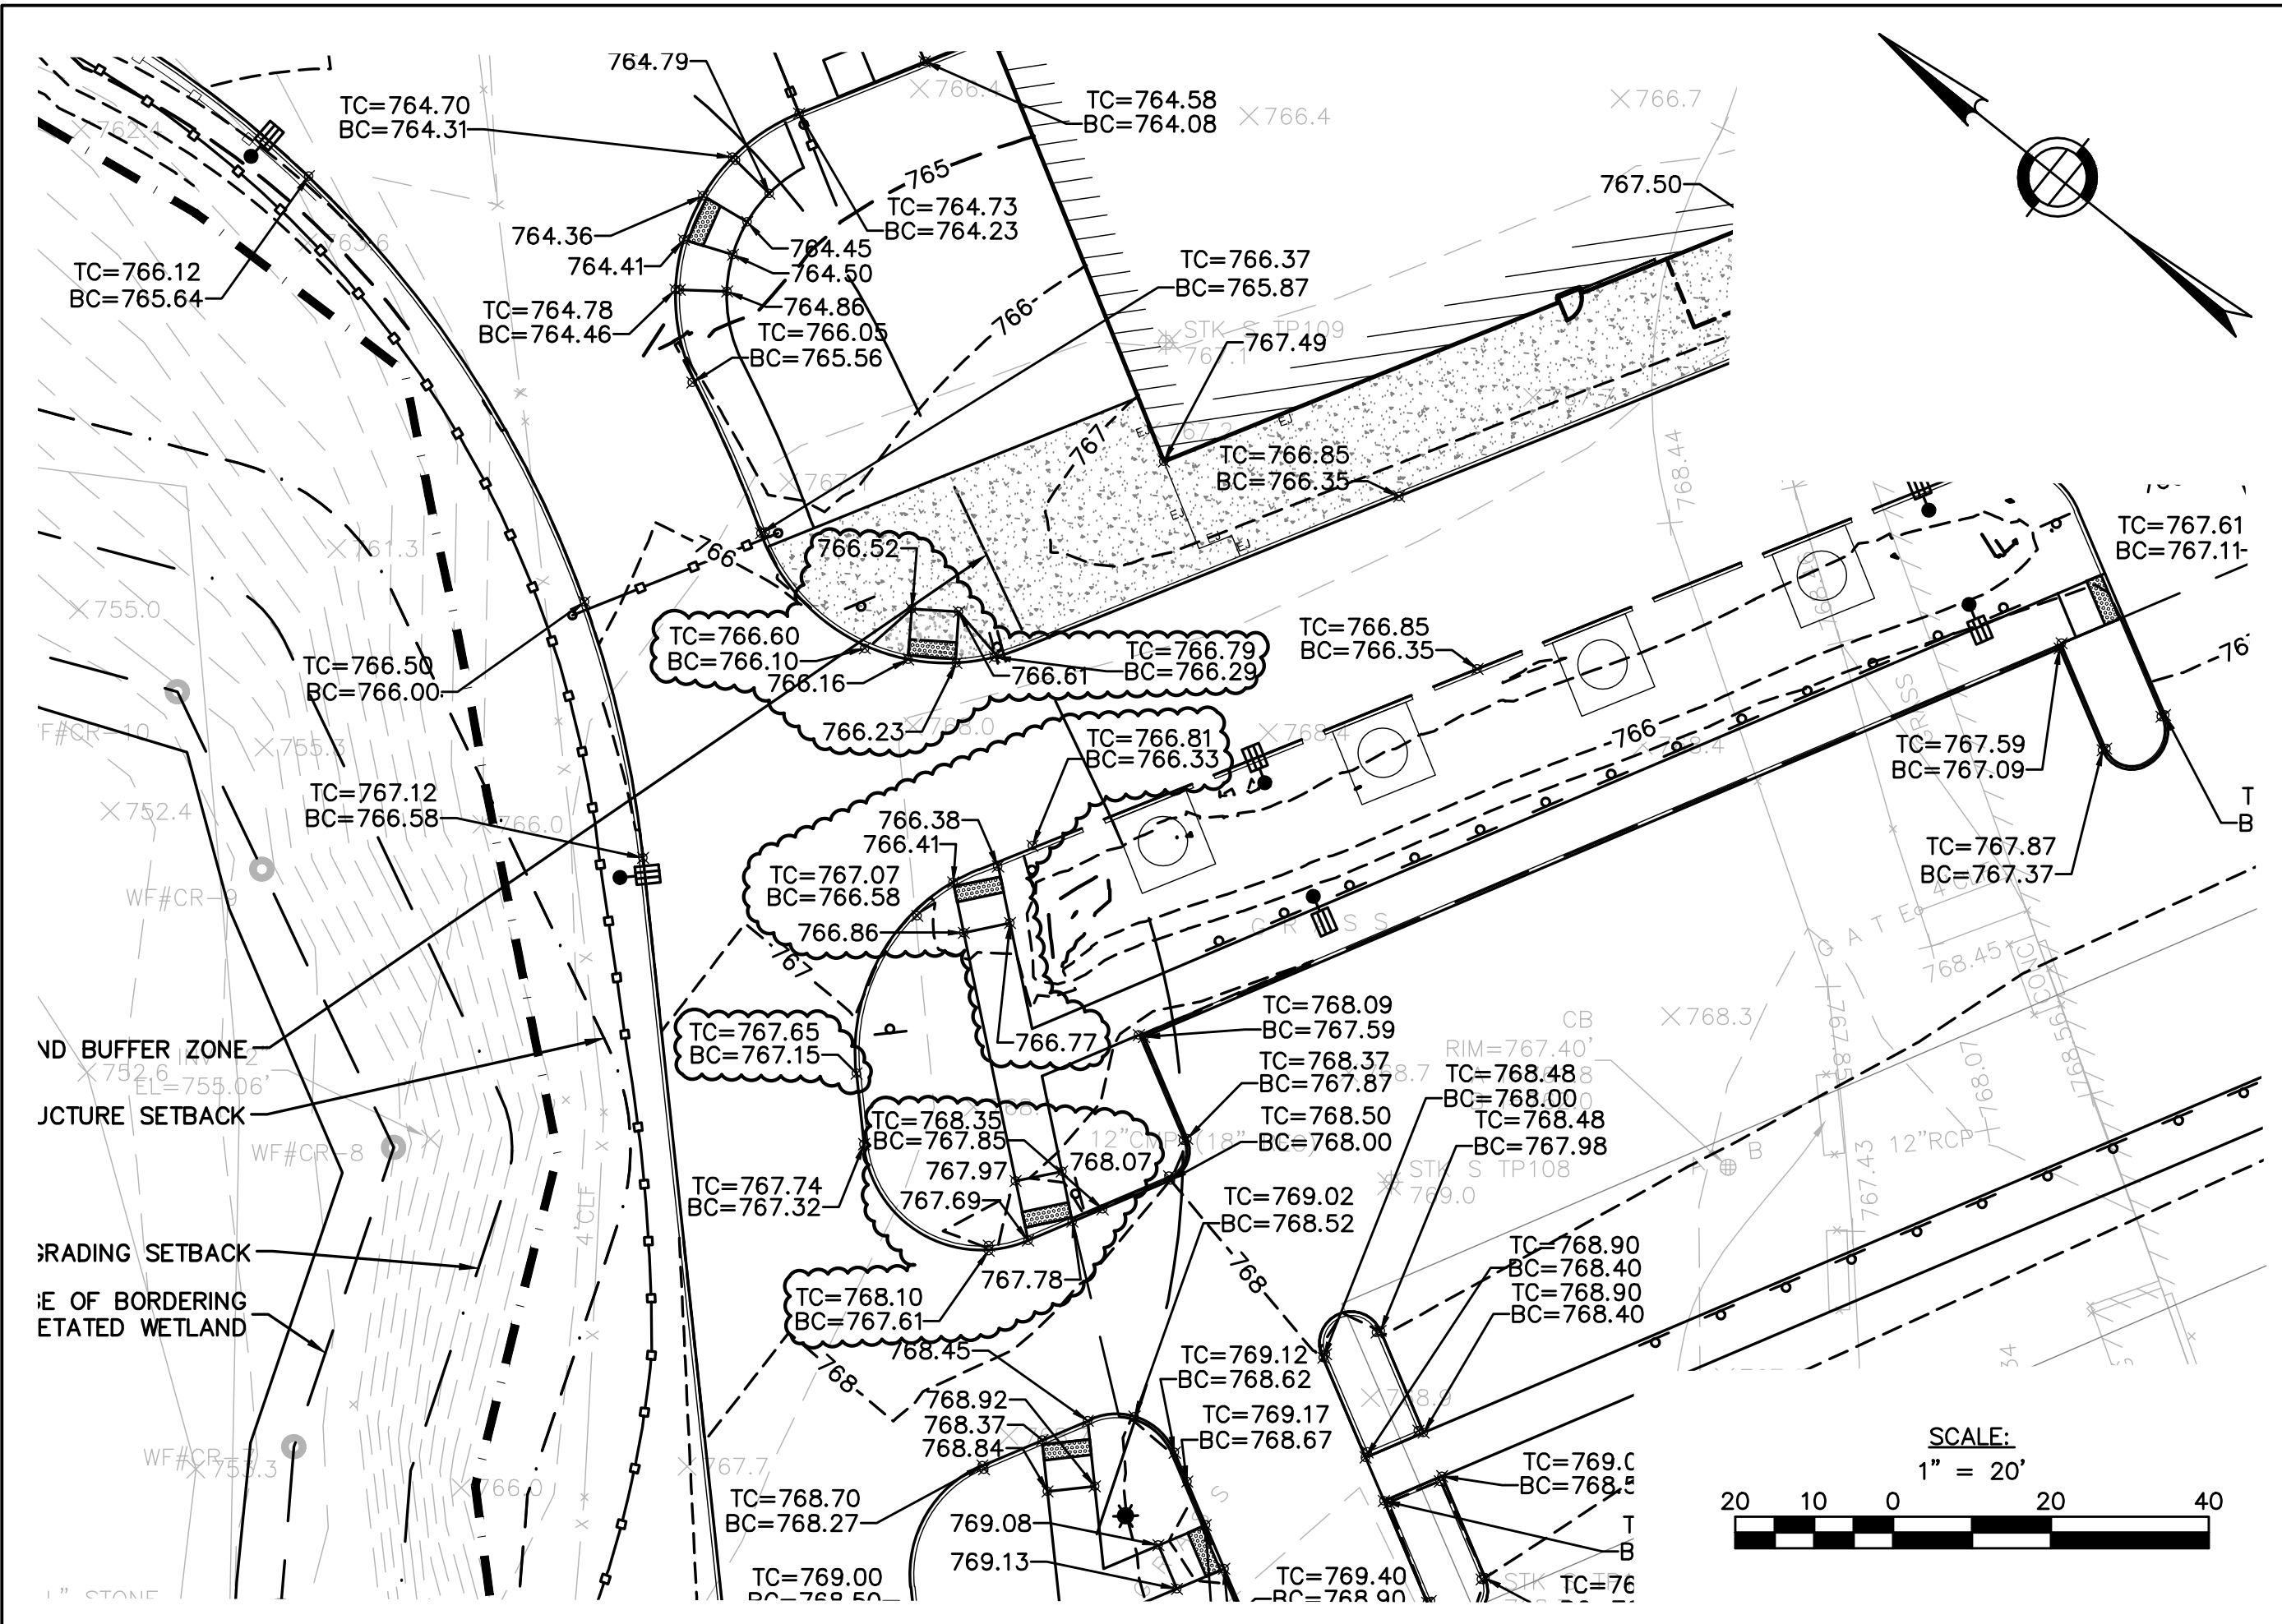

ASSOCIATES IN ARCHITECTURE
108 STATE STREET, SUITE 200
WORCESTER, MASSACHUSETTS 01603



DRAWING NAME: Civil Grading Plan Sketch	SHEET REF. NO. C7.0 & C7.1
	DRAWING NUMBER: ADD-3 C-030
DATE: 09/17/18	PROJECT TITLE: EARLY SITE BID PACKAGE #2 South High Community School 170 Apricot Street, Worcester, MA 01603
SCALE: As Noted	
CLIENT INFORMATION: Worcester Public Schools	 City of Worcester Massachusetts, 01605
 LAMOUREUX PAGANO ASSOCIATES, ARCHITECTS 100 GROVE STREET, SUITE 200 WORCESTER, MASSACHUSETTS 01605	THE AMERICAN INSTITUTE OF ARCHITECTS

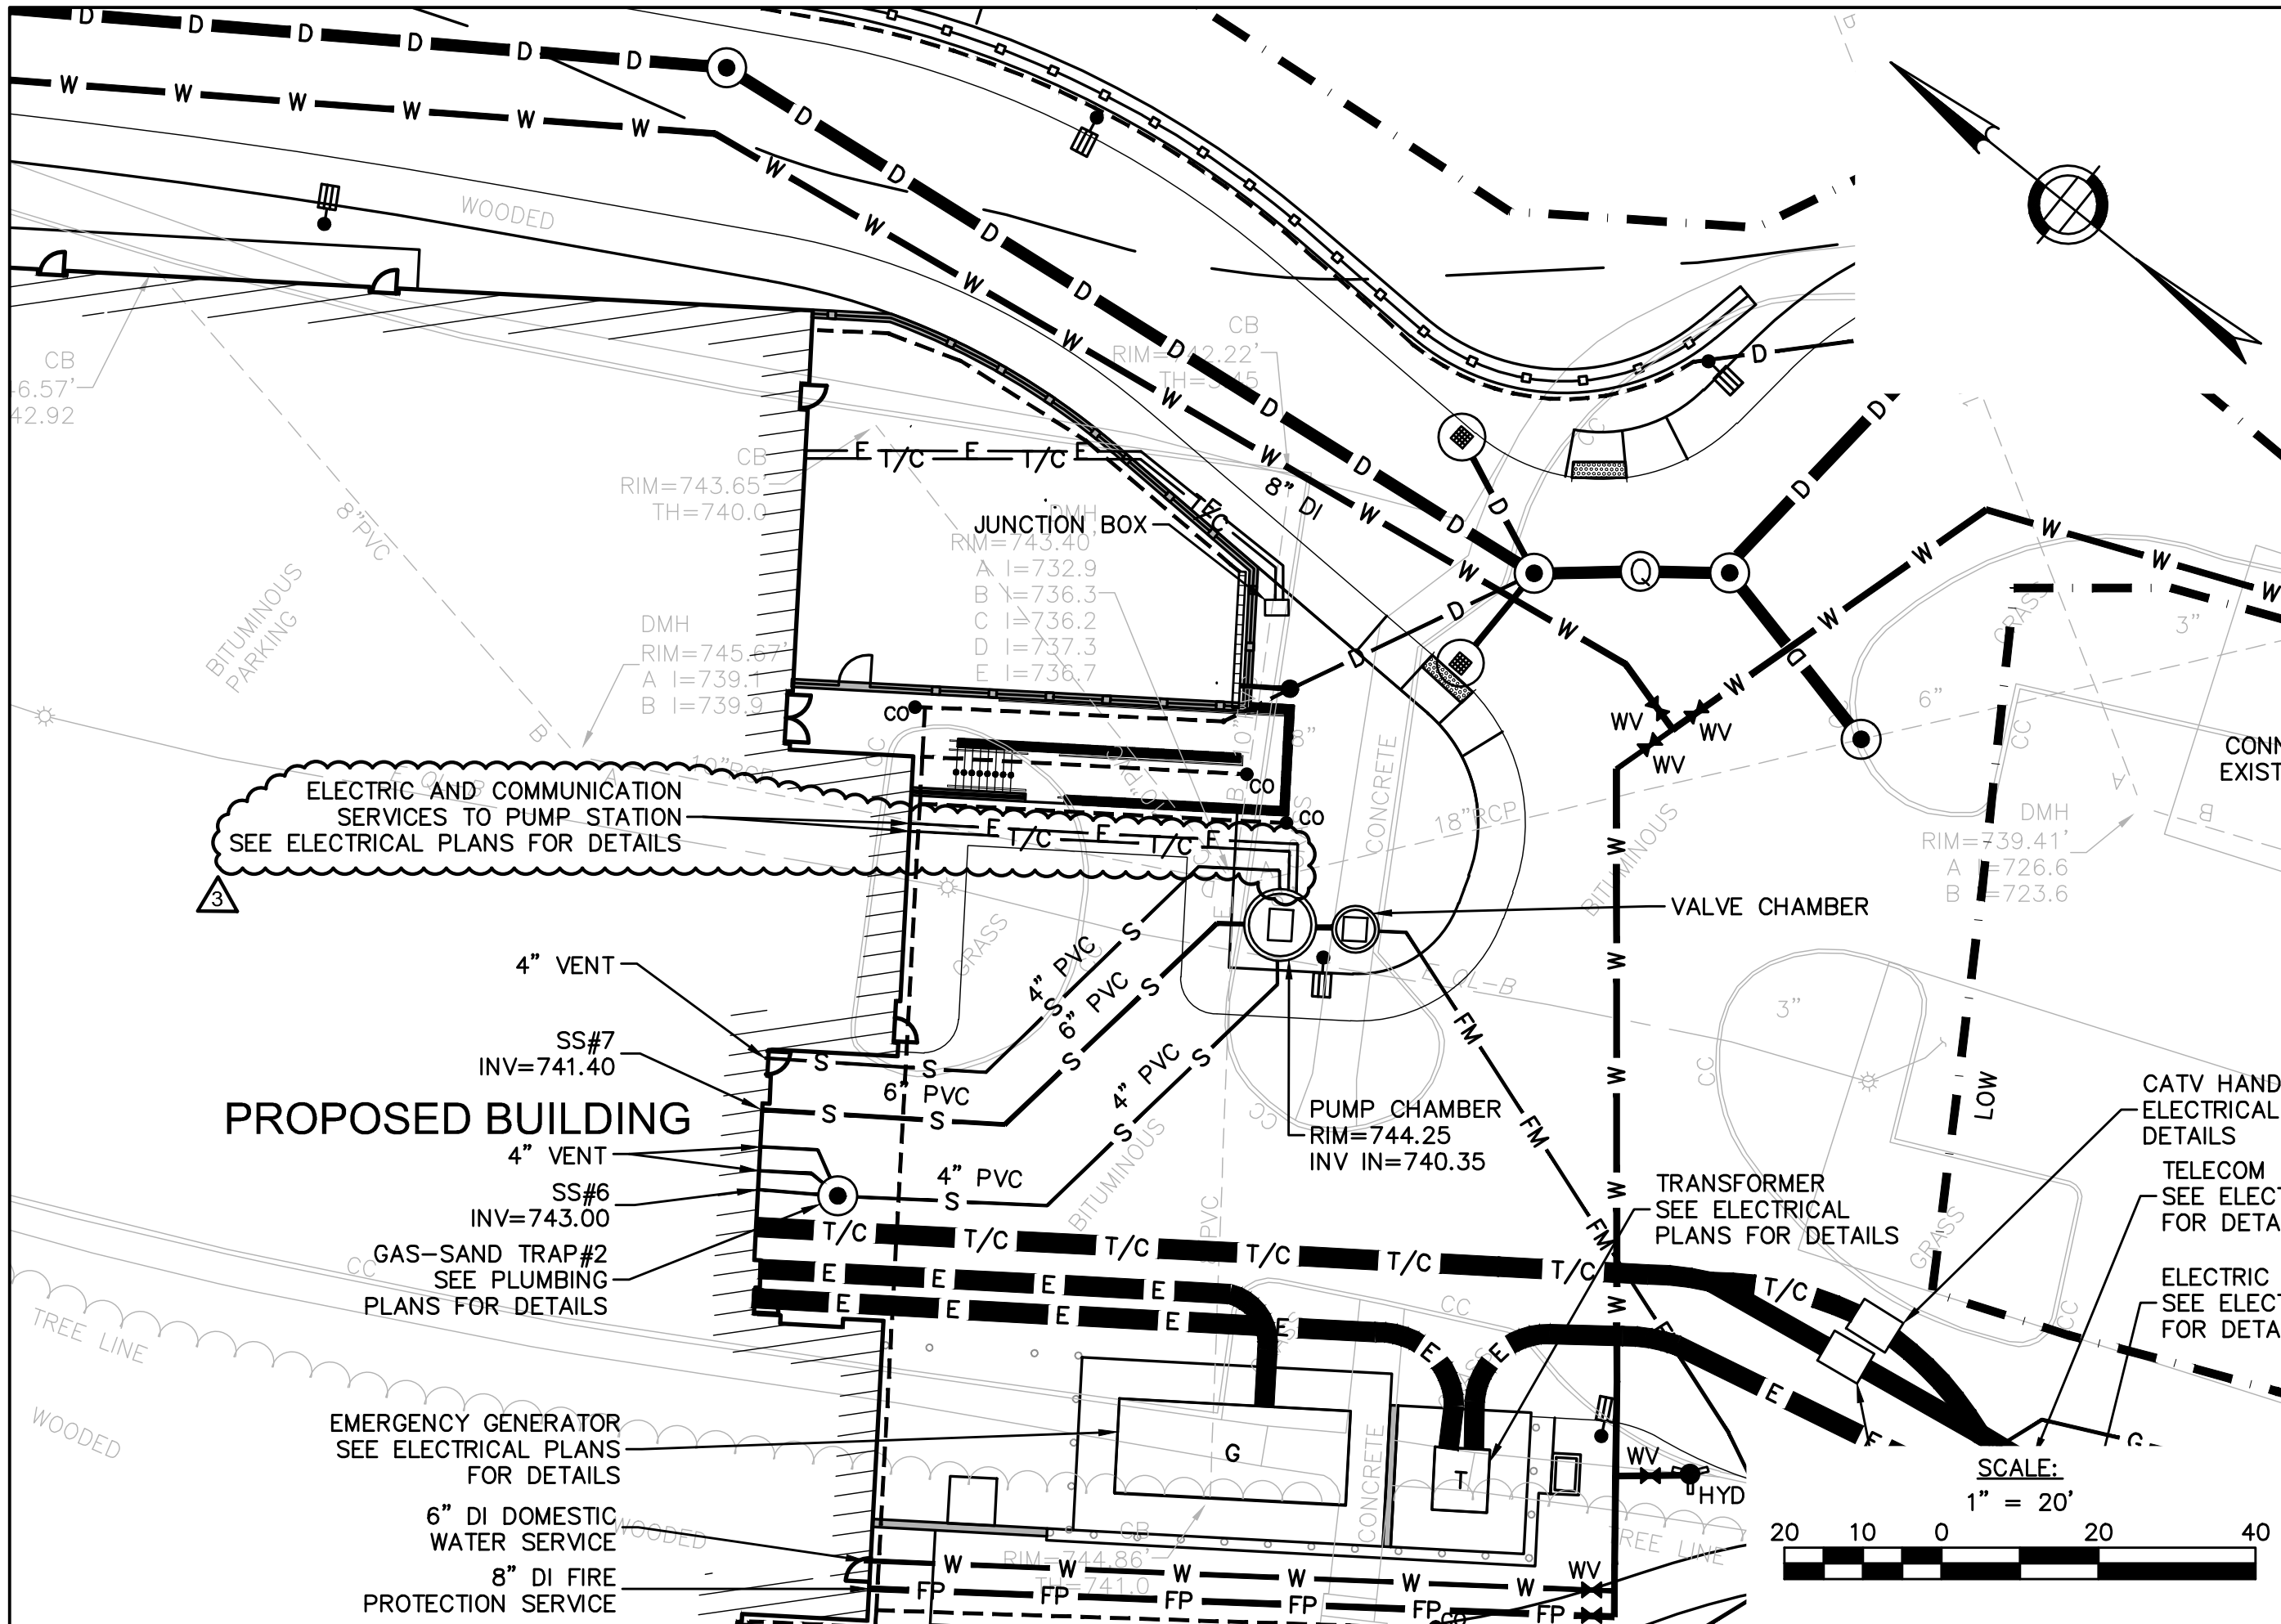

ELECTRIC AND COMMUNICATION SERVICES TO PUMP STATION
SEE ELECTRICAL PLANS FOR DETAILS

PROPOSED BUILDING

- 4" VENT
- SS#7
INV=741.40
- 4" VENT
- SS#6
INV=743.00
- GAS-SAND TRAP#2
SEE PLUMBING PLANS FOR DETAILS

- EMERGENCY GENERATOR
SEE ELECTRICAL PLANS FOR DETAILS
- 6" DI DOMESTIC WATER SERVICE
- 8" DI FIRE PROTECTION SERVICE


JUNCTION BOX
RIM=743.40
A I=732.9
B I=736.3
C I=736.2
D I=737.3
E I=736.7

PUMP CHAMBER
RIM=744.25
INV IN=740.35


VALVE CHAMBER


TRANSFORMER
SEE ELECTRICAL PLANS FOR DETAILS

- CATV HAND ELECTRICAL DETAILS
- TELECOM D SEE ELECTRICAL PLANS FOR DETAILS
- ELECTRIC D SEE ELECTRICAL PLANS FOR DETAILS

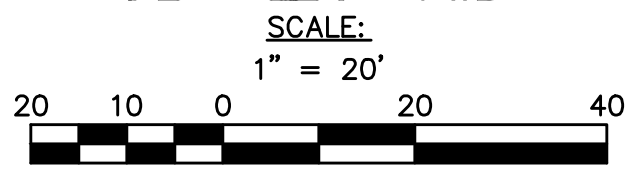

SHEET REF. NO. C8.3	DRAWING NUMBER: ADD-3 C-031	DRAWING NAME: Site Utility Plan Sketch
PROJECT TITLE: EARLY SITE BID PACKAGE #2 South High Community School 170 Apricot Street, Worcester, MA 01603		
CLIENT INFORMATION: Worcester Public Schools City of Worcester Massachusetts, 01603		
MEMBER OF THE AMERICAN INSTITUTE OF ARCHITECTS		

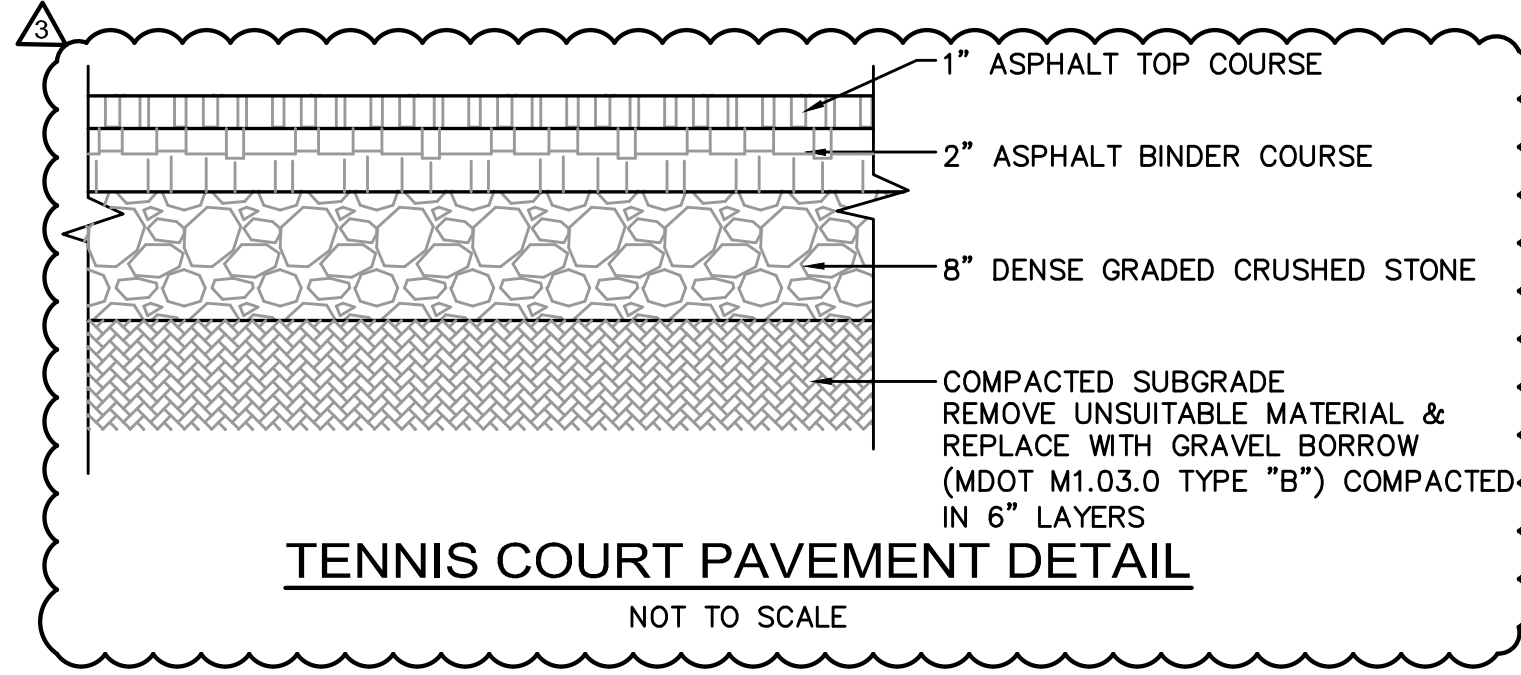

CLIENT INFORMATION: Worcester Public Schools  City of Worcester Massachusetts, 01605	PROJECT TITLE: EARLY SITE BID PACKAGE #2 South High Community School 170 Apricot Street, Worcester, MA 01603	DRAWING NAME: Civil Detail Sketch	SHEET REF. NO.: C11.6
	DATE: 09/17/18	DRAWING NUMBER: ADD-3 C-032	SCALE: NTS

3 Concrete walk replacement in conjunction with proposed electrical work (see civil and electrical drawings)

1. Concrete walks should be cut at existing expansion or construction joints within a reasonable distance to the extent of excavation.
2. New construction and expansion joints should match the existing pattern and spacing as closely as possible.

DUCT BANK APPEARS, FROM SATELLITE IMAGERY, TO RUN BETWEEN TWO LARGE TREES IN THIS AREA. REFER TO TREE PROTECTION SPECIFICATIONS (01 56 39) FOR EXCAVATION METHODOLOGY WITHIN ROOT PROTECTION ZONES. CONSULT WITH LANDSCAPE ARCHITECT ON BEST EXCAVATION PATH TO MINIMIZE IMPACTS ON TREE ROOT HEALTH.

TRANSFORMER
SEE ELECTRICAL
PLANS FOR DETAILS

PROPOSED SAW CUTS
SEE CIVIL DRAWINGS


ALIGN

SYM	DESCRIPTION
	RIGHT ANGLE
	ALIGN
	CENTERLINE
	EQUAL
	CONCRETE PAVEMENT - PEDESTRIAN
	* EXPANSION JOINT

1
L5.0

7
L5.0

* TRADE CONTRACT REQUIRED AS PART OF SPECIFICATION SECTION 07001

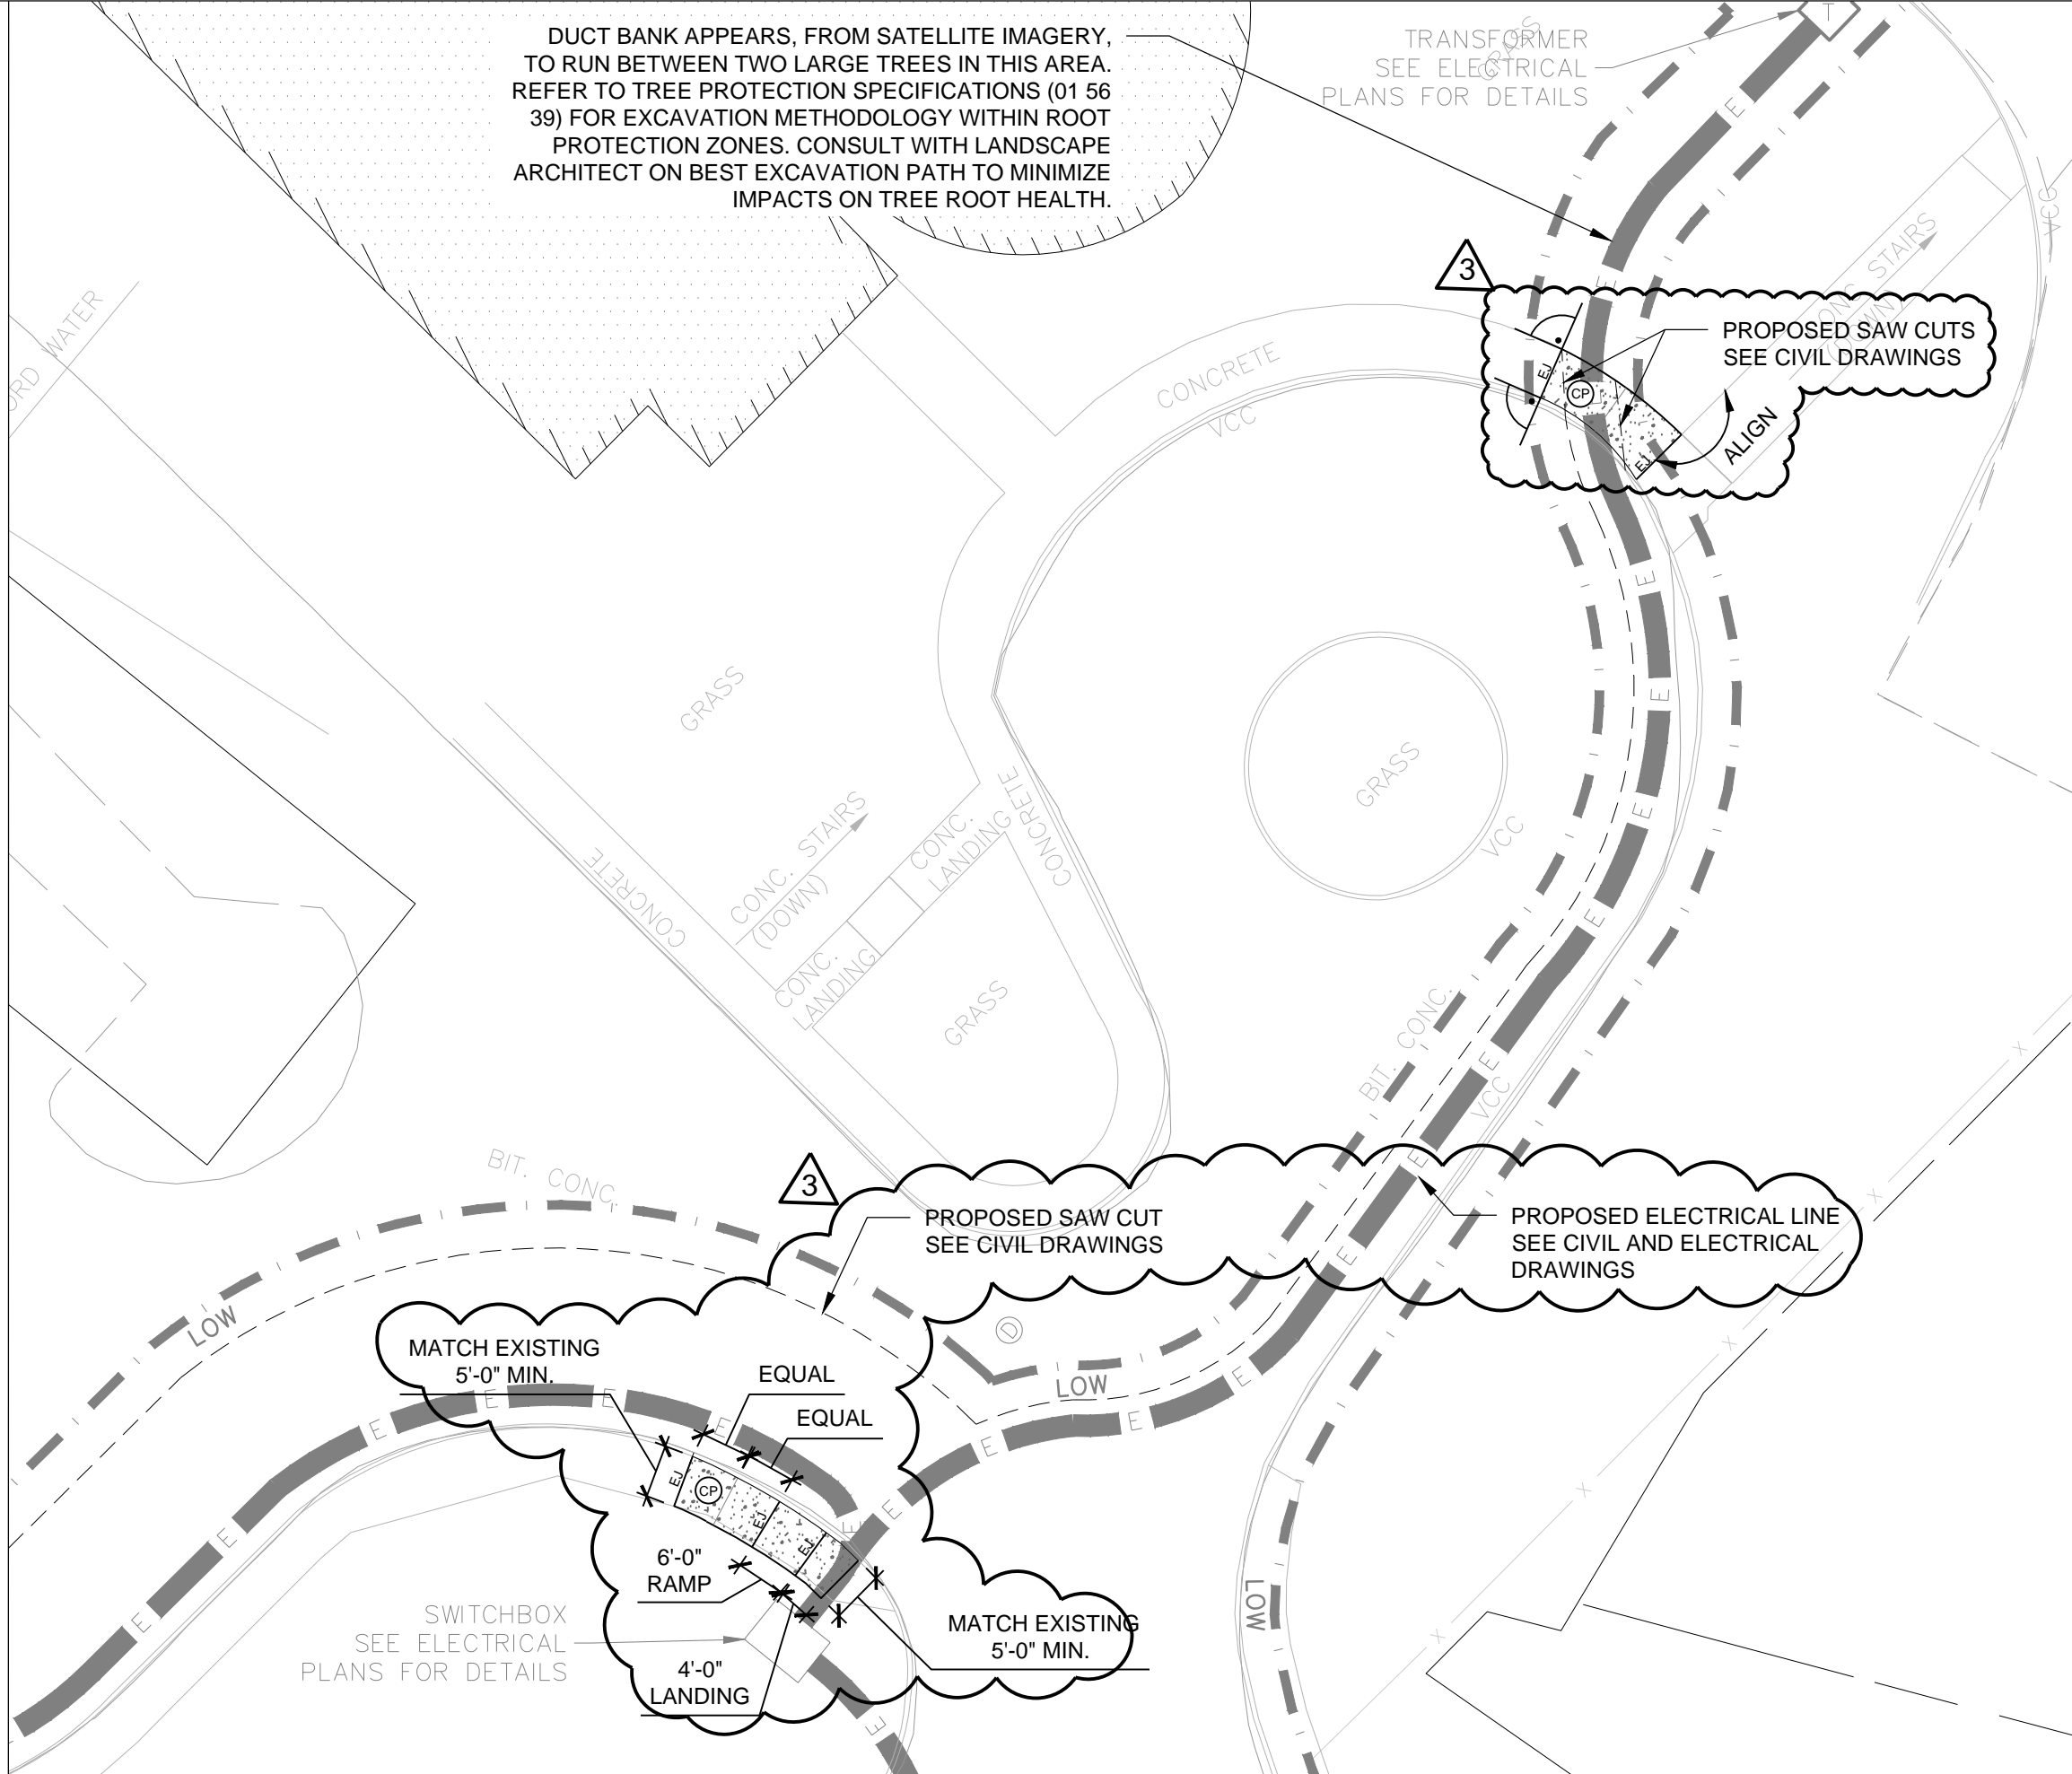

DRAWING NAME: Courtyard Trees	SHEET REF. NO. L2.3, L2.4, L3.3, L3.4
DATE: September 17, 2018	DRAWING NUMBER: ADD-3
SCALE: 1" = 20'-0"	L- 003

PROJECT TITLE:
EARLY SITE BID PACKAGE #2

South High Community School
170 Apricot Street, Worcester, MA 01603

CLIENT INFORMATION:
Worcester Public Schools

City of Worcester
Massachusetts, 01605

LAMOREUX PAGANO
ASSOCIATES ARCHITECTS
108 GROVE STREET, SUITE 200
WORCESTER, MASSACHUSETTS 01603

THE AMERICAN INSTITUTE OF ARCHITECTS




See civil drawings for artificial field turf drainage layers.

6

FIELD PERIMETER CURB - TYPICAL - SYNTHETIC TURF

1" = 1'-0"

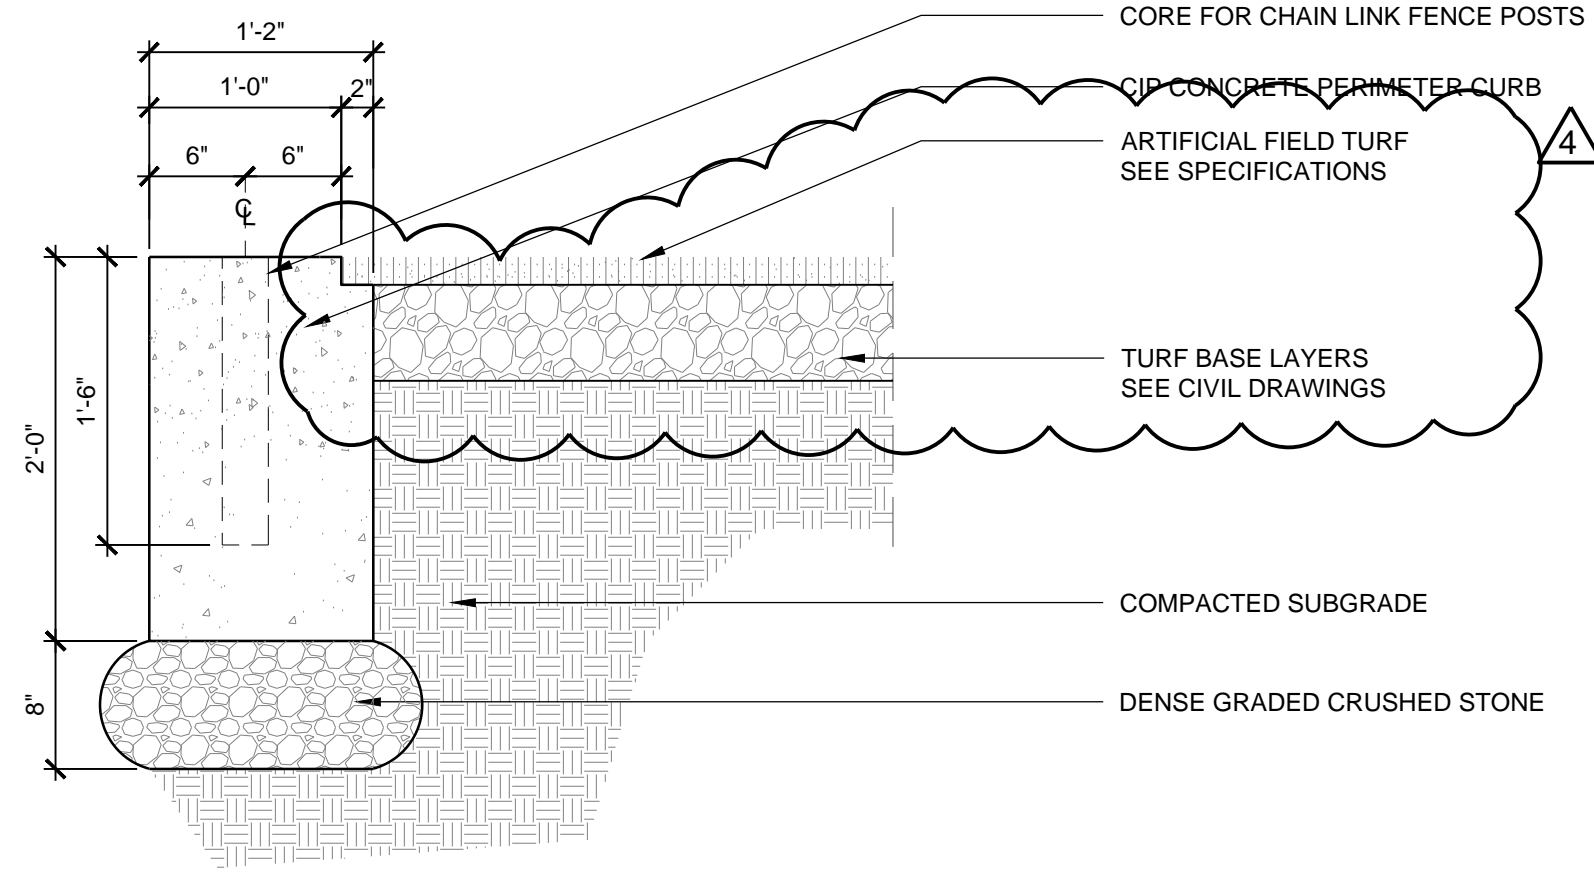

CLIENT INFORMATION:
Worcester Public Schools



City of Worcester
Massachusetts, 01605

PROJECT TITLE:

EARLY SITE BID PACKAGE #2

South High Community School

170 Apricot Street, Worcester, MA 01603

DRAWING NAME:

Artificial Field Turf Detail

SHEET REF. NO.
L5.6

DATE: September 17, 2018

SCALE: NTS

DRAWING NUMBER:
ADD-3

L- 004



LAMOREAUX PAGANO
ASSOCIATES ARCHITECTS
108 GROVE STREET, SUITE 300
WORCESTER, MASSACHUSETTS 01603

THE AMERICAN INSTITUTE OF ARCHITECTS



Location of the irrigation control box called out.

IRRIGATION LEGEND

SYMBOL	DESCRIPTION
(B)	BUBBLER ON TREES
(B1)	BUBBLER ON TREES IN COBBLE
(D)	DRIP IN SHRUB + PERENNIAL BEDS
(L)	SPRAY HEADS IN LAWN
(X)	NO IRRIGATION



NOTE: SEE PLANTING PLAN AND SPECIFICATIONS FOR DETAIL
IRRIGATION CONTROL BOX TO BE LOCATED IN BOILER ROOM ADJACENT TO BFP
- REFER TO PLUMBING DRAWINGS

CLIENT INFORMATION:
Worcester Public Schools



City of Worcester
Massachusetts, 01605

PROJECT TITLE:

EARLY SITE BID PACKAGE #2

South High Community School

170 Apricot Street, Worcester, MA 01603

DRAWING NAME:

Irrigation Control Box Location

SHEET REF. NO.
L2.9

DATE: September 17, 2018

SCALE: NTS

DRAWING NUMBER:
ADD-3

L- 005




LAMOREAUX PAGANO
ASSOCIATES ARCHITECTS
108 GROVE STREET, SUITE 300
WORCESTER, MASSACHUSETTS 01603


THE AMERICAN INSTITUTE OF ARCHITECTS

7

Detail is new to CD set.

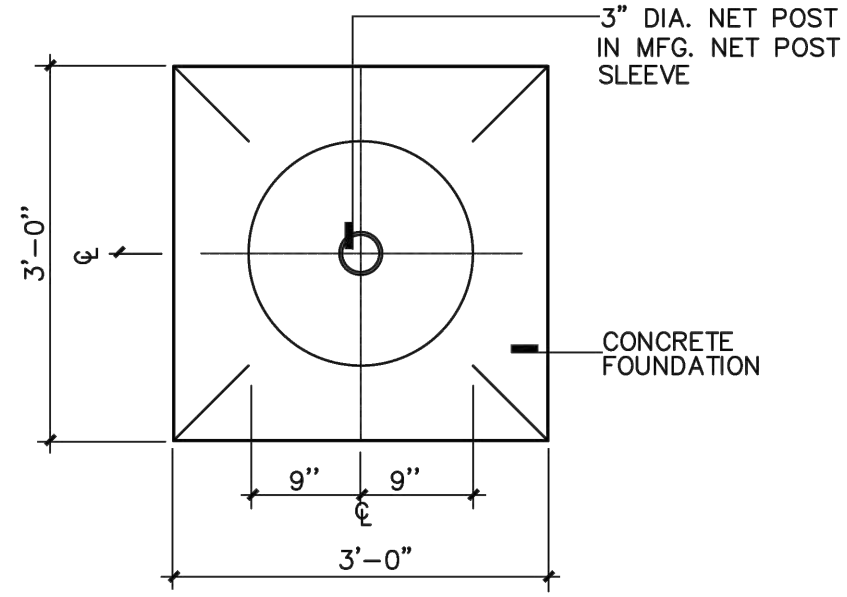

PLAN

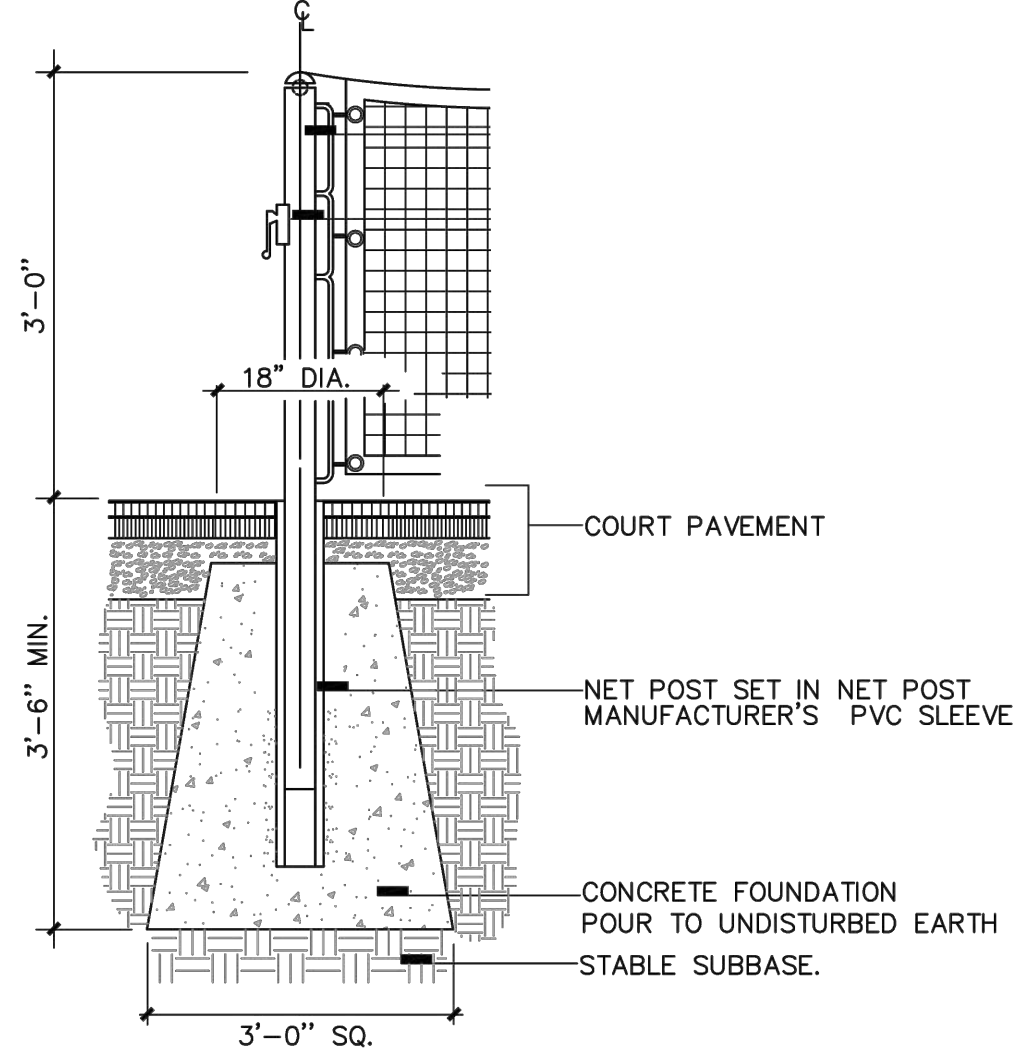

SECTION

9

TENNIS NET POST TYPICAL DETAILS

NTS

CLIENT INFORMATION:
Worcester Public Schools



City of Worcester
Massachusetts, 01605

PROJECT TITLE:

EARLY SITE BID PACKAGE #2

South High Community School

170 Apricot Street, Worcester, MA 01603

DRAWING NAME:
Tennis Net Pole Detail

SHEET REF. NO.
L5.6

DATE:
September 17, 2018

DRAWING NUMBER:

ADD-3


L- 007

SCALE:
NTS



LAMOREAUX PAGANO
ASSOCIATES ARCHITECTS
108 GROVE STREET, SUITE 300
WORCESTER, MASSACHUSETTS 01603


THE AMERICAN INSTITUTE OF ARCHITECTS

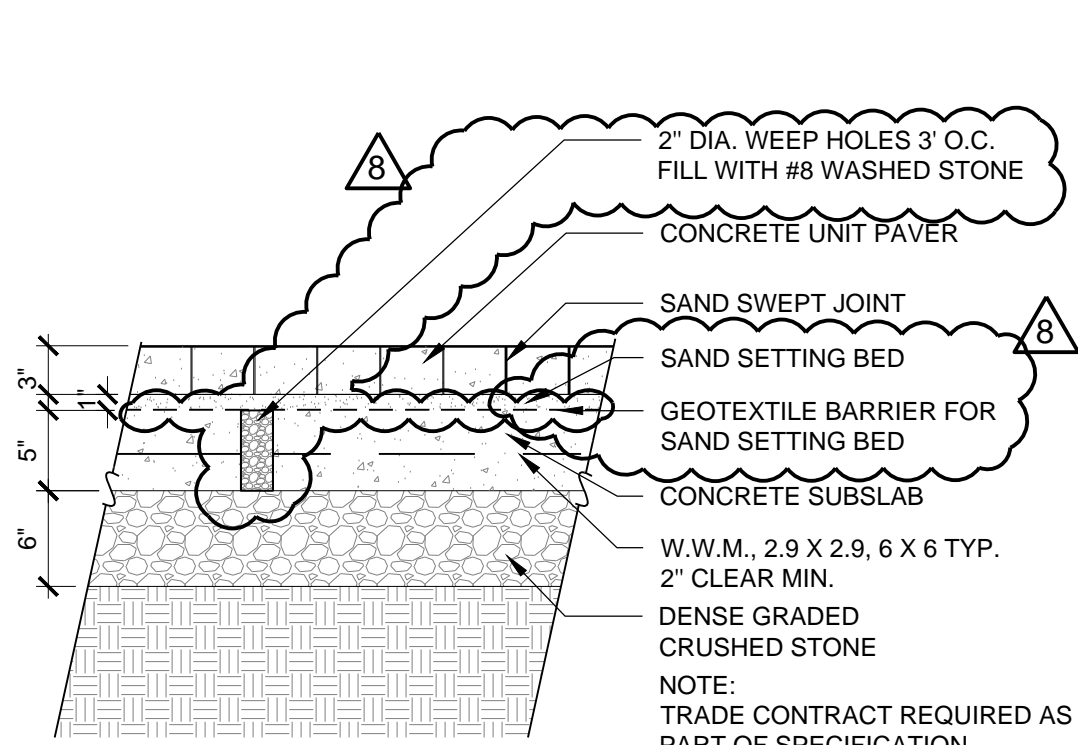

3

UNIT PAVERS

1" = 1'-0"

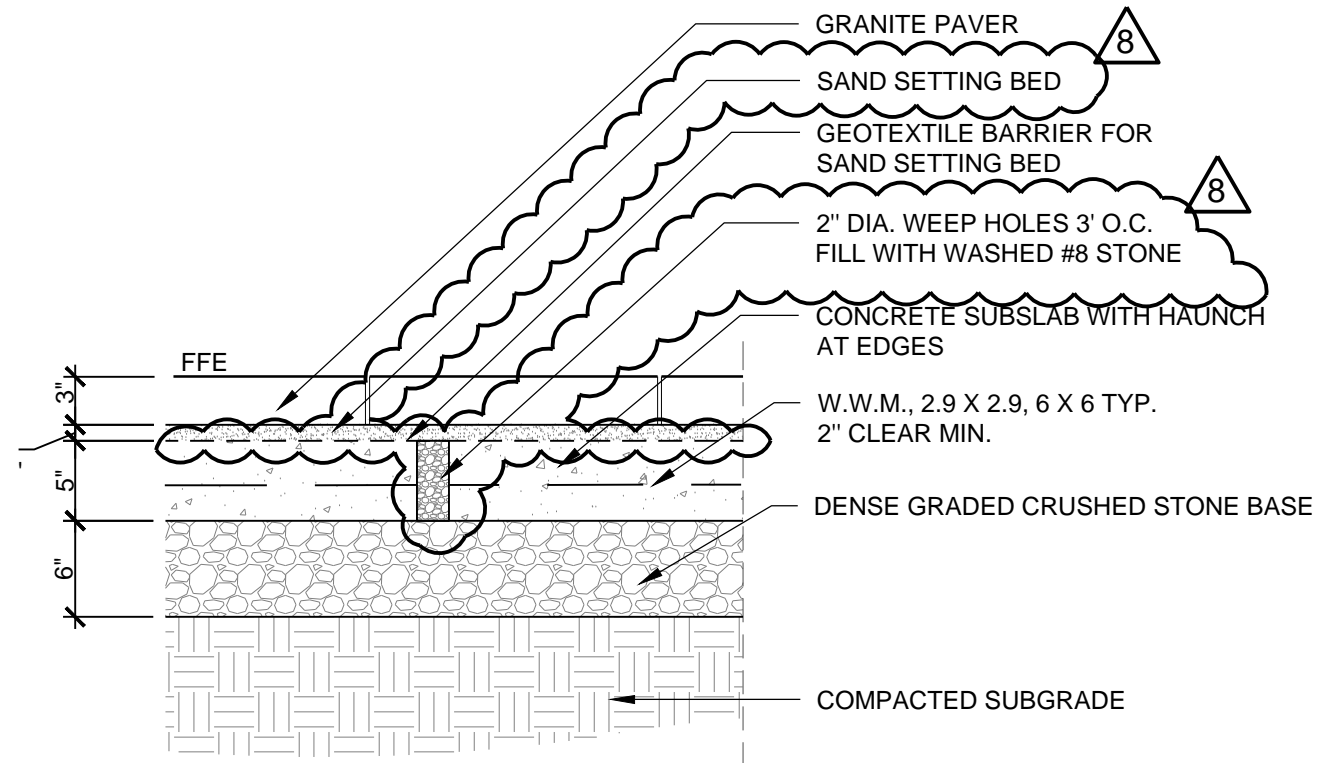


4

GRANITE PAVERS

1" = 1'-0"

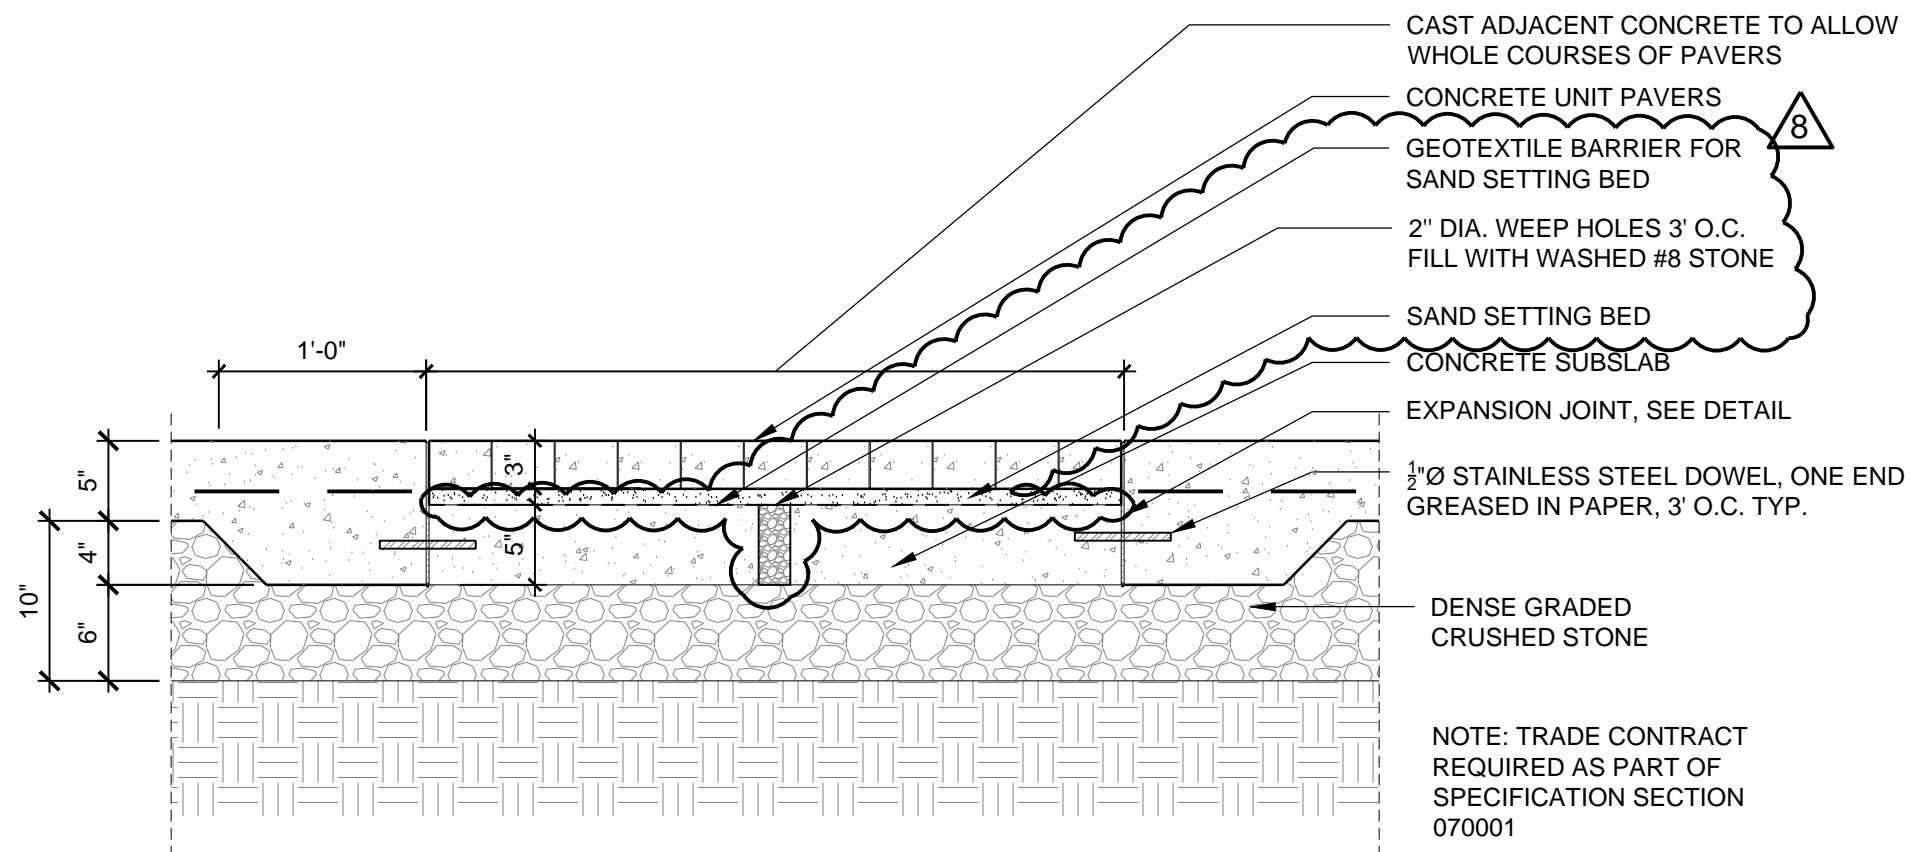

8 Changed setting bed to sand for all concrete and granite pavers. Drainage holes are to be drilled 3' o.c. in the concrete sub slab and filled with #8 stone. Filter fabric should be laid between the concrete sub slab and the sand setting bed.



5


CONCRETE UNIT PAVERS AT CONCRETE PAVEMENT EDGE

1" = 1'-0"

DRAWING NAME: Concrete Unit and Granite Pavers	SHEET REF. NO. L5.0	DRAWING NUMBER: ADD-3 L-008
	DATE: September 17, 2018	
PROJECT TITLE: EARLY SITE BID PACKAGE #2 South High Community School 170 Apricot Street, Worcester, MA 01603		
CLIENT INFORMATION: Worcester Public Schools	 City of Worcester Massachusetts, 01605	 LAMOREUX PAGANO ASSOCIATES ARCHITECTS 100 GROVE STREET, SUITE 200 WORCESTER, MASSACHUSETTS 01603 THE AMERICAN INSTITUTE OF ARCHITECTS

NOTE: TRADE CONTRACT REQUIRED AS PART OF SPECIFICATION SECTION 070001

9 Changed setting bed to sand for all concrete and granite pavers. Drainage holes are to be drilled 3' o.c. in the concrete sub slab and filled with #8 stone. Filter fabric should be laid between the concrete sub slab and the sand setting bed.

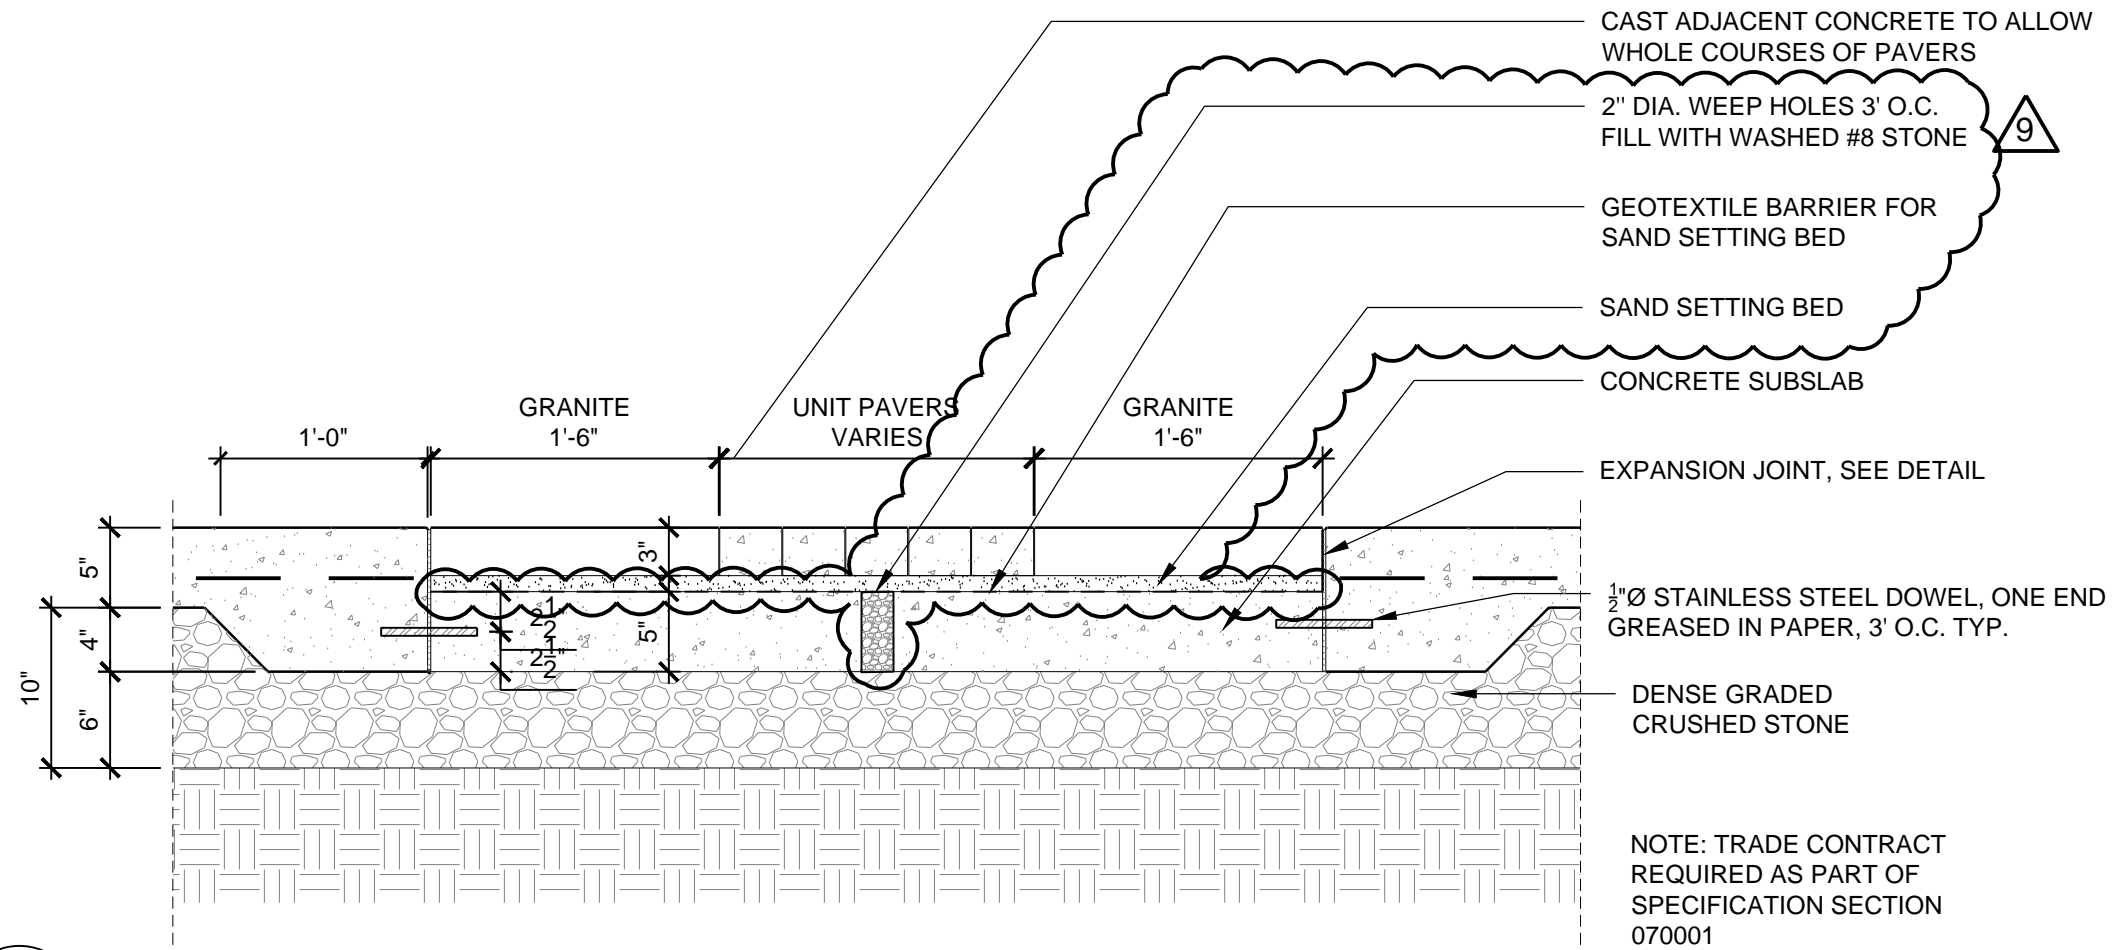

6 PAVEMENT CONNECTION DETAILS AT PLAZA
1" = 1'-0"

CAST ADJACENT CONCRETE TO ALLOW WHOLE COURSES OF PAVERS

2" DIA. WEEP HOLES 3' O.C. FILL WITH WASHED #8 STONE

GEOTEXTILE BARRIER FOR SAND SETTING BED

SAND SETTING BED

CONCRETE SUBSLAB

EXPANSION JOINT, SEE DETAIL


1/2" Ø STAINLESS STEEL DOWEL, ONE END GREASED IN PAPER, 3' O.C. TYP.

DENSE GRADED CRUSHED STONE



NOTE: TRADE CONTRACT REQUIRED AS PART OF SPECIFICATION SECTION 070001

DRAWING NAME: Concrete Unit and Granite Pavers	SHEET REF. NO. L5.0
	DRAWING NUMBER: ADD-3 L- 009
DATE: September 17, 2018	PROJECT TITLE: EARLY SITE BID PACKAGE #2 South High Community School 170 Apricot Street, Worcester, MA 01603
SCALE: 1" = 1'-0"	
CLIENT INFORMATION: Worcester Public Schools	 City of Worcester Massachusetts, 01605
 LAMOUREUX PAGANO ASSOCIATES ARCHITECTS 108 GROVE STREET, SUITE 300 WORCESTER, MASSACHUSETTS 01603 <small>THE AMERICAN INSTITUTE OF ARCHITECTS</small>	

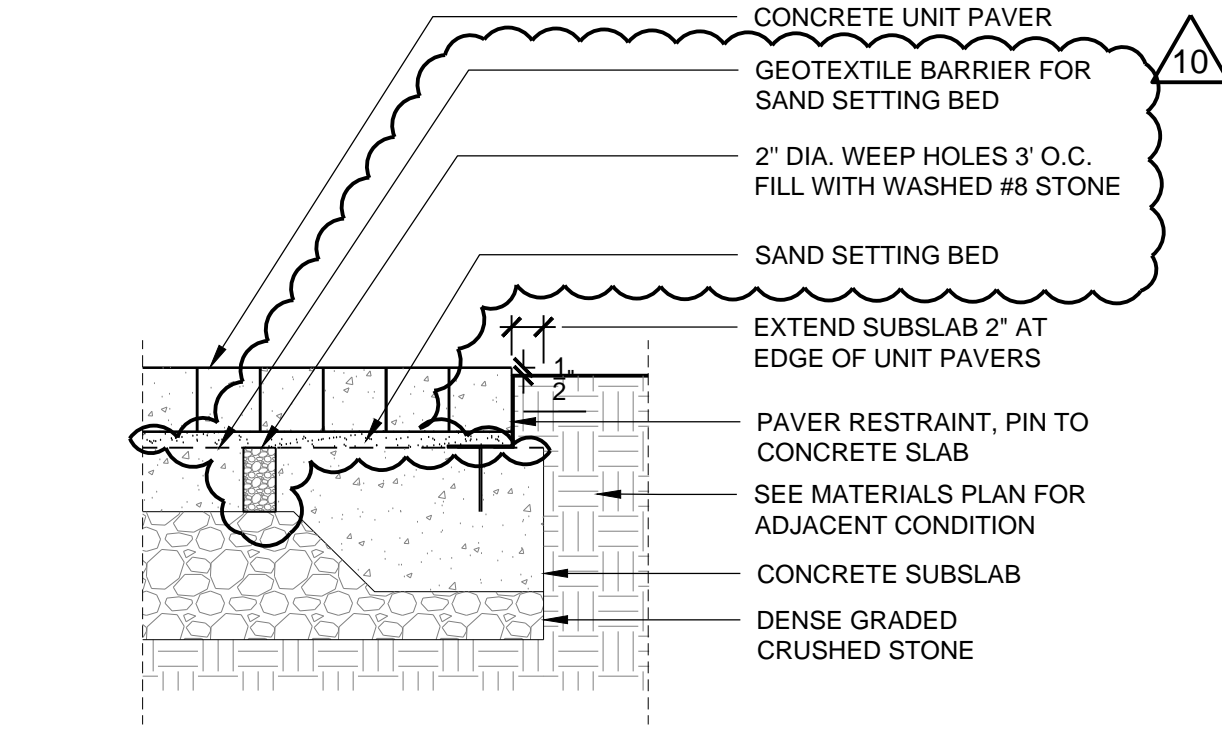10 Changed setting bed to sand for all concrete and granite pavers. Drainage holes are to be drilled 3' o.c. in the concrete sub slab and filled with #8 stone. Filter fabric should be laid between the concrete sub slab and the sand setting bed.



8 **PAVER RESTRAINT AT EDGE CONDITION**
1" = 1'-0"

CLIENT INFORMATION: Worcester Public Schools  City of Worcester Massachusetts, 01605	DRAWING NAME: Concrete Unit and Granite Pavers	SHEET REF. NO.: L5.0
	PROJECT TITLE: EARLY SITE BID PACKAGE #2 South High Community School 170 Apricot Street, Worcester, MA 01603	DATE: September 17, 2018 SCALE: 1" = 1'-0"
LAMORELUX PAGANO ASSOCIATES ARCHITECTS 108 GROVE STREET, SUITE 300 WORCESTER, MASSACHUSETTS 01603 		

ADDENDUM No. 4 – September 19, 2018

GENERAL

This addendum modifies, amends, and supplements designated parts of the Contract Documents for the above project and is hereby made part thereof by reference and shall be as binding as though inserted in locations designated hereunder.

It shall be the responsibility of the bidders to notify all subcontractors and suppliers he proposes to use for the various parts of the work for any changes or modifications contained in this addendum. No claim for additional compensation because of lack of knowledge of the contents of this addendum will be considered.

SPECIFICATIONS

1. DOCUMENT 03 45 01 – PRECAST ARCHITECTURAL CONCRETE - SITEWORK

Page 6, 2.1, D

Delete Line 1.

- Insert:
- “1. Standard and Amphitheater Benches: #4 rebar at 16 inches on center, 3 inch clear.
 2. Bollard: #3 rebar at 12 inches on center, 3 inch clear
 3. Steps: #3 rebar at 16 inches on center, 3 inch clear
 4. Entry sign: #4 rebar at 16 inches on center, 3 inch clear”

Page 7, 2.1

- Insert:
- “R. Precast concrete benches and bollards (add. #3)
1. Standard bench: 1'-6" W x 1'-10" H x 4'-0" L
 2. Amphitheater bench: 2'-0" W x 1'-8" H x 4'-0" L
 3. Bollard: 1'-6" W x 1'-6" W x 1'-10" H
- S. Precast steps (at amphitheater)
1. Lower steps: 9" H x 2'-0" W x 4'-0" L
 2. Upper step: 7" H x 1'-0" W x 4'-0" L and 7" H x 1'-0" width x 2'-0" L
- T. Entry sign
1. 5'-0" H x 1'-4" W x 10'-0" L
 2. Board form finish
 3. Recess for insert LED sign
 4. Conduit for LED sign and lighting”

Page 9, 2.5, B

Delete: “All edges to have 3/8” chamfer.”

Insert: “Eased edges.”

Page 9, 2.5, B

- Insert at end:
- “1. Benches and bollards to have 3/8 inch chamfer on all edges.
 2. Steps to have 1 inch radius at leading edge.”

2. SECTION 32 14 13 – CONCRETE UNIT PAVING

Page 1, 1.1, A, 1

Change “mortar” to “sand”

Page 2, 1.4, C

Change “mortar” to “sand setting”

Page 4, 2.2

Change “MORTAR” to “SAND”

Page 4, 2.2, A

Delete in its entirety.

Replace with: “A. Sand shall be a clean, washed, uniformly well graded masonry sand with 100 percent passing No. 16 (1.18-mm) sieve and no more than 10 percent passing No. 200 (0.075- mm) sieve, conforming to ASTM C 144, except that the fineness modulus shall be 2.25+ 0.10. Sand shall be from a single source. Source of supply shall not be changed during course of job without written permission of the Architect.”

Page 4, 2.3, A

Delete in its entirety.

Replace with: “A. Filter fabric shall be a non-woven polypropylene fabric equal to Mirafi 140N, manufactured by Tencate, 365 South Holland Drive, Pendergrass, GA 30567; Tel 800 685 9990; Tel 706 693 2226; Fax 706 693 4400; www.mirafi.com, or approved equal.”

Page 5, 3.1, A

Change “mortar” to “sand”

Page 6, 3.2

Delete items A and B in its entirety.

Insert: “A. Drill 2 inch diameter holes through concrete base slab 36 inches on center.
B. Fill drilled holes with washed #8 stone.
C. Lay filter fabric across entire concrete slab where pavers will be laid.”

Page 7, 3.5

Change “MORTAR” to “SAND”

Delete items A, B, C, D, F, G.

Change E to B, H to C, I to D, and J to E.

Page 7, 3.5, H

Delete sentence: "Set each paver in a single operation before initial set of mortar; do not return to areas already set and disturb pavers for purposes of realigning finished surfaces or adjusting joints."

Replace with: "Lay sand bed across area that can be laid that day and screed to required depth and level."

3. SECTION 32 14 10 – GRANITE PAVING

Page 1, 1.1, A, 1

Change "mortar" to "sand"

Page 2, 1.4, A

Delete: "Mortar Pointing Grout Color chart, Cured sample, 2 x 2 in.,
color to be specified. Three required,
full size, thickness, color and finish as
specified."

Page 2, 1.4, B

Delete: "Mortar materials, including additives
Grout materials, including additives"

Insert: "Sand setting bed material
Filter fabric
Joint sand"

Page 4, 1.10

Delete in its entirety.

Page 6, 2.3

Change "MORTAR" to "SAND"

Page 6, 2.3, A

Delete in its entirety.

Replace with: "A. Sand shall be a clean, washed, uniformly well graded masonry sand with 100 percent passing No. 16 (1.18-mm) sieve and no more than 10 percent passing No. 200 (0.075- mm) sieve, conforming to ASTM C 144, except that the fineness modulus shall be 2.25+ 0.10. Sand shall be from a single source. Source of supply shall not be changed during course of job without written permission of the Architect."

Page 6, 2.4

Delete: "BOND COAT"

Replace with: "FILTER FABRIC"

Page 6, 2.4, A

Delete in its entirety.

Replace with: "A. Filter fabric shall be a non-woven polypropylene fabric equal to Mirafi 140N, manufactured by Tencate, 365 South Holland Drive, Pendergrass, GA 30567; Tel 800 685 9990; Tel 706 693 2226; Fax 706 693 4400; www.mirafi.com, or approved equal.

Page 6, 2.5

Delete in its entirety.

Change 2.6 to 2.5, 2.7 to 2.6, and 2.8 to 2.7.

Page 7, 3.2

Change A to D, B to E.

Insert: "A. Drill 2 inch diameter holes through concrete base slab 36 inches on center.
B. Fill drilled holes with washed #8 stone.
C. Lay filter fabric across entire concrete slab where pavers will be laid."

Page 8, 3.4

Change "MORTAR" to "SAND"

Page 8, 3.4, E

Change "mortar" to "sand"

Page 8, 3.4, F

Delete in its entirety.

Replace with: "F. Sand setting bed shall be 1 inch thick, minimum."

Page 8, 3.4, G

Delete in its entirety.

Page 8, 3.4, H

Delete in its entirety.

Page 9, 3.4

Delete J, K, L, M in its entirety.

Page 8, 3.4

Change I to G.

Page 9

Change 3.5 to 3.7, 3.6 to 3.8

Page 9

Insert: "3.5. JOINT TREATMENT – SAND

A. On a dry day, after granite pavers have been installed, joints of pavers shall be filled by sweeping dry sand into them. When joints

are filled, paver surfaces shall be lightly misted with a fine spray of water to settle sand joint filler. Additional dry sand shall be added and swept into joints, repeating the process until joints are completely filled. Pavers shall then be swept clean and rinsed with a fine spray, careful not to dislodge joint filler.

3.6 CLEANING OF PAVED SURFACE

- A. After completion of the granite pavers, paved areas shall be thoroughly swept clean and surface shall be left unsoiled. Where required, surface shall be cleaned with water or an approved cleaner.”

4. SECTION 32 31 13 – CHAIN LINK FENCES AND GATES

Page 4, 1.1, A, 1

Change 2.6 to 2.7, 2.7 to 2.8, 2.9 to 2.10, 2.10 to 2.11.

Page 4

Insert: “2.6 CANTILEVERED SLIDE GATE

- A. Gate Frames: Fabricate chain link cantilever slide gates in accordance with ASTM F 1184, Type II, Class 2, using 2 inch square aluminum member, ASTM B 221, alloy and temper 6063-T6, weighing 0.94 lb/ft. Weld members together forming rigid one-piece frame integral with top track (no substitution). Frame members to be square, straight, and true to within over a 40’ span in an un-stressed state. Provide 2 truck assemblies for each gate leaf, except as indicated for gates larger than 30’. Frame sizes over 27’ in length shall be shipped in 2 parts and field spliced with special attachments provided by the manufacturer, Polyolefin coated frame and top track thermally fused with minimum 10 mils per ASTM 1043 (after fabrication). Coating before fabrication will not be allowed. If gate is not to be Polyolefin coated, eliminate reference to polyolefin coating.

For gate leaf size 23’ to 30’, weld an additional 2” square lateral support rail adjacent to top horizontal rail. Bottom rail shall consist of 2” x 4” aluminum member weighing 1.71 lb/ft.

Gate Leaf Sizes
23 ft to 30 ft

Cantilever Support (Overhang)
12’-0”

- B. Gate Frame Finish: natural aluminum
- C. Chain Link Filler Finish: Aluminized – ASTM A 491
- D. Bracing: Provide diagonal adjustable length truss rods of 3/8 inch galvanized steel, in each panel of gate frame.

- E. Top track/rail: Enclosed combination one-piece track and rail, aluminum extrusion with weight of 3.72 lb/ft. Track to withstand reaction load of 2,000 lb.
- F. Truck Assembly: Swivel type, zinc die cast, with 4 sealed lubricant ball bearing rollers, 2 inches in diameter by 9/16" in width, and 2 side rolling wheels to ensure truck alignment in track (no substitutions). Mount trucks on post brackets using 7/8" diameter ball bolts with 1/2" shank. Truck assembly to withstand same reaction as track, 2,000 lb.
- G. Gate hangers, latches, brackets, guide assemblies, and stops: Malleable iron and steel, galvanized after fabrication. Provide positive latch with provisions for padlocking.
- H. Bottom guide wheel assemblies: Each assembly shall consist of two, 3 inch diameter rubber wheels, straddling bottom horizontal gate rail, allowing adjustment to maintain gate frame plumb and in proper alignment. Attach one assembly to each guide post.
- I. Guide posts: For gates under 31'-0": galvanized steel 4 inch OD schedule 40 pipe, ASTM F 1083, weighing 9.1 lb/ft. Provide 1 latch post and support posts for single slide gates and 4 support posts for double slide gate.
 - 1. Finish to match fence.
- J. Motor: Provide motorized automated chain drive operation for each leaf of cantilevered gate assembly.
 - 1. Motors shall be minimum 1 HP, continuous-duty PSC motor (or larger if recommended by manufacturer for size/weight of gate assemblies).
 - 2. Provide pedestal mount.
 - 3. Provide exterior reset button
 - 4. Provide manual disconnect
- K. Controls: Provide both wired and remote-control operation.
 - 1. Wired wall switch to be located in Receiving #B180.1.
 - 2. Provide UL 325/UL 991 controller with three (3) pushbutton remote controllers.
 - 3. Provide contact or non-contact anti-entrapment devices in accordance with UL 325.
 - 4. Provide exposed roller covers in accordance with ASTM F2200."

Page 6

Change 3.3 to 3.4, 3.4 to 3.5, 3.5 to 3.6, 3.6 to 3.7

Page 6

Insert: "3.3 CANTILEVER SLIDE GATE FRAMING INSTALLATION

- A. Install gateposts in accordance with manufacturer's instructions.
- B. Concrete set gateposts: Drill holes in firm, undisturbed, or compacted soil. Holes shall have diameter 4 times greater than outside dimension of post, and depths approximately 6 inches deeper than post bottom.
- C. Excavate deeper as required for adequate support in soft and loose soils, and for posts with heavy lateral loads. Set post bottom 36 inches below surface when in firm, undisturbed soil. Place concrete around posts in continuous pour, tamp for consolidation. Trowel finish around post and slope to direct water away from posts. Check each post for vertical and top alignment, and maintain in position during placement and finishing operations."

DRAWINGS

1. DRAWING C7.2 – Site Grading Plan

A. Refer to sketch ADD-4/C-033

2. DRAWING L2.2 and L3.2

B. Refer to sketch ADD-4/L-011

3. DRAWING E0.3B – Electrical Sport Lighting Plan

C. Refer to sketch ADD-4/E-001

ATTACHMENTS

SKETCHES:

CIVIL

- 1. ADD-4/C-033 Civil Grading Plan Sketch


LANDSCAPE


- 1. ADD-4/L-011 Walk Behind Grandstand

ELECTRICAL

- 1. ADD-4/E-001 Tennis Court Conduit Path

END OF ADDENDUM #4

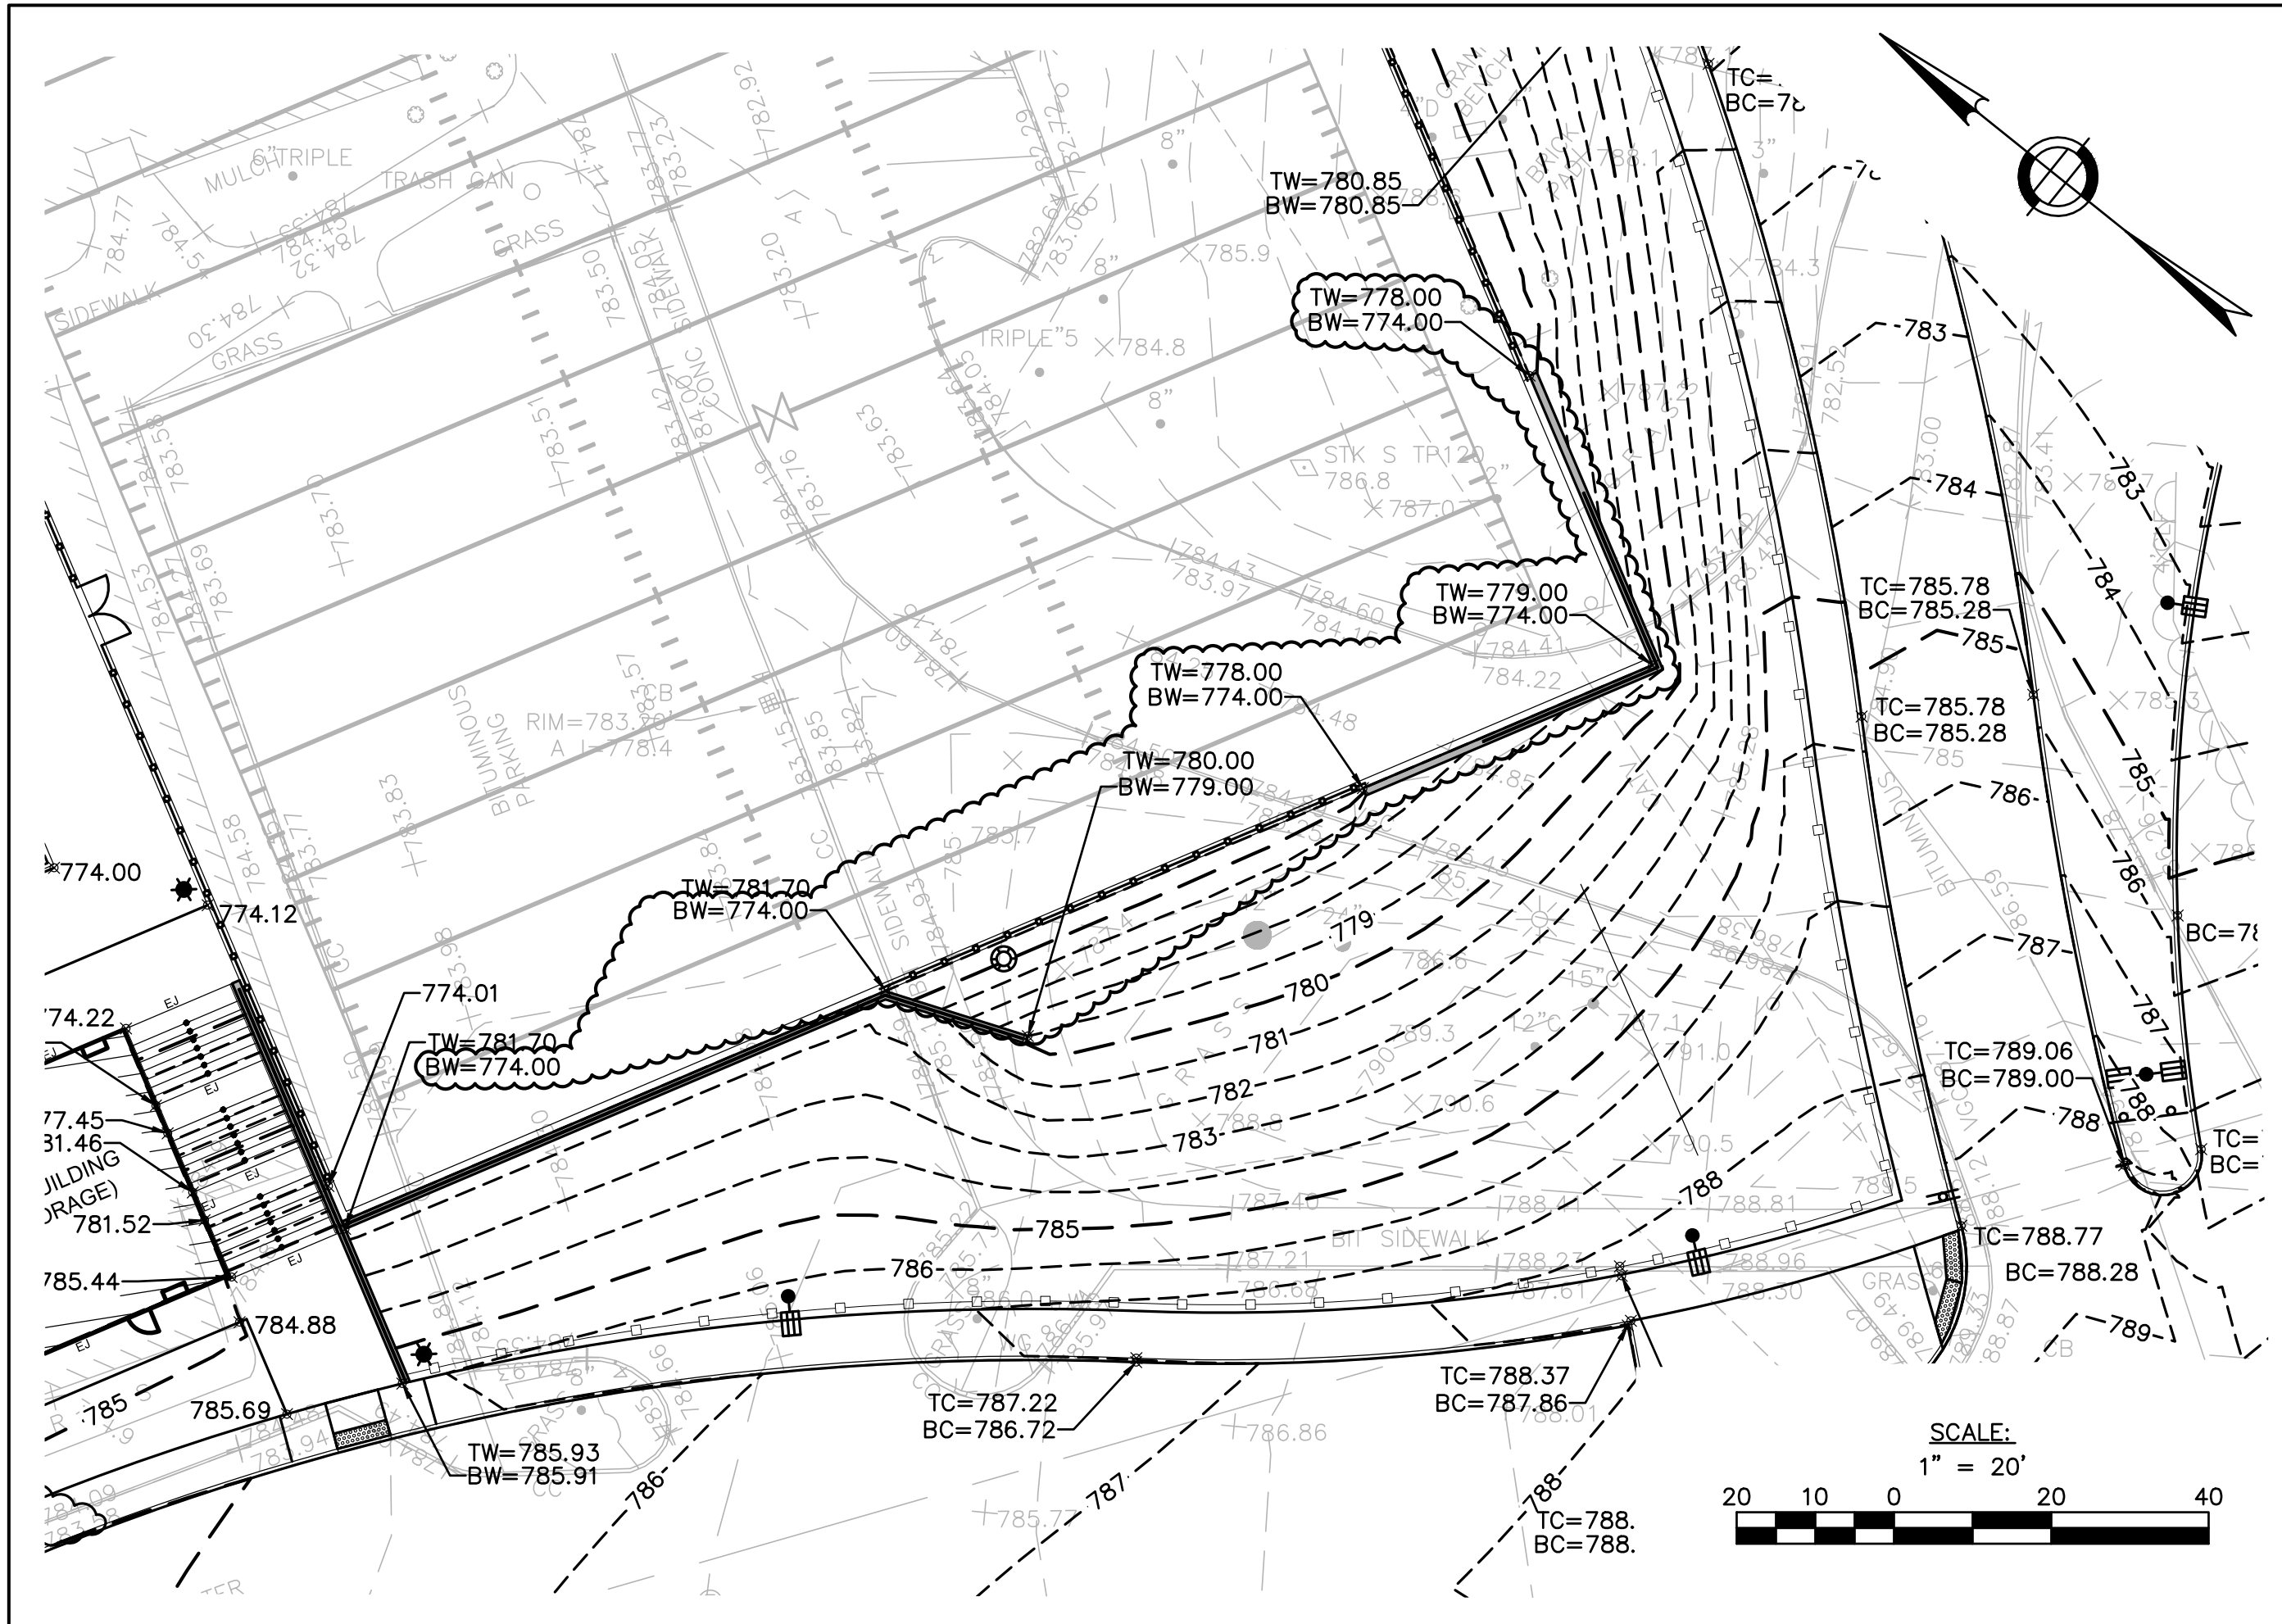









CLIENT INFORMATION: Worcester Public Schools  City of Worcester Massachusetts, 01605	DRAWING NAME: Civil Grading Plan Sketch	SHEET REF. NO.: C7.2
	PROJECT TITLE: EARLY SITE BID PACKAGE #2 South High Community School 170 Apricot Street, Worcester, MA 01603	DRAWING NUMBER: ADD-4 C-033

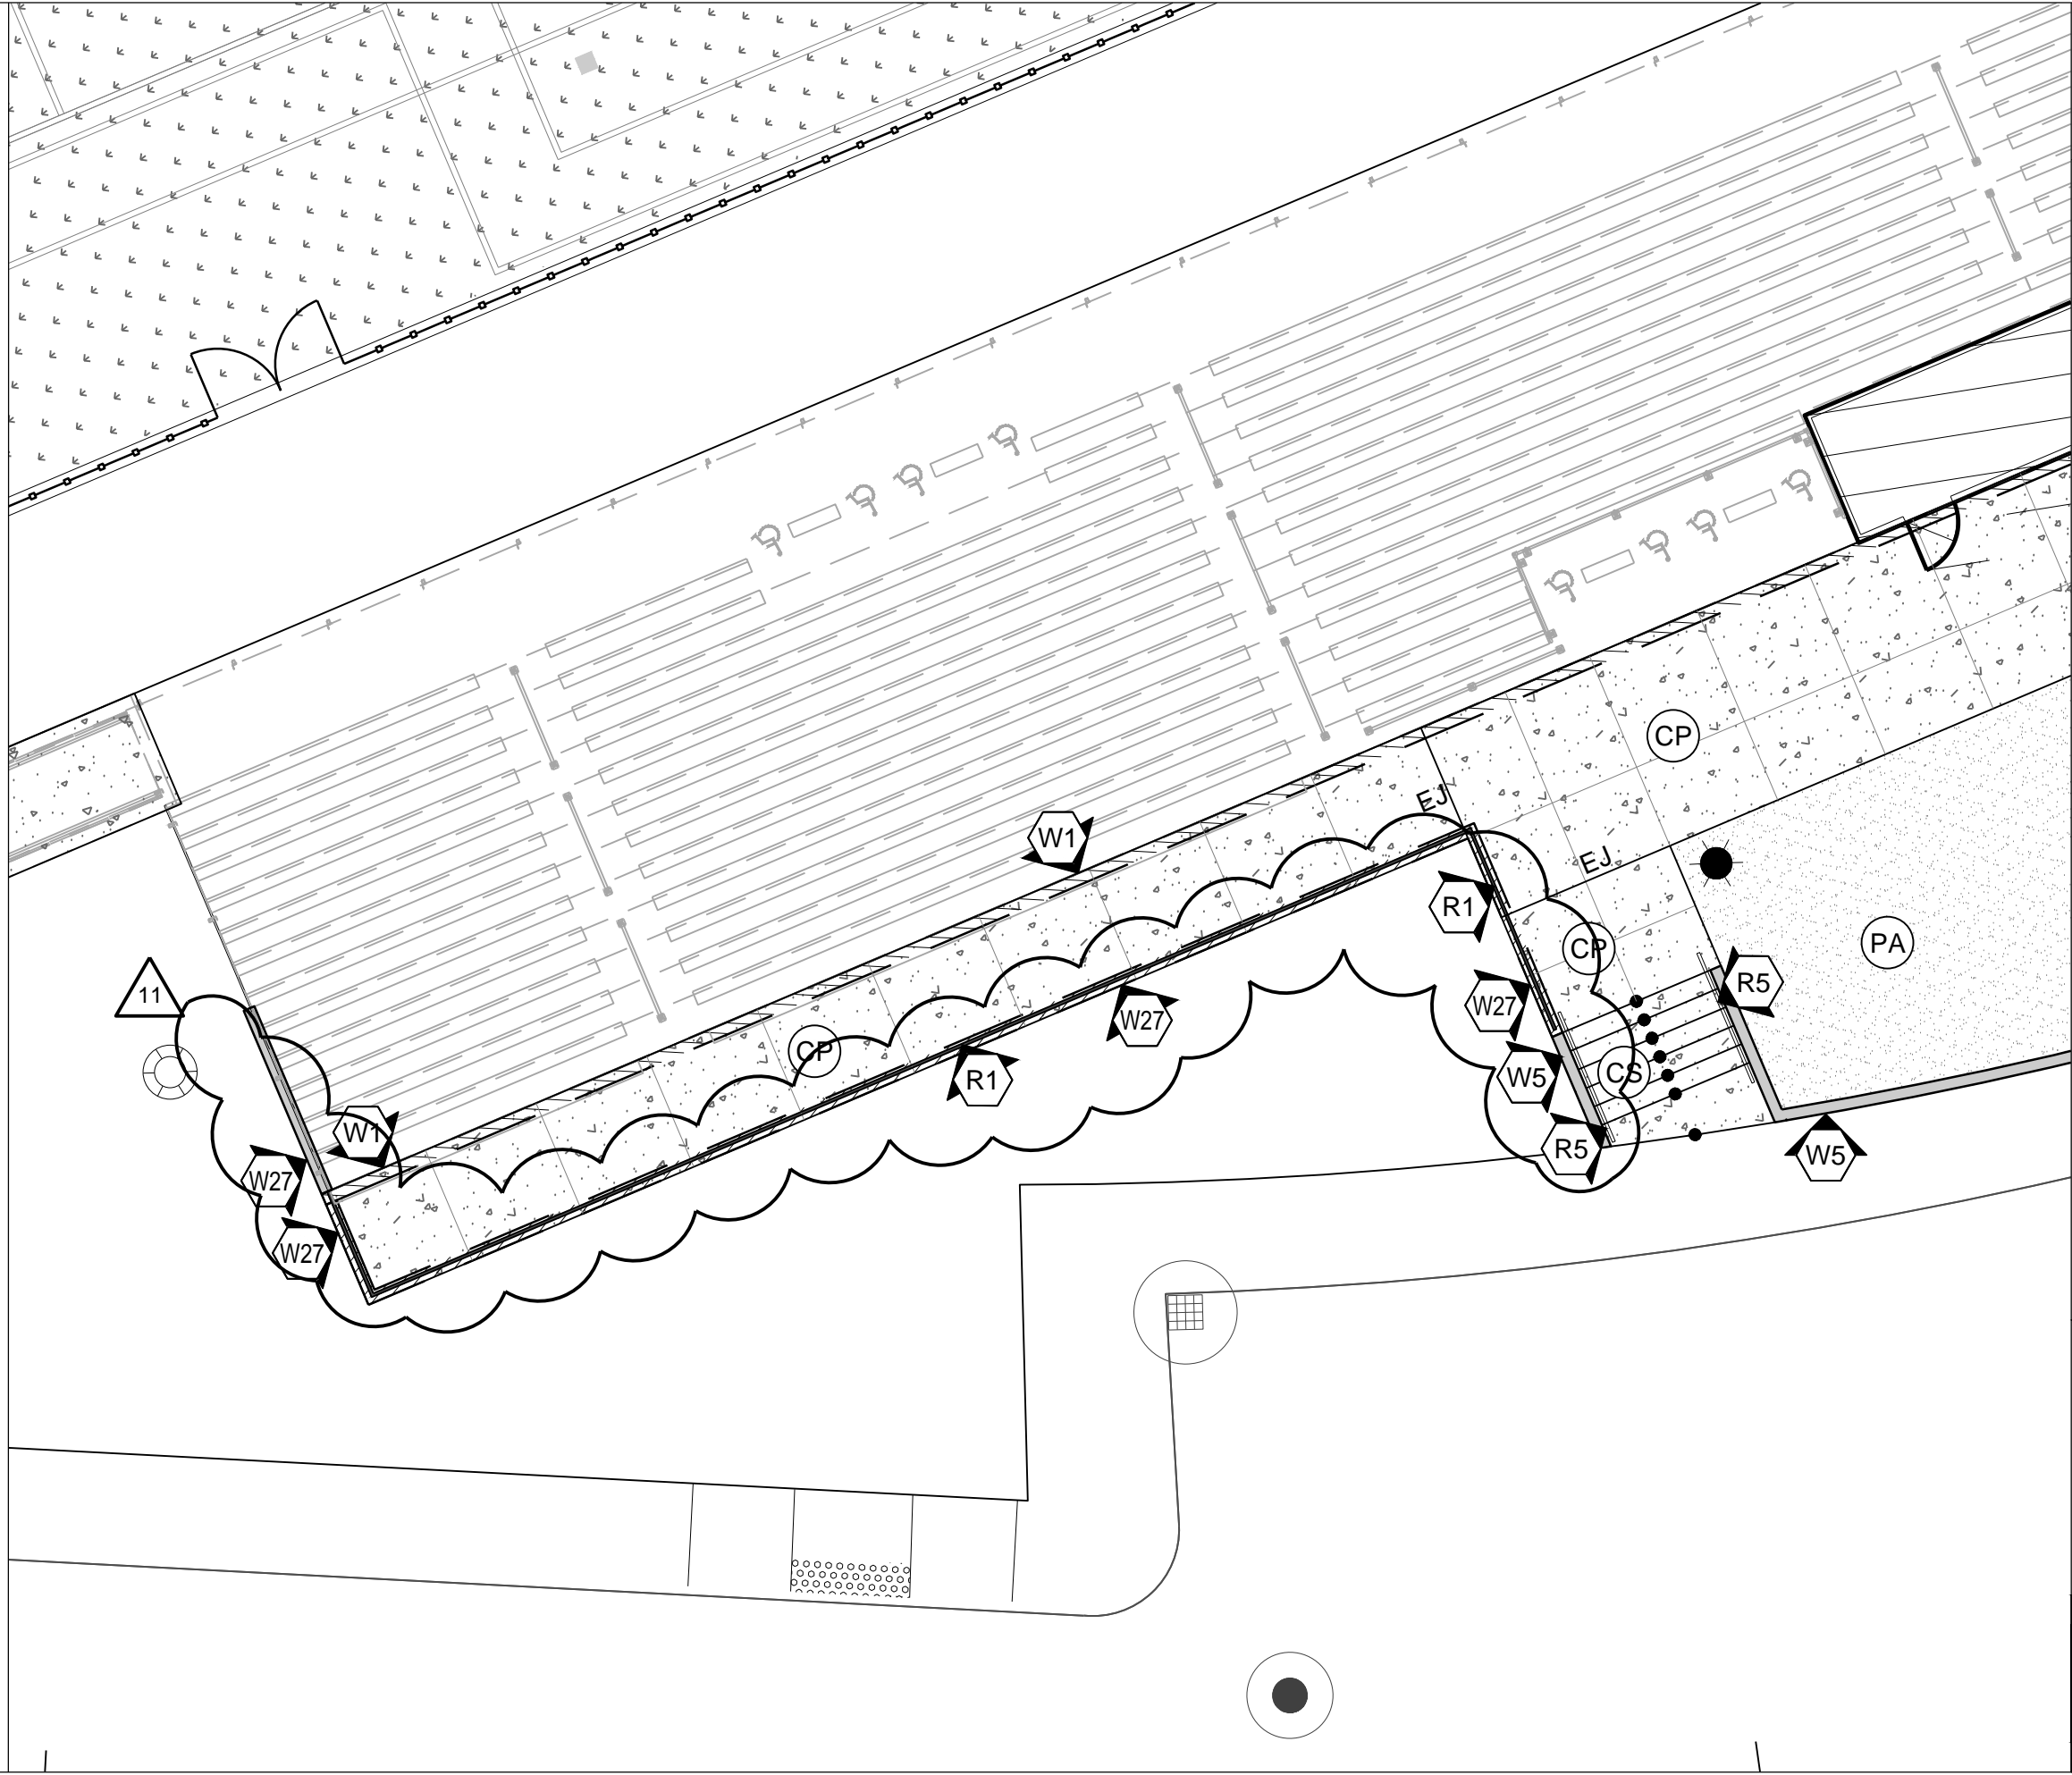


LAMOUREUX PAGANO ASSOCIATES, ARCHITECTS
 100 GROVE STREET, SUITE 200
 WORCESTER, MASSACHUSETTS 01605
 THE AMERICAN INSTITUTE OF ARCHITECTS


11

Walls added to support concrete walk behind bleachers as per updated grading.

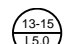

-  C.I.P. CONCRETE RETAINING WALL 
-  C.I.P. RETAINING WALL W/ SMOOTH FINISH SEE STRUCTURAL
-  *** GUARDRAIL - PEDESTRIAN 
-  *** HANDRAIL 

CLIENT INFORMATION: Worcester Public Schools	PROJECT TITLE: EARLY SITE BID PACKAGE #2	DRAWING NAME: Walk Behind Grandstand	SHEET REF. NO. L2.2, L3.2
	 City of Worcester Massachusetts, 01605	PROJECT TITLE: South High Community School 170 Apricot Street, Worcester, MA 01603	DATE: September 19, 2018 SCALE: 1" = 10'-0"
 LAMORELUX PAGANO ASSOCIATES ARCHITECTS 100 GROVE STREET, SUITE 300 WORCESTER, MASSACHUSETTS 01603	THE AMERICAN INSTITUTE OF ARCHITECTS		

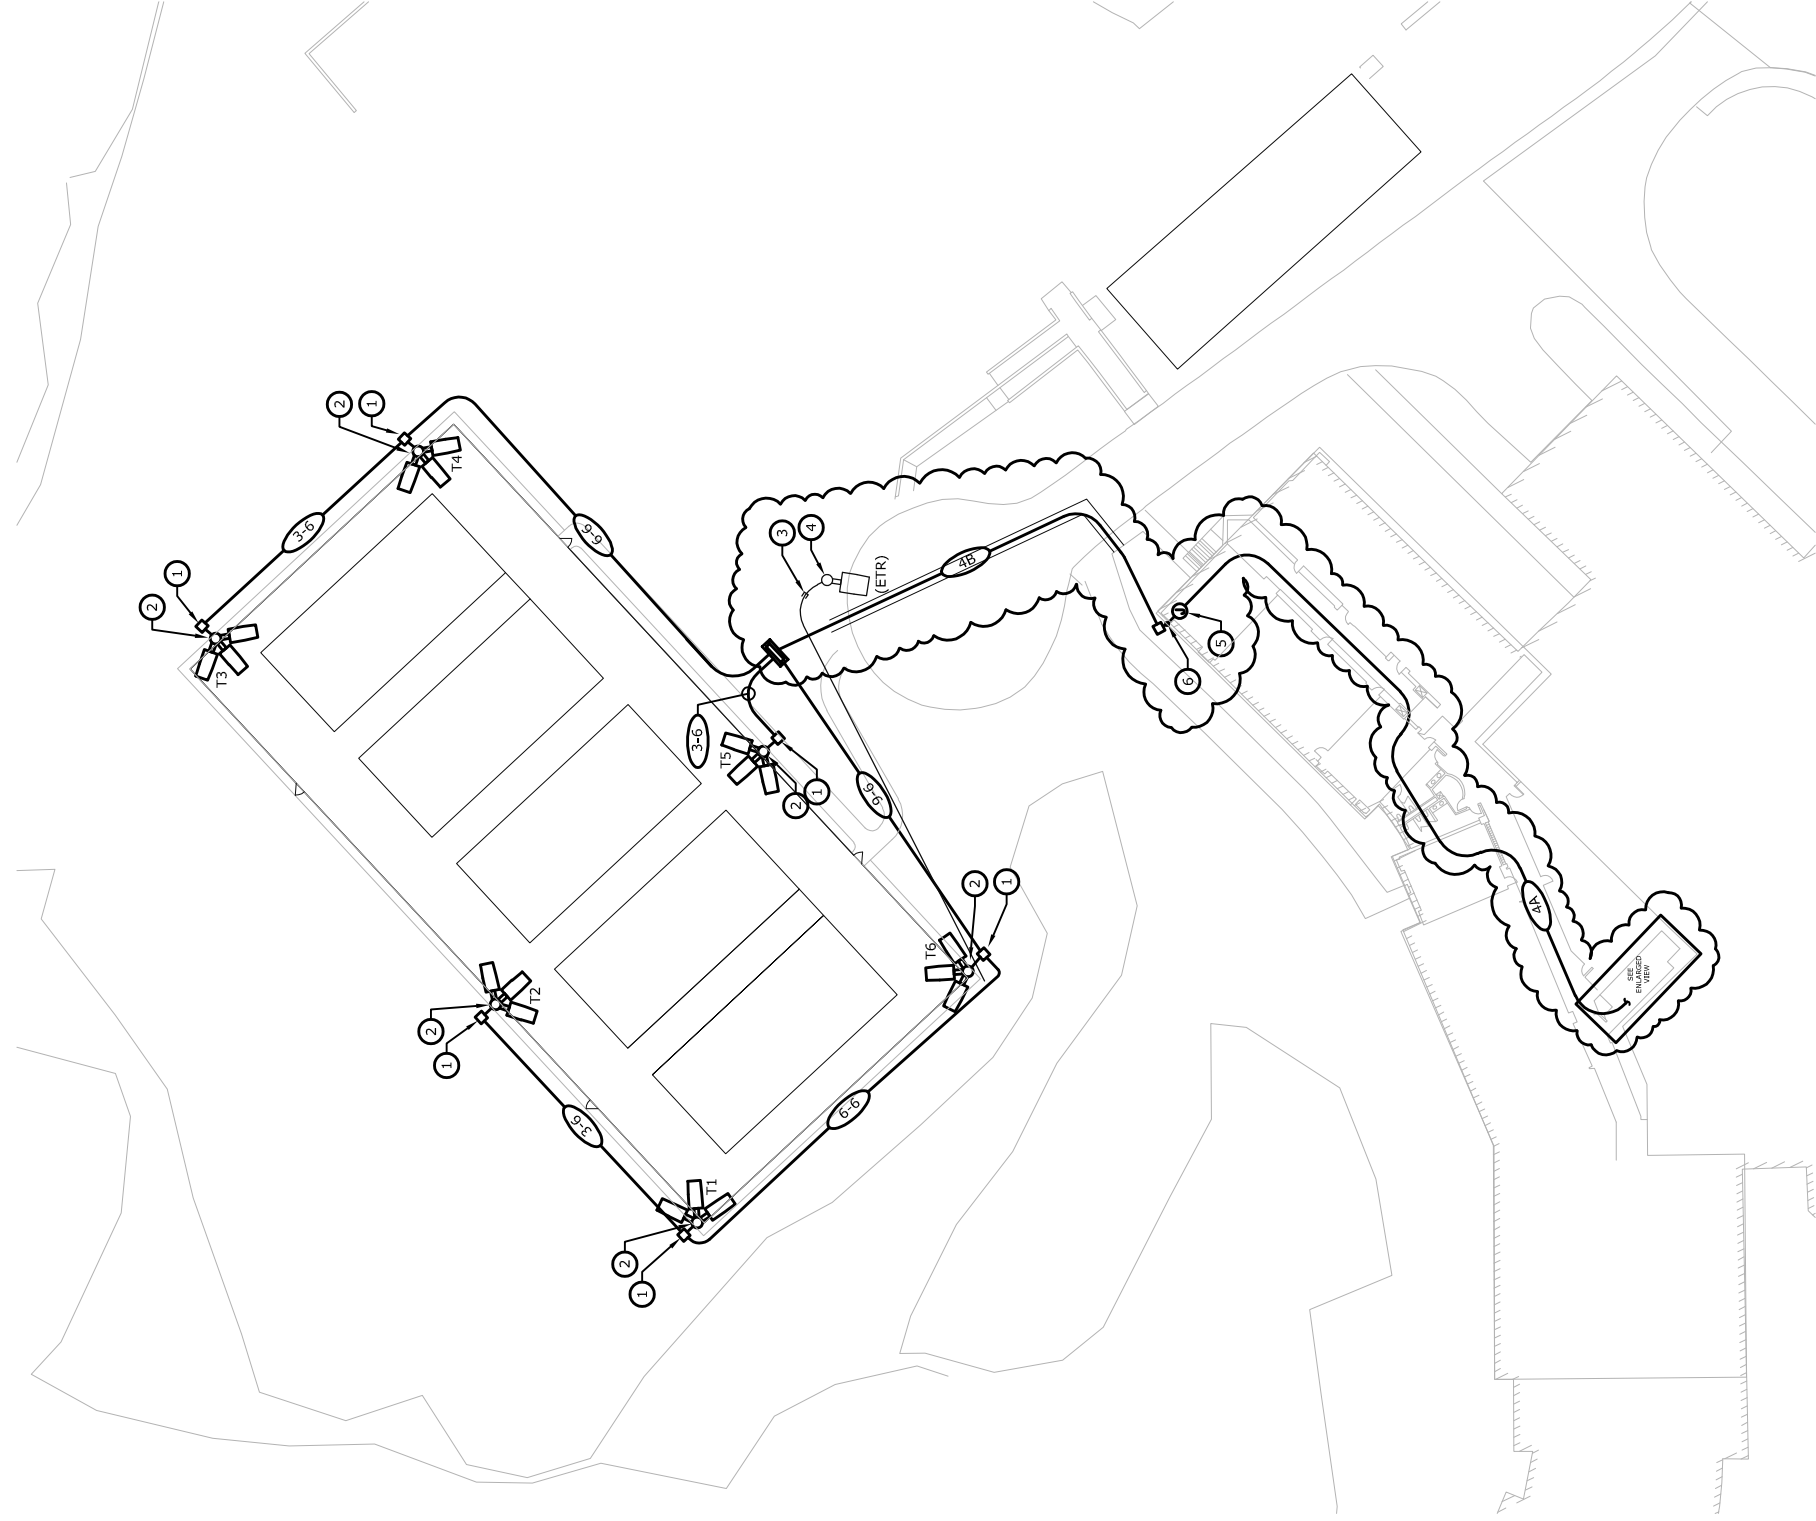

ADDENDUM NOTES:

1. RUN CONDUIT THROUGH SULLIVAN MIDDLE SCHOOL TO AVOID WETLANDS

ADDENDUM No. 5 – December 27, 2018

GENERAL

This addendum modifies, amends, and supplements designated parts of the Contract Documents for the above project and is hereby made part thereof by reference and shall be as binding as though inserted in locations designated hereunder.

It shall be the responsibility of the bidders to notify all subcontractors and suppliers he proposes to use for the various parts of the work for any changes or modifications contained in this addendum. No claim for additional compensation because of lack of knowledge of the contents of this addendum will be considered.

SPECIFICATIONS

1. SECTION 05 12 00 – STRUCTURAL STEEL

Page 11, 2.03

Insert at end: “E. Hot-dipped galvanized steel scheduled for field applied finish paint:

1. Touch-up all breaks on hot-dipped surfaces caused by cutting, welding, drilling, or undue abrasion with zinc rich paint. Apply zinc rich paint in two coats to a total dry film thickness of not less than 3 mils.
2. Provide factory-applied polyamide epoxy primer, 2.0 mils dry film thickness minimum, “Primergalv” by Duncan Galvanizing or approved equal compatible with finish paint system. Apply primer within 12 hours after galvanizing at the galvanizer’s plant in a controlled environment meeting applicable environmental regulations, and as recommended by coating manufacturer. Engage the services of a galvanizing facility which will assume single-source responsibility for galvanizing and primer coating.
3. Touch-up finish in conformance with manufacturer’s recommendations. Provide touch-up such that repair is not visible from a distance of 6 feet.”

DRAWINGS

1. DRAWING S1.2 – Typical Details

- A. At “TYPICAL SLAB ON GRADE CONSTRUCTION JOINT” detail, change note “SEE PLANS FOR LOCATION. ALLOW MIN 36 HOURS BETWEEN ADJACENT POURS” to “SEE PLANS FOR LOCATION. ALLOW MIN 36 HOURS BETWEEN ADJACENT POURS. WHERE NOT LOCATED ON PLANS, LOCATE CONSTRUCTION JOINTS TO LIMIT POURS TO LESS THAN 10,000 FT² AND LOCATE JOINTS BELOW PARTITIONS, WHERE POSSIBLE. REFER TO ARCH. DWG'S FOR JOINT DETAILS IN FLOORING AT SLAB ON GRADE CONSTRUCTION JOINTS, TYP. SUBMIT SLAB ON GRADE CONSTRUCTION JOINT PLAN FOR REVIEW PRIOR TO POURING SLABS.”

2. DRAWING S3.2 – Ground Floor Foundation Plan Section B2

- A. Add “W12x26” for missing beam size at “Partial Framing Plan- Mezzanine” along Column Line 33, between Column Lines NN & “- -“ near N.7.
- B. Refer to Sketch ADD-5/S016

3. DRAWING S3.3 – First Floor Foundation Plan Section A

- A. Refer to Sketch ADD-5/S001

4. DRAWING S3.6 – First Floor Framing Plan Section B2

- A. Refer to Sketch ADD-5/S007

5. DRAWING S3.4 – First Floor Foundation Plan Section AB

- A. Refer to Sketch ADD-5/S001
- B. Refer to Sketch ADD-5/S009
- C. Refer to Sketch ADD-5/S015

6. DRAWING S3.6 – First Floor Framing Plan Section B2

- A. Refer to Sketch ADD-5/S016

7. DRAWING S3.7 – Second Floor Framing Plan Section A

- A. Change string of dimensions at Stair #A3 (near Column G/1) from 11”, 6’-8”, 11” to 1’-0”, 6’-7”, 1’-0”.
- B. Refer to Sketch ADD-5/S002
- C. Refer to Sketch ADD-5/S005

8. DRAWING S3.8 – Second Floor / Low Roof Framing Plan Section AB

- A. Change landing dimensions at Stair #A1 (near Column D/18) from 1’-8” to 1’-0”

9. DRAWING S3.11 – Third Floor Framing Plan Section A

- A. Refer to Sketch ADD-5/S002
- B. Refer to Sketch ADD-5/S005

10. DRAWING S3.12 – Third Floor / Low Roof Framing Plan Section AB

- A. Change “TST 799-9 3/8”” to “TST (Coord. w/ Arch.)” at (7) HSS7x7x3/8 tubes between KK/43 - GG/43, GG/43 - GG/46, & GG/46 - KK/46.
- B. Change landing dimensions at Stair #A1 (near Column D/18) from 1’-8” to 1’-0”.

11. DRAWING S3.15 – Roof Framing Plan Section A

- A. Refer to Sketch ADD-5/S003

12. DRAWING S4.11 – Sections

- A. Refer to Sketch ADD-5/S008

13. DRAWING S4.12 – Sections

- A. Section 7/S4.12: Change “HSS7x7 COLUMN” to “HSS6x6 COLUMN”
- B. Section 11/S4.12: Change note at lintel angle from “L6x4 (GALV) W/ 8” BRG EA. END, TYP.” to “L6x4 (GALV & EPOXY PRIMED) W/ 8” BRG EA. END, REFER TO ARCH. DWG’S AND SPEC. 09 91 00 “PAINTING” FOR PAINTING REQUIREMENTS, TYP.”
- C. Section 12/S4.12: change note at lintel angle from “L6x4 (GALV) W/ 8” BRG EA. END ‘R= ‘ TYP.” to “L6x4 (GALV & EPOXY PRIMED) W/ 8” BRG EA. END, ‘R= ‘, REFER TO ARCH. DWG’S AND SPEC. 09 91 00 “PAINTING” FOR PAINTING REQUIREMENTS, TYP.”

14. DRAWING S4.14 – Sections

- A. Refer to Sketch ADD-5/S011

15. DRAWING S4.15 – Sections

- A. Refer to Sketch ADD-5/S006
- B. Refer to Sketch ADD-5/S011
- C. Refer to Sketch ADD-5/S017

16. DRAWING S4.20 – Sections

- A. Refer to Sketch ADD-5/S010

17. DRAWING S4.21 – Sections

- A. Section 10/S4.21: Add dimension of (8”) for thickness of slab at bottom of pit.
- B. Section 12/S4.21: Add dimension of “4’-0” (MINIMUM) TYPICAL” from top of exterior site grading to bottom of footing at foundation wall below bottom step.
- C. Refer to Sketch ADD-5/S004

18. DRAWING S4.22 – Sections

- A. Sections 1/S4.22 & 5/S4.22: Change note at lintel angle from “L6x4 (GALV) W/ 8” BRG EA. END, TYP.” to “L6x4 (GALV & EPOXY PRIMED) W/ 8” BRG EA. END, REFER TO ARCH. DWG’S AND SPEC. 09 91 00 “PAINTING” FOR PAINTING REQUIREMENTS, TYP.”
- B. Refer to Sketch ADD-5/S012
- C. Refer to Sketch ADD-5/S014

19. DRAWING S4.23 – Sections

- A. Sections 7/S4.23 & 9/S4.23: Change note at lintel angle from “L6x4 (GALV) W/ 8” BRG EA. END, TYP.” to “L6x4 (GALV & EPOXY PRIMED) W/ 8” BRG EA. END, REFER TO ARCH. DWG’S AND SPEC. 09 91 00 “PAINTING” FOR PAINTING REQUIREMENTS, TYP.”

20. DRAWING S4.24 – Sections

- A. Section 1/S4.23, 2/S4.23, & 3/S4.23: Change lowest landing TSL from 777'-9 $\frac{3}{4}$ " to 777'-2 $\frac{3}{4}$ "

21. DRAWING S6.1 – Trusses

- A. Refer to Sketch ADD-5/S018

22. DRAWING S7.3 – Site Exterior Structures

- A. Refer to Sketch ADD-5/S-13

23. DRAWING S7.4 – Site Retaining Walls & Exterior Structures

- A. Section 3/S7.4: Add "Typical" to note at top of CMU wall anchorage to W14 steel beam. Note to be: "REFER TO 'TYPICAL CONNECTION OF CMU SHEAR WALLS & EXTERIOR WALLS TO STRUCTURAL STEEL,' S1.3, TYPICAL"

24. DRAWING S7.5 – Solar Canopy Site Structures

- A. At Bent 'A' Details: Change vertical reinforcing note from "(12) #7 Vert." to "(16) #7 Vert."




ATTACHMENTS

SKETCHES:


STRUCTURAL

1. ADD-5/S001 Curtainwall Dimension Coordination
2. ADD-5/S002 Curtainwall Dimension Coordination
3. ADD-5/S003 Curtainwall Dimension Coordination
4. ADD-5/S004 Curtainwall Dimension Coordination
5. ADD-5/S005 Stair #B3 and #B4 Coordination
6. ADD-5/S006 Stair Framing Coordination
7. ADD-5/S007 Foundation Wall Detail Coordination
8. ADD-5/S008 Foundation Wall Detail
9. ADD-5/S009 Pipe Trench Coordination
10. ADD-5/S010 Pipe Trench Coordination
11. ADD-5/S011 Foundation Wall Detail Coordination
12. ADD-5/S012 Girt Elevation Coordination
13. ADD-5/S013 Concrete Blast Wall & Transformer/Generator Pad Coordination
14. ADD-5/S014 Curtainwall Dimension Coordination
15. ADD-5/S015 Slab-on-Grade Depression Coordination
16. ADD-5/S016 Foundation Wall Dimension Coordination
17. ADD-5/S017 Curtainwall Dimension Coordination
18. ADD-5/S018 Horizontal Bracing Connection Coordination

END OF ADDENDUM #5

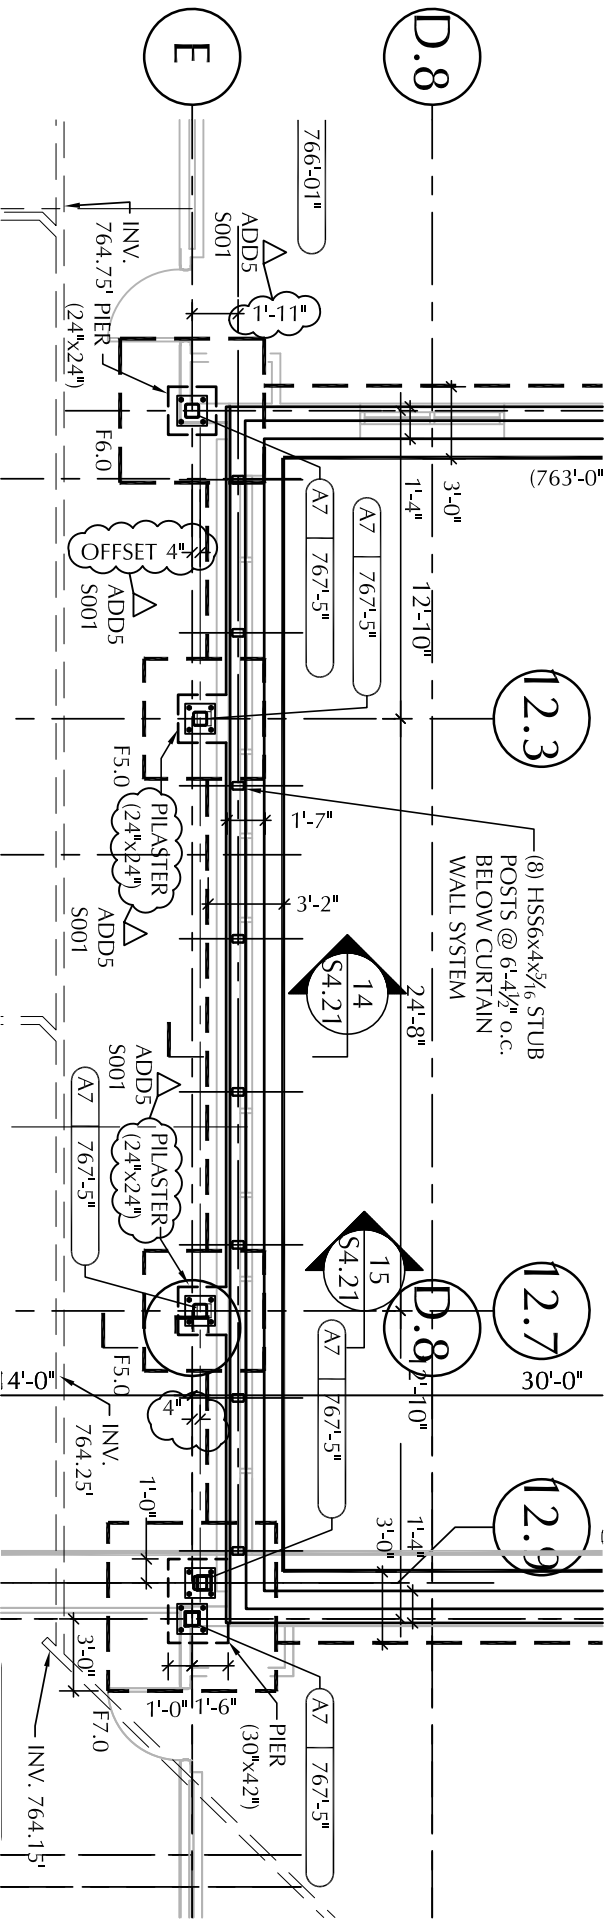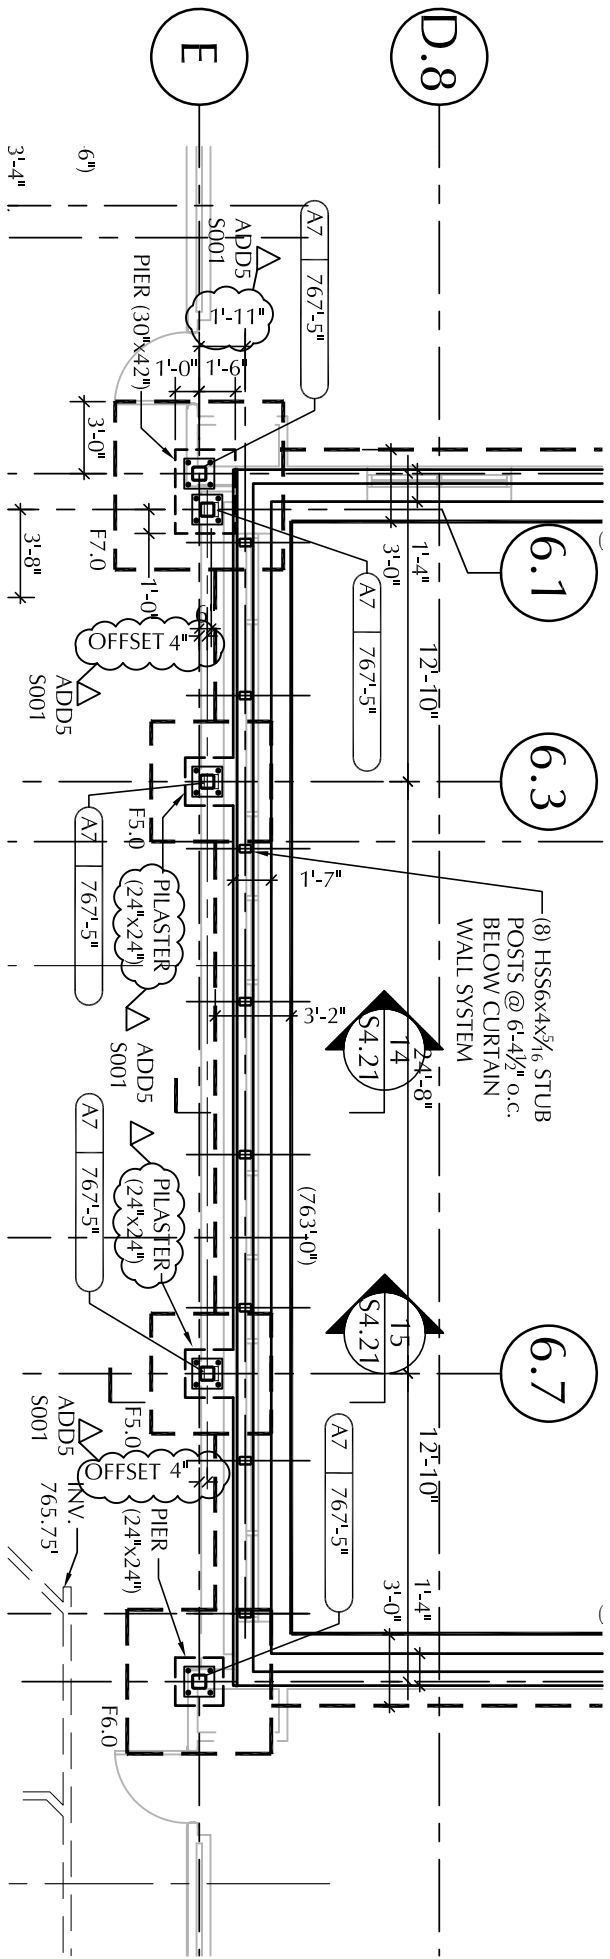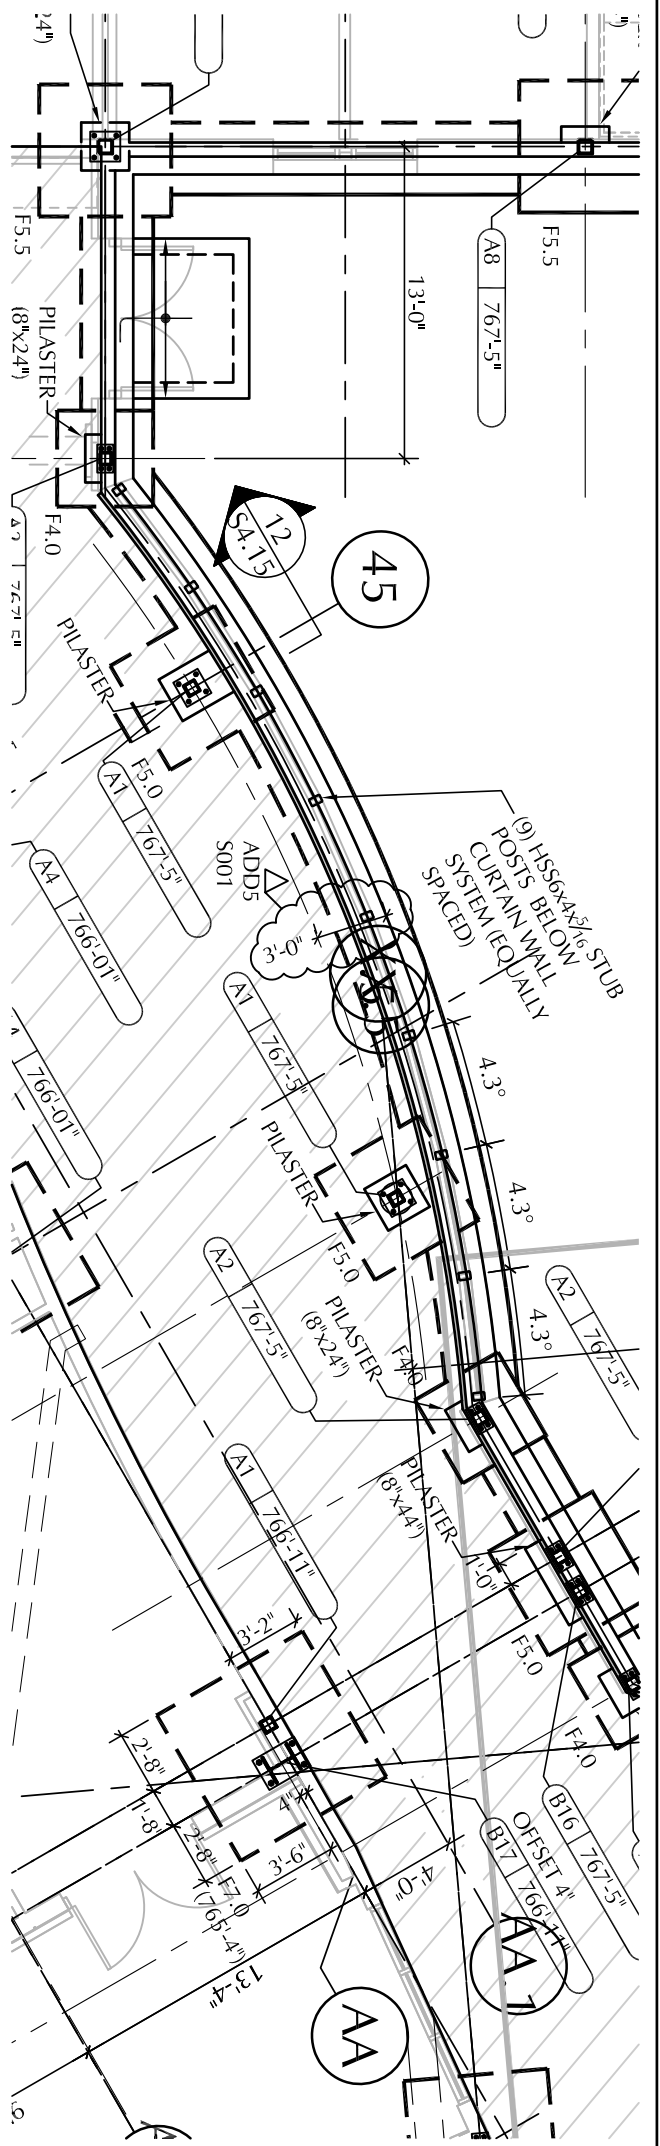

CLIENT INFORMATION:
Worcester Public Schools



City of Worcester
Massachusetts, 01605

PROJECT TITLE:
EARLY STRUCTURAL BID PACKAGE #3
South High Community School
170 Apricot Street, Worcester, MA 01603


DRAWING NAME:
Curtainwall Dimension Coordination

DATE:
12/27/2018


SCALE:
AS NOTED

SHEET REF. NO.
S3.3 & S3.4


DRAWING NUMBER:
ADD-5
S001

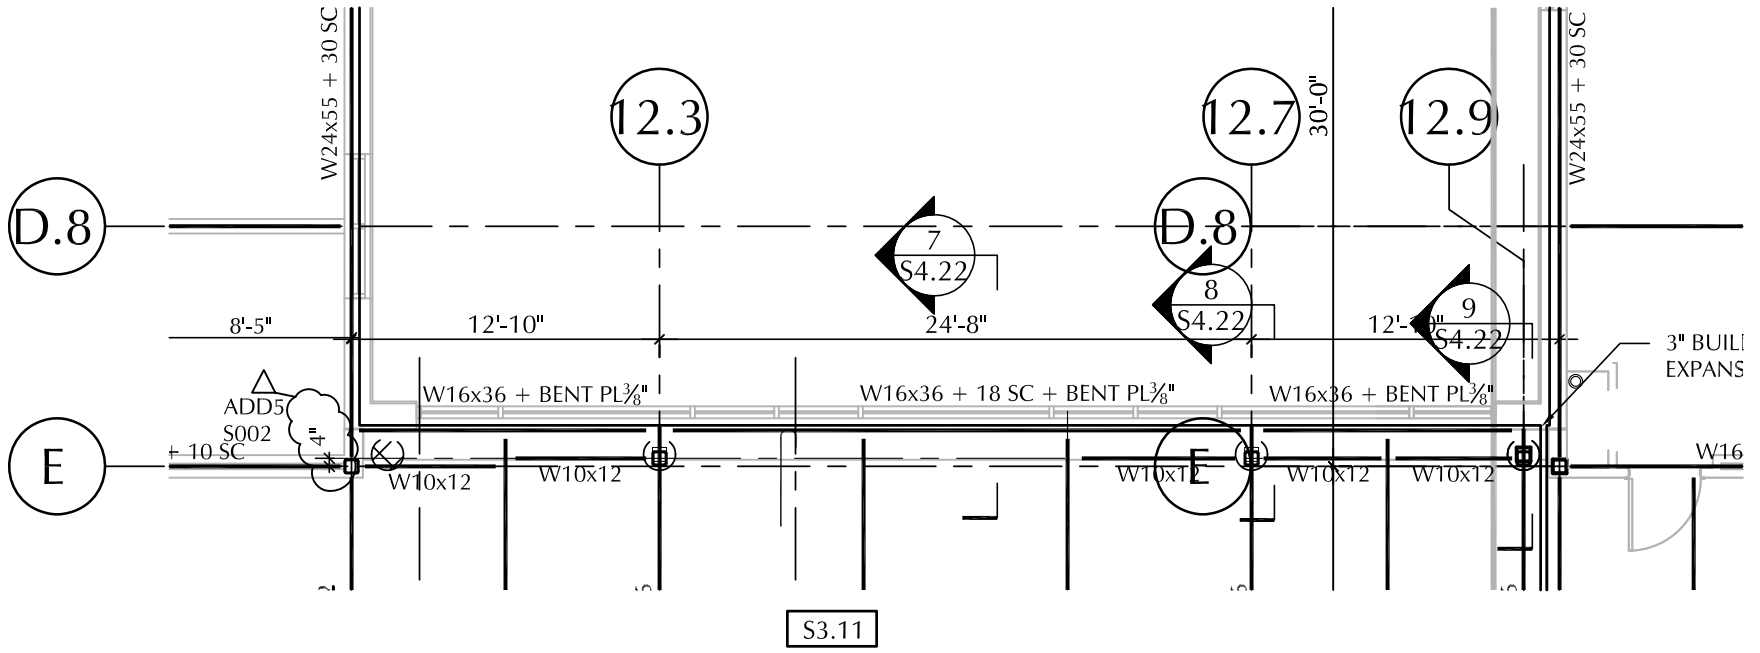


S3.11

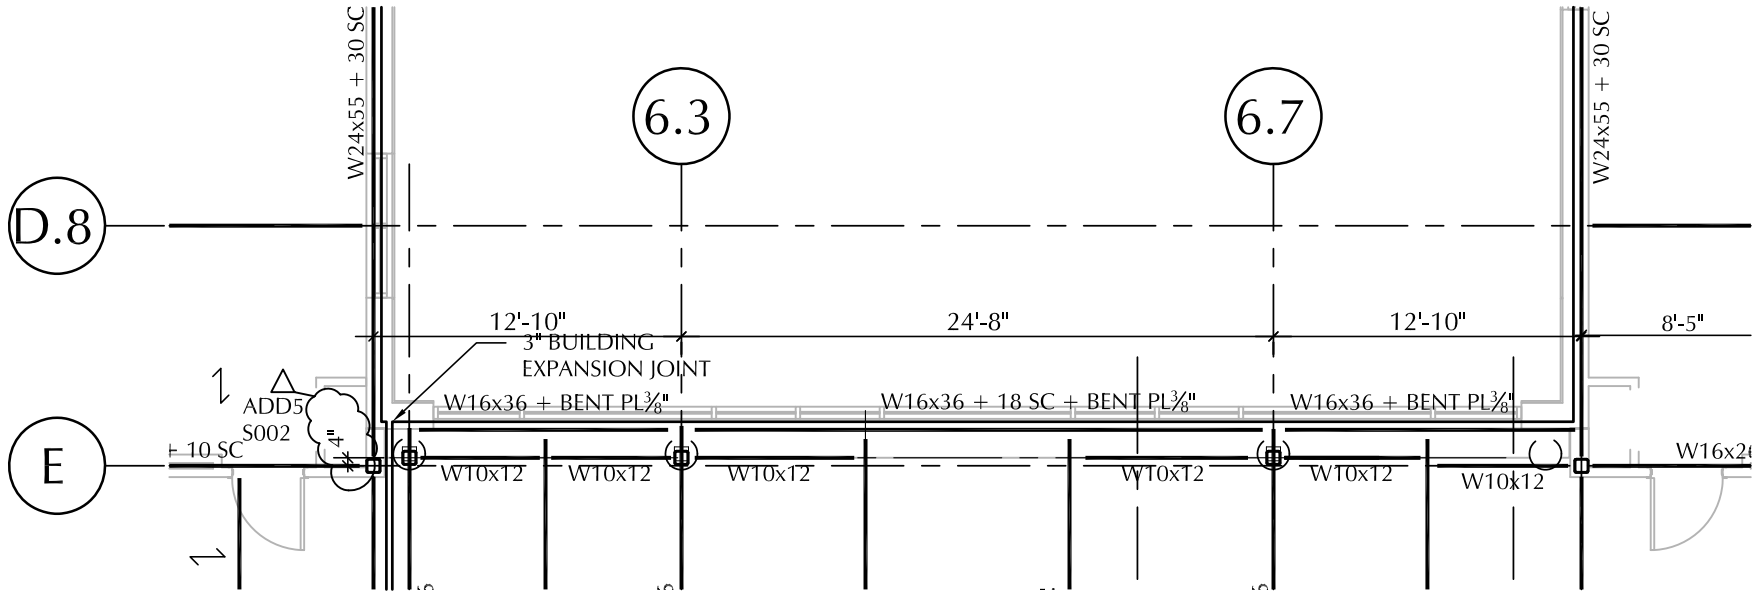

S3.11



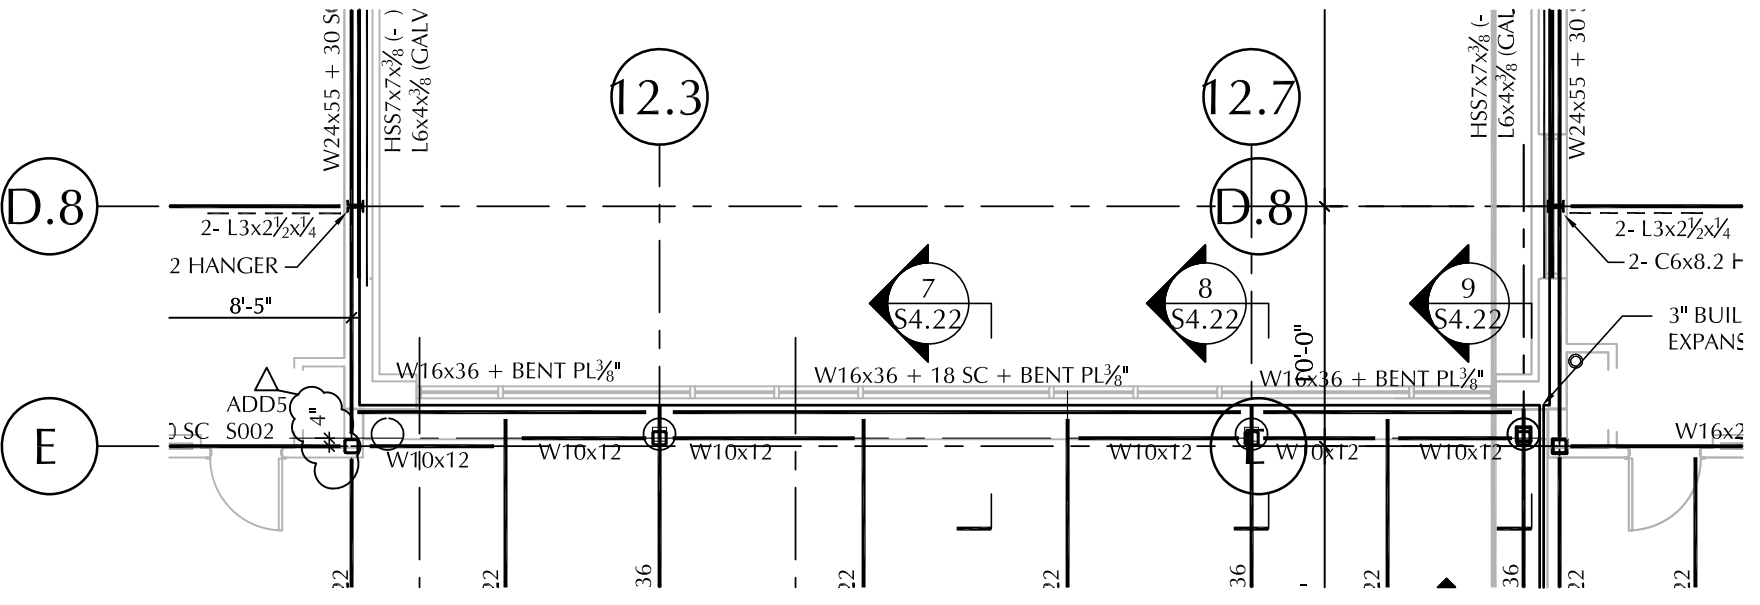


S3.7

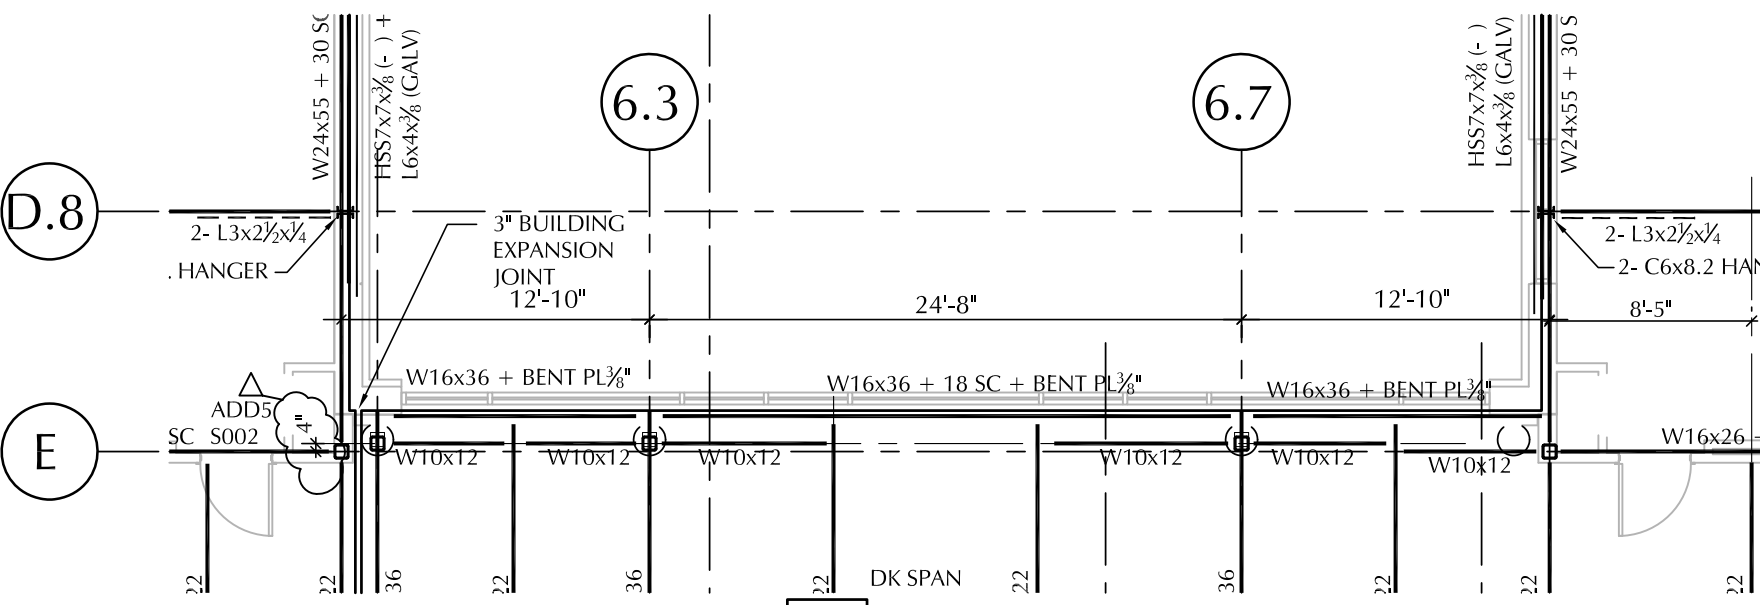

S3.7

 LAMOUREUX PAGANO ASSOCIATES, ARCHITECTS 108 GROVE STREET, SUITE 300 WORCESTER, MASSACHUSETTS 01605 MEMBER OF THE AMERICAN INSTITUTE OF ARCHITECTS	CLIENT INFORMATION: Worcester Public Schools	PROJECT TITLE: EARLY STRUCTURAL BID PACKAGE #3 South High Community School 170 Apricot Street, Worcester, MA 01603	DRAWING NAME: Curtainwall Dimension Coordination	SHEET REF. NO. S3.7 & S3.11	
	 City of Worcester Massachusetts, 01605			DATE: 12/27/2018	DRAWING NUMBER: ADD-5
					S002

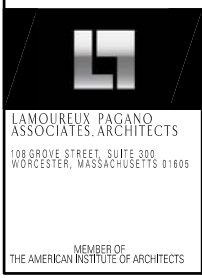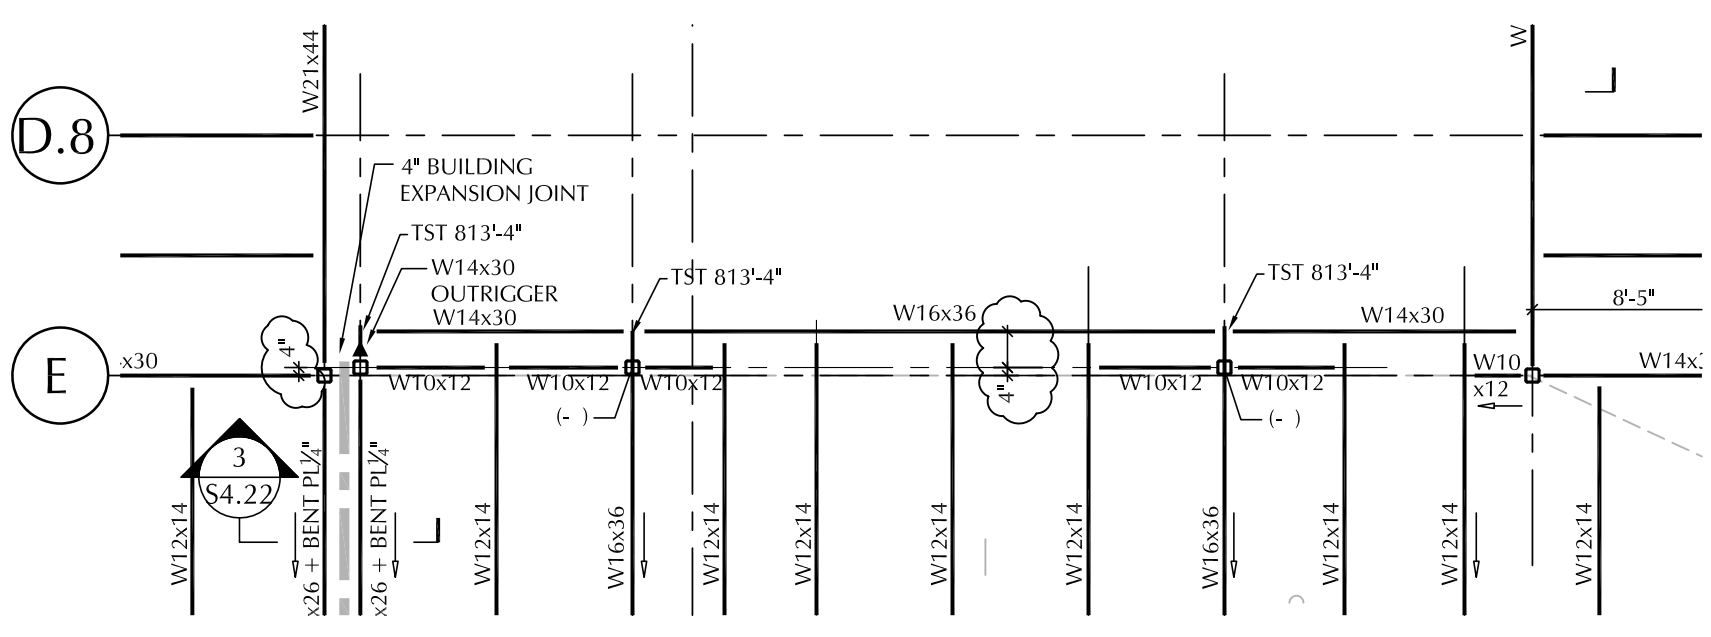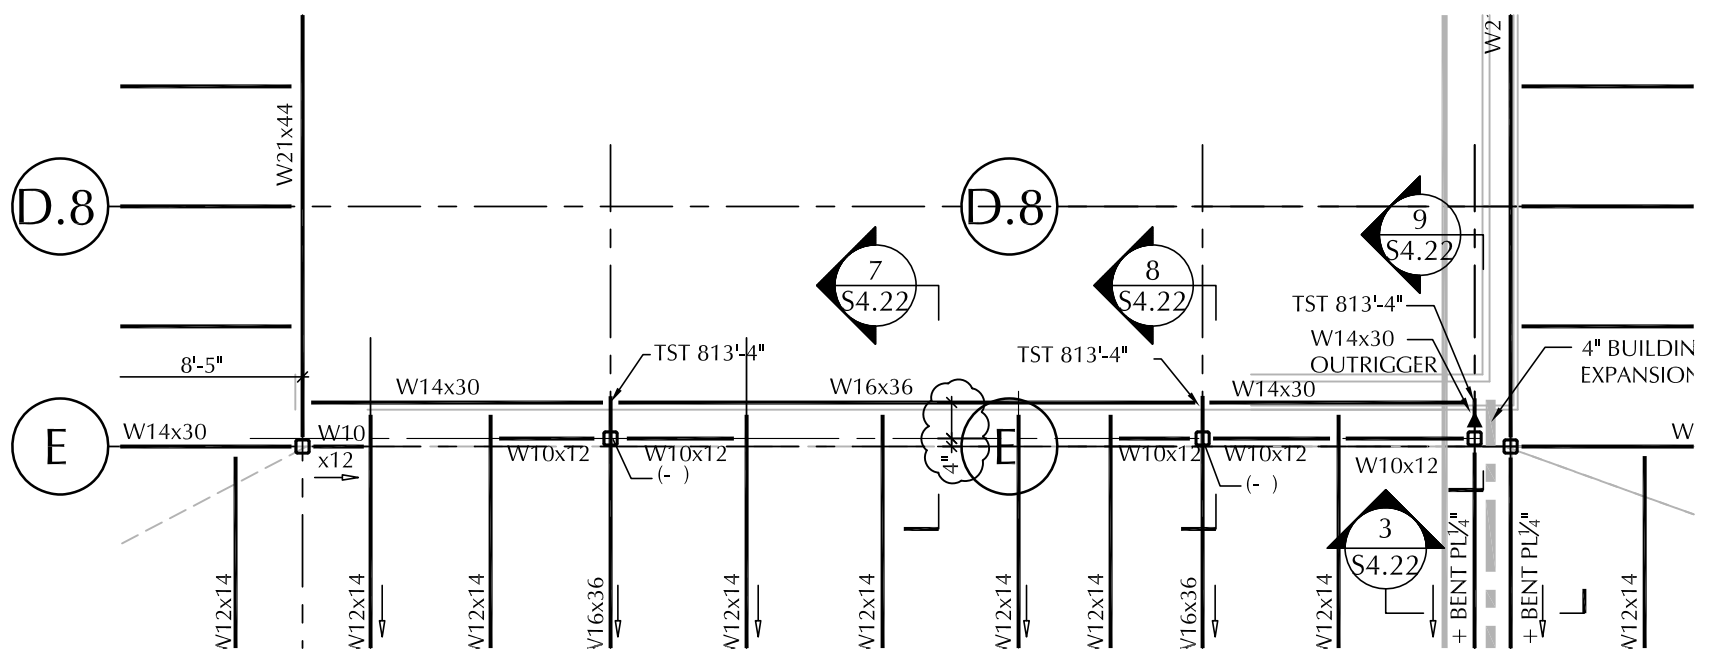

CLIENT INFORMATION:
Worcester Public Schools

City of Worcester
Massachusetts, 01605

PROJECT TITLE:
EARLY STRUCTURAL BID PACKAGE #3
South High Community School
170 Apricot Street, Worcester, MA 01603


DRAWING NAME:
Curtainwall Dimension Coordination

DATE:
12/27/2018


SCALE:
AS NOTED

SHEET REF. NO.
S3.15



DRAWING NUMBER:
ADD-5
S003

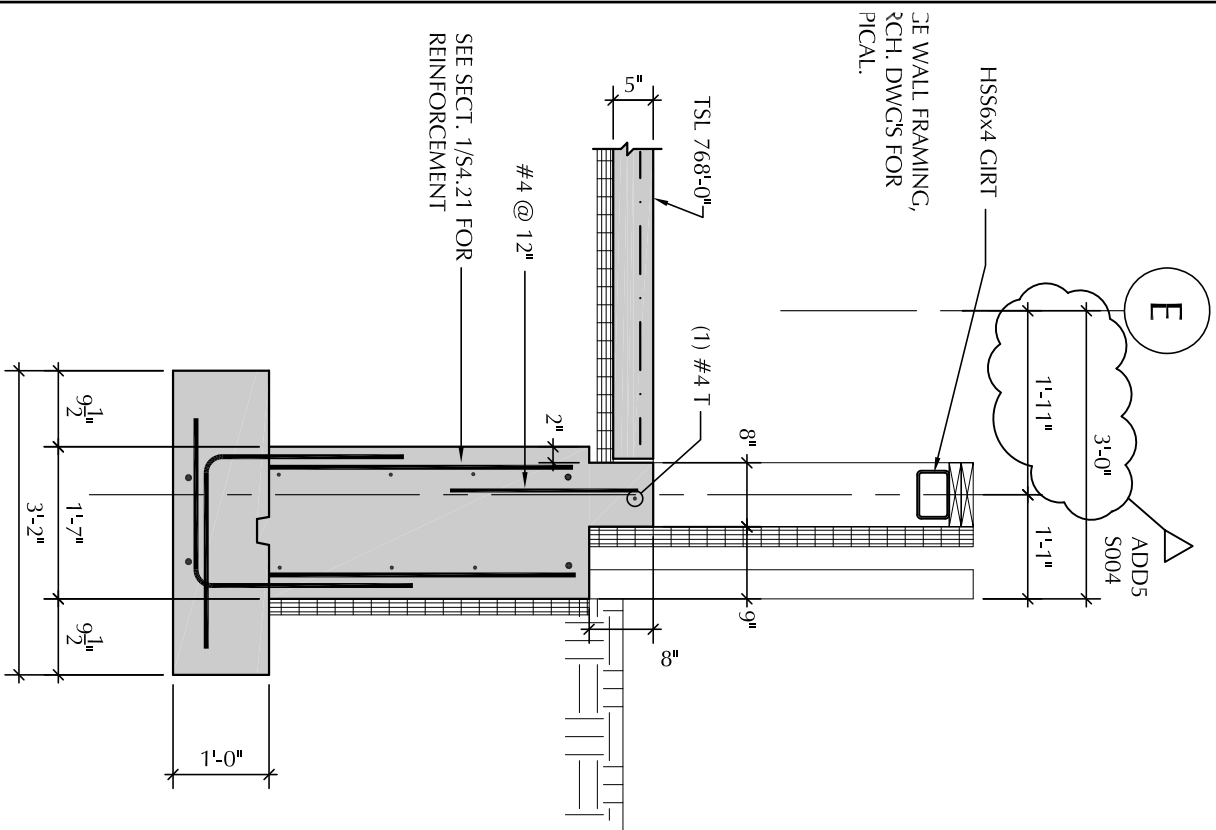

SECTION 14
SCALE: 1/2" = 1'-0"




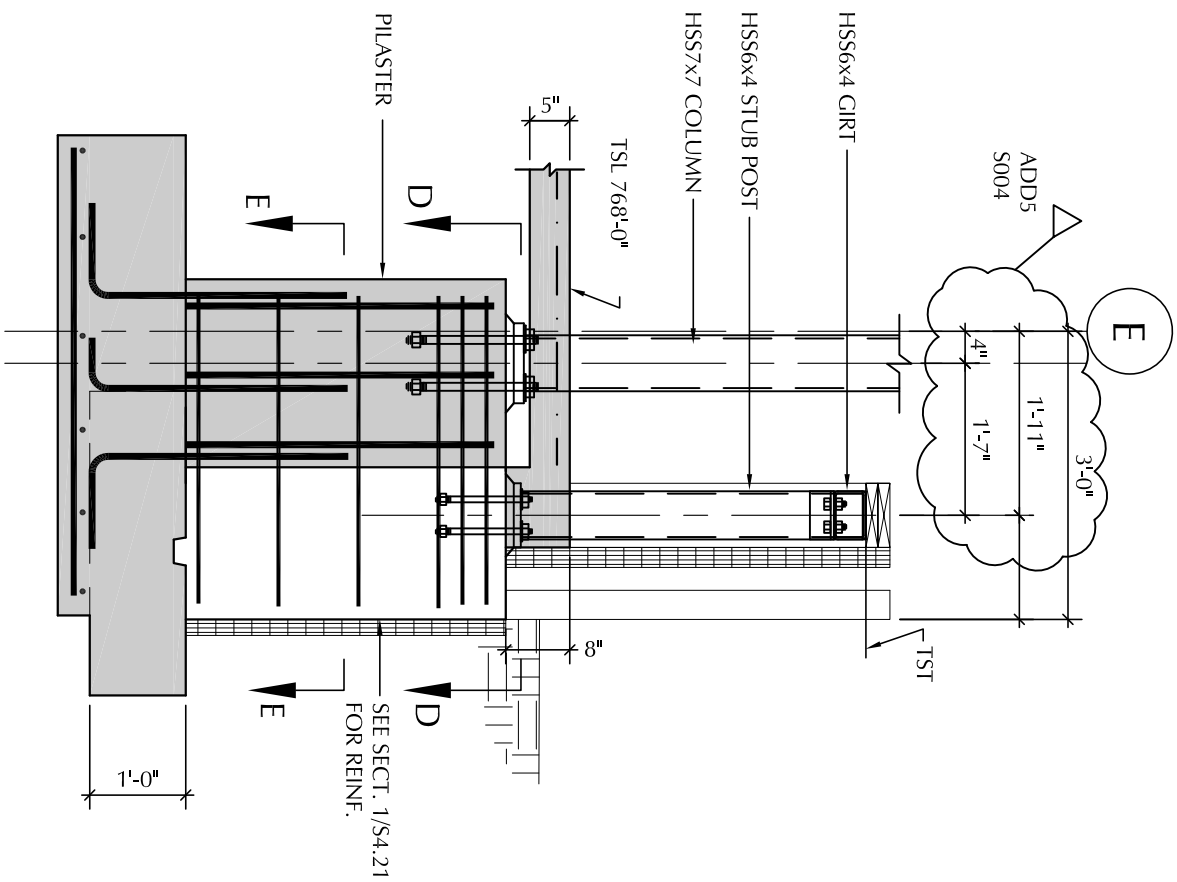


SECTION 15
SCALE: 1/2" = 1'-0"

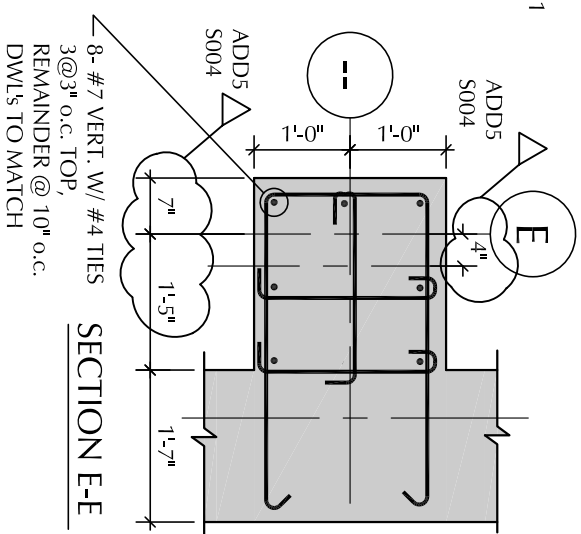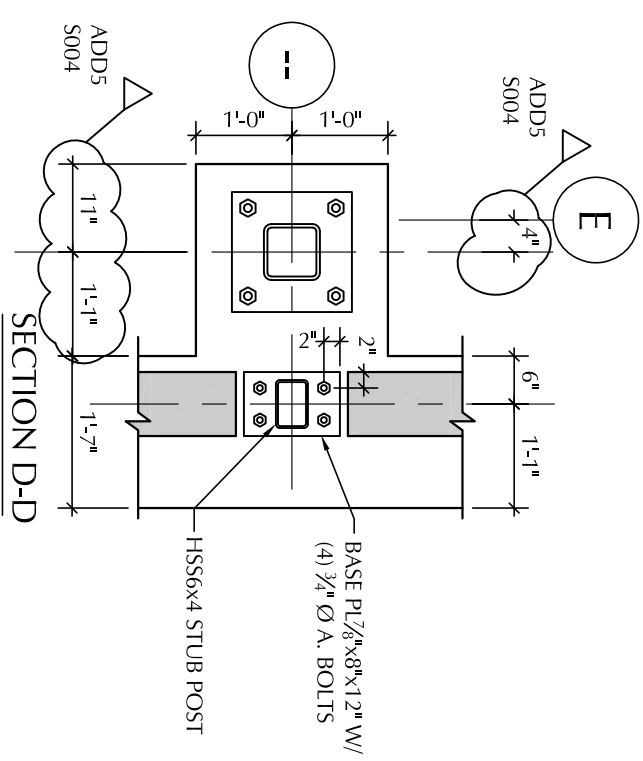


SCALE: 1/2" = 1'-0"

S4.21

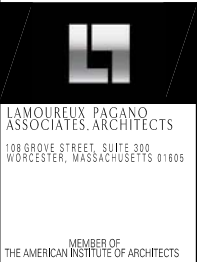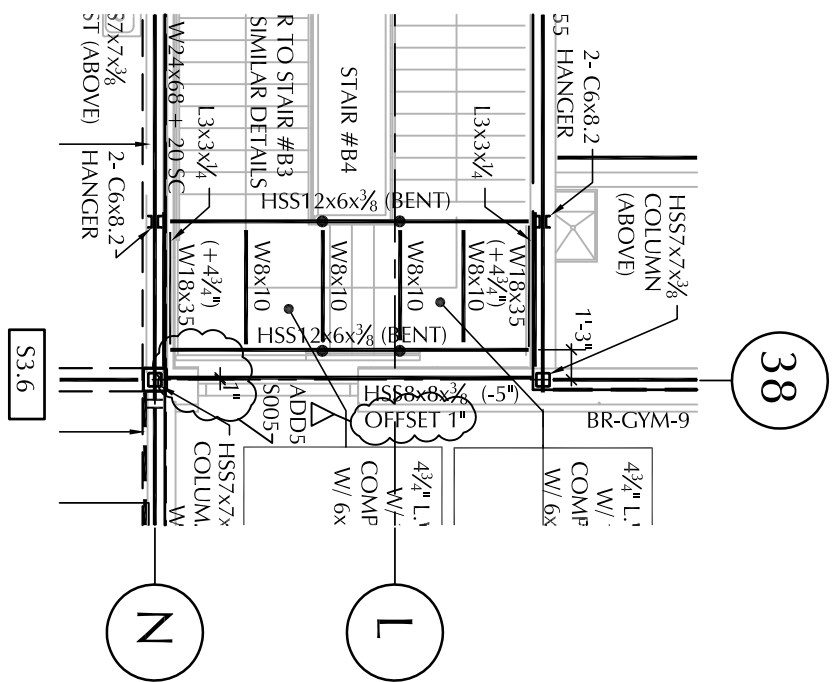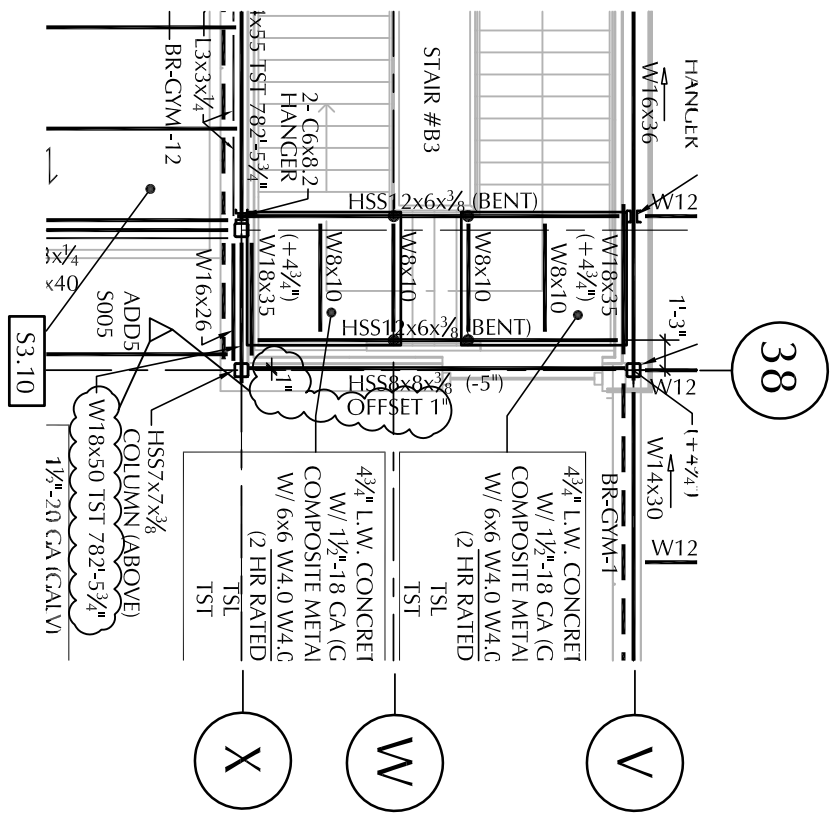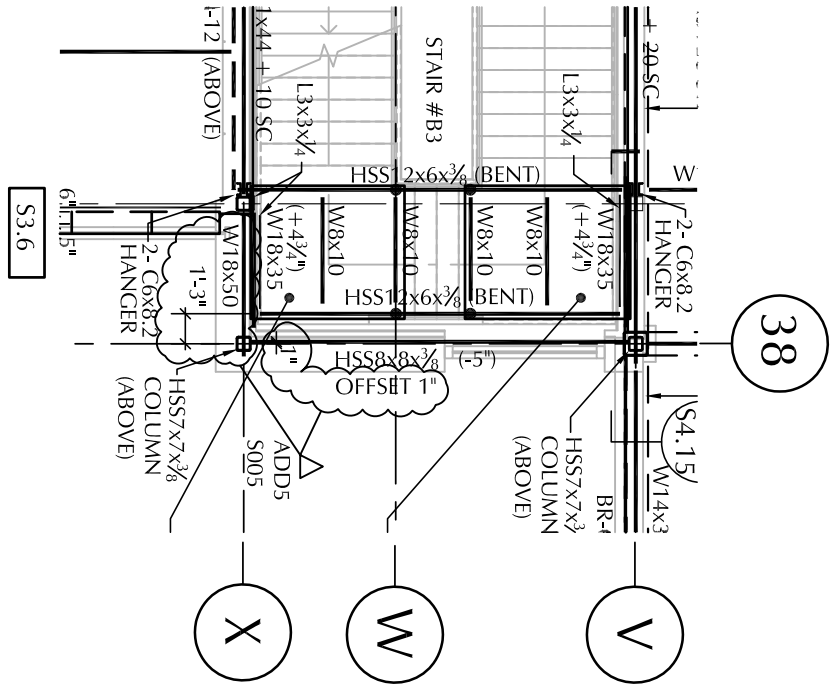

CLIENT INFORMATION:
Worcester Public Schools



City of Worcester
Massachusetts, 01605

PROJECT TITLE:
EARLY STRUCTURAL BID PACKAGE #3

South High Community School

170 Apricot Street, Worcester, MA 01603


DRAWING NAME:
Stair #B3 and #B4 Coordination

DATE:
12/27/2018

SCALE:
3/8" = 1'-0"



SHEET REF. NO.
S3.7 & S3.11

DRAWING NUMBER:
ADD-5
S005

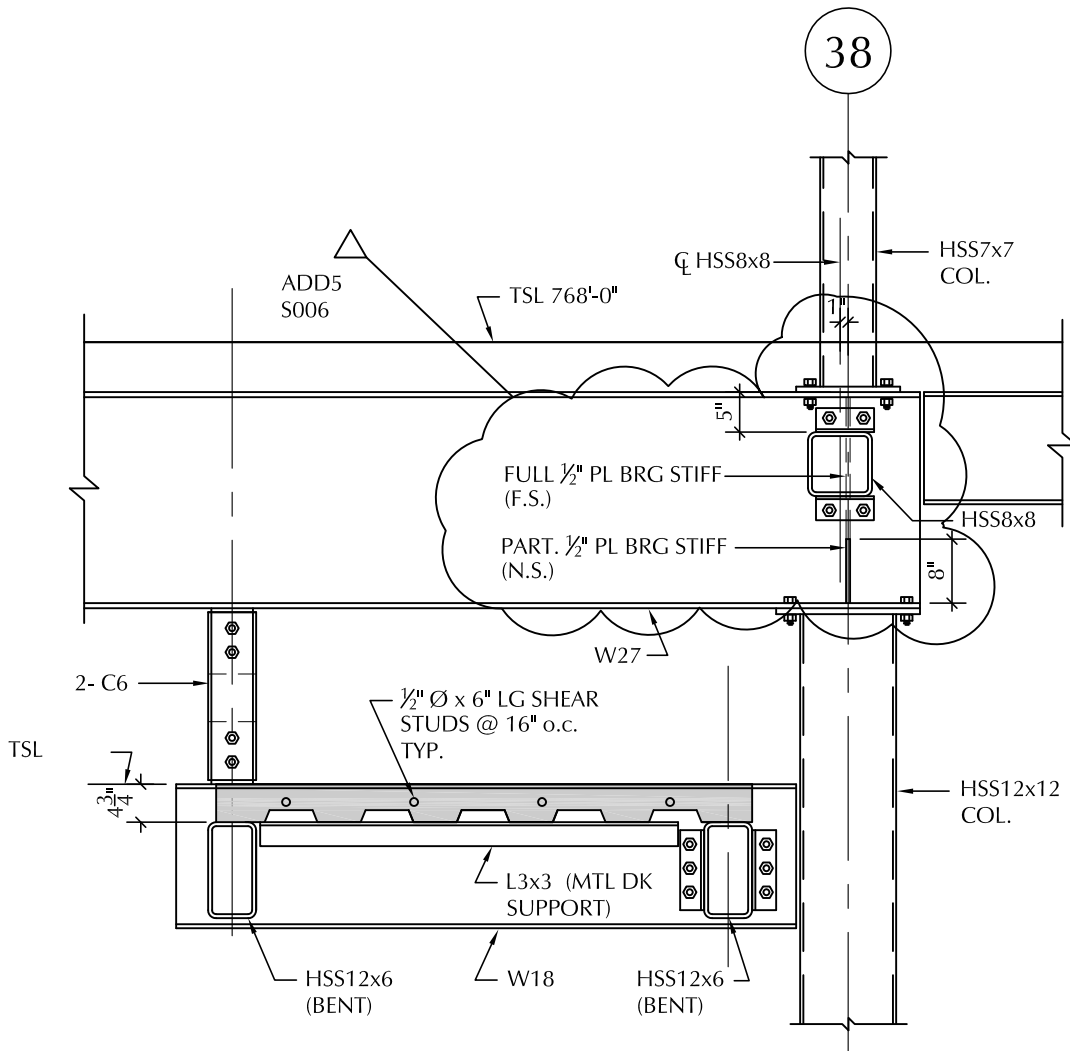

STAIR #B3
(STAIR #B4 SIMILAR)

SECTION 13
 SCALE: 1/2" = 1'-0" S4.15

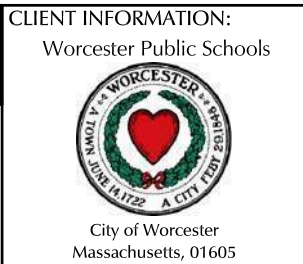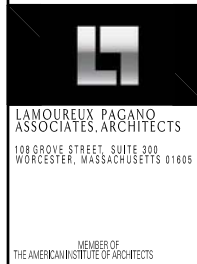

PROJECT TITLE:
 EARLY STRUCTURAL BID PACKAGE #3

South High Community School
 170 Apricot Street, Worcester, MA 01603

DRAWING NAME:
 Stair Framing Coordination

DATE:
 12/27/2018

SCALE:
 1/2" = 1'-0"

REFERENCE:

SHEET REF. NO.
 S4.15

DRAWING NUMBER:
ADD-5
S006


31.1

ADD5
S008

MASONRY VENEER, SEE ARCH.
DWG'S, TYP.

NOTE: MASONRY SHELF TO BE
LOCATED BELOW GRADE, G.C.
TO VERIFY DIMENSION WITH
FINISH GRADES, TYPICAL

FINISH GRADE, G.C. COORD.
W/ SITE DRAWINGS, TYPICAL

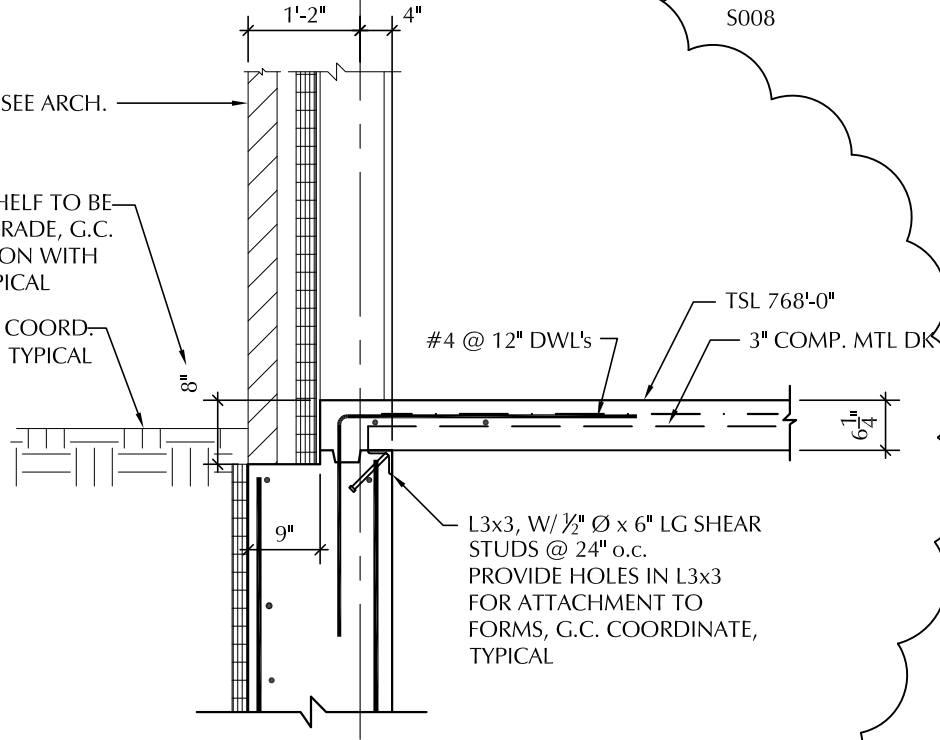

SECTION

14

SCALE: 1/2" = 1'-0"

S4.11

38

LAMOUREUX PAGANO
ASSOCIATES, ARCHITECTS
108 GROVE STREET, SUITE 300
WORCESTER, MASSACHUSETTS 01605

MEMBER OF
THE AMERICAN INSTITUTE OF ARCHITECTS

CLIENT INFORMATION:
Worcester Public Schools

City of Worcester
Massachusetts, 01605

PROJECT TITLE:
EARLY STRUCTURAL BID
PACKAGE #3

**South High
Community School**

170 Apricot Street, Worcester, MA 01603

DRAWING NAME:
Foundation Wall Detail



DATE:
12/27/2018

SCALE:
1/2" = 1'-0"

REFERENCE:

SHEET REF. NO.
S4.11

DRAWING NUMBER:
ADD-5
S008

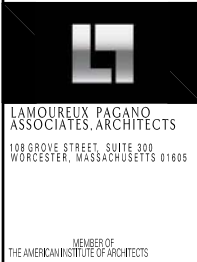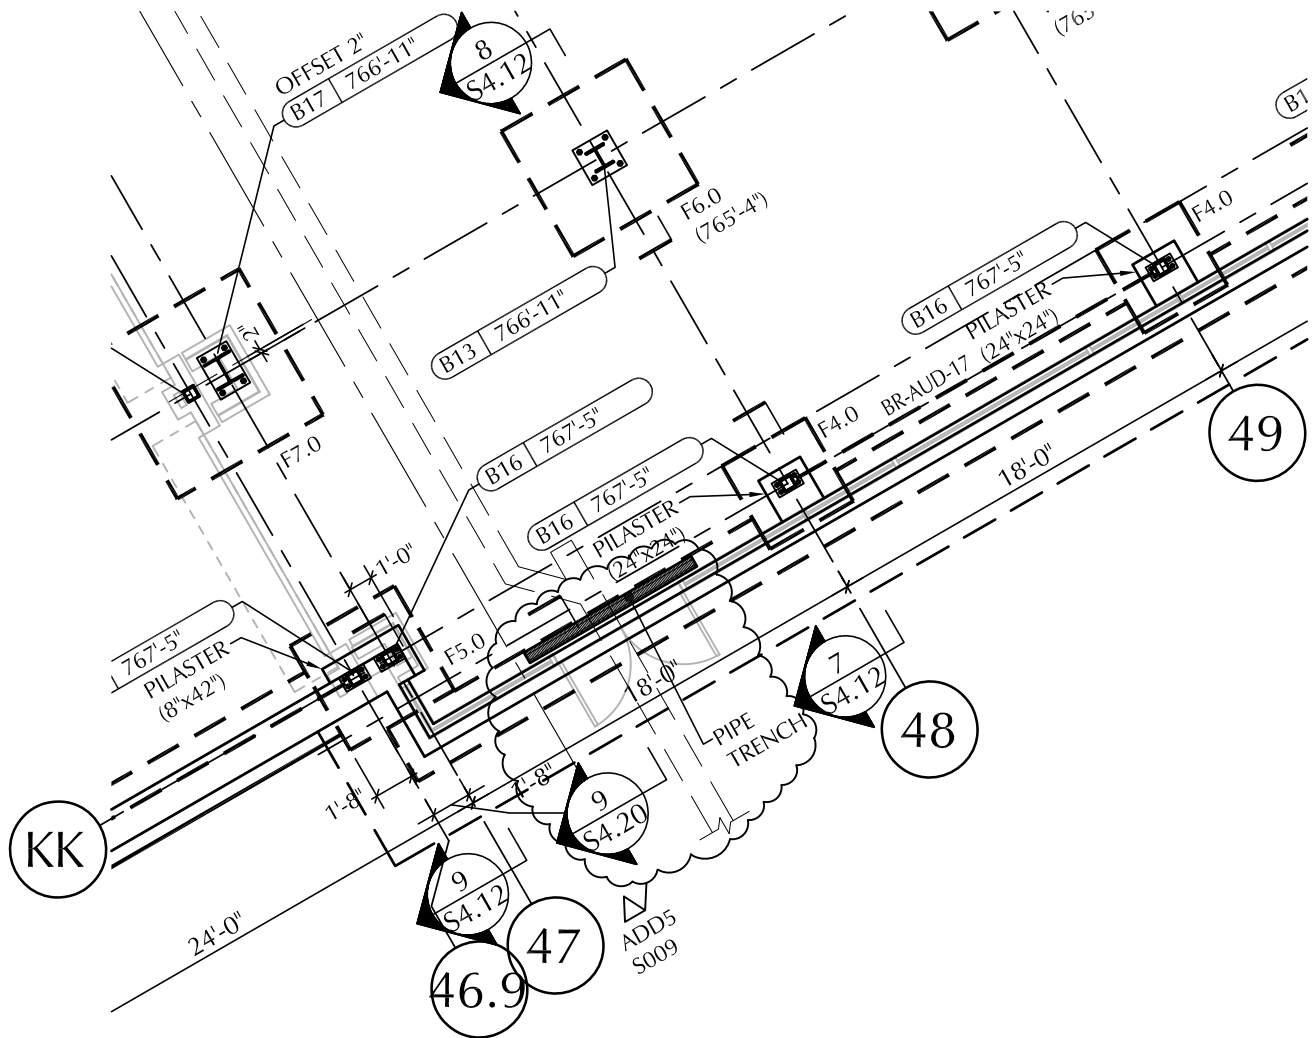

CLIENT INFORMATION:
Worcester Public Schools

City of Worcester
Massachusetts, 01605

PROJECT TITLE:
EARLY STRUCTURAL BID
PACKAGE #3

South High Community School

170 Apricot Street, Worcester, MA 01603

DRAWING NAME:
Pipe Trench
Coordination


DATE:
12/27/2018

SCALE:
1/8" = 1'-0"

REFERENCE:

SHEET REF. NO.
S3.4

DRAWING NUMBER:
ADD-5
S009

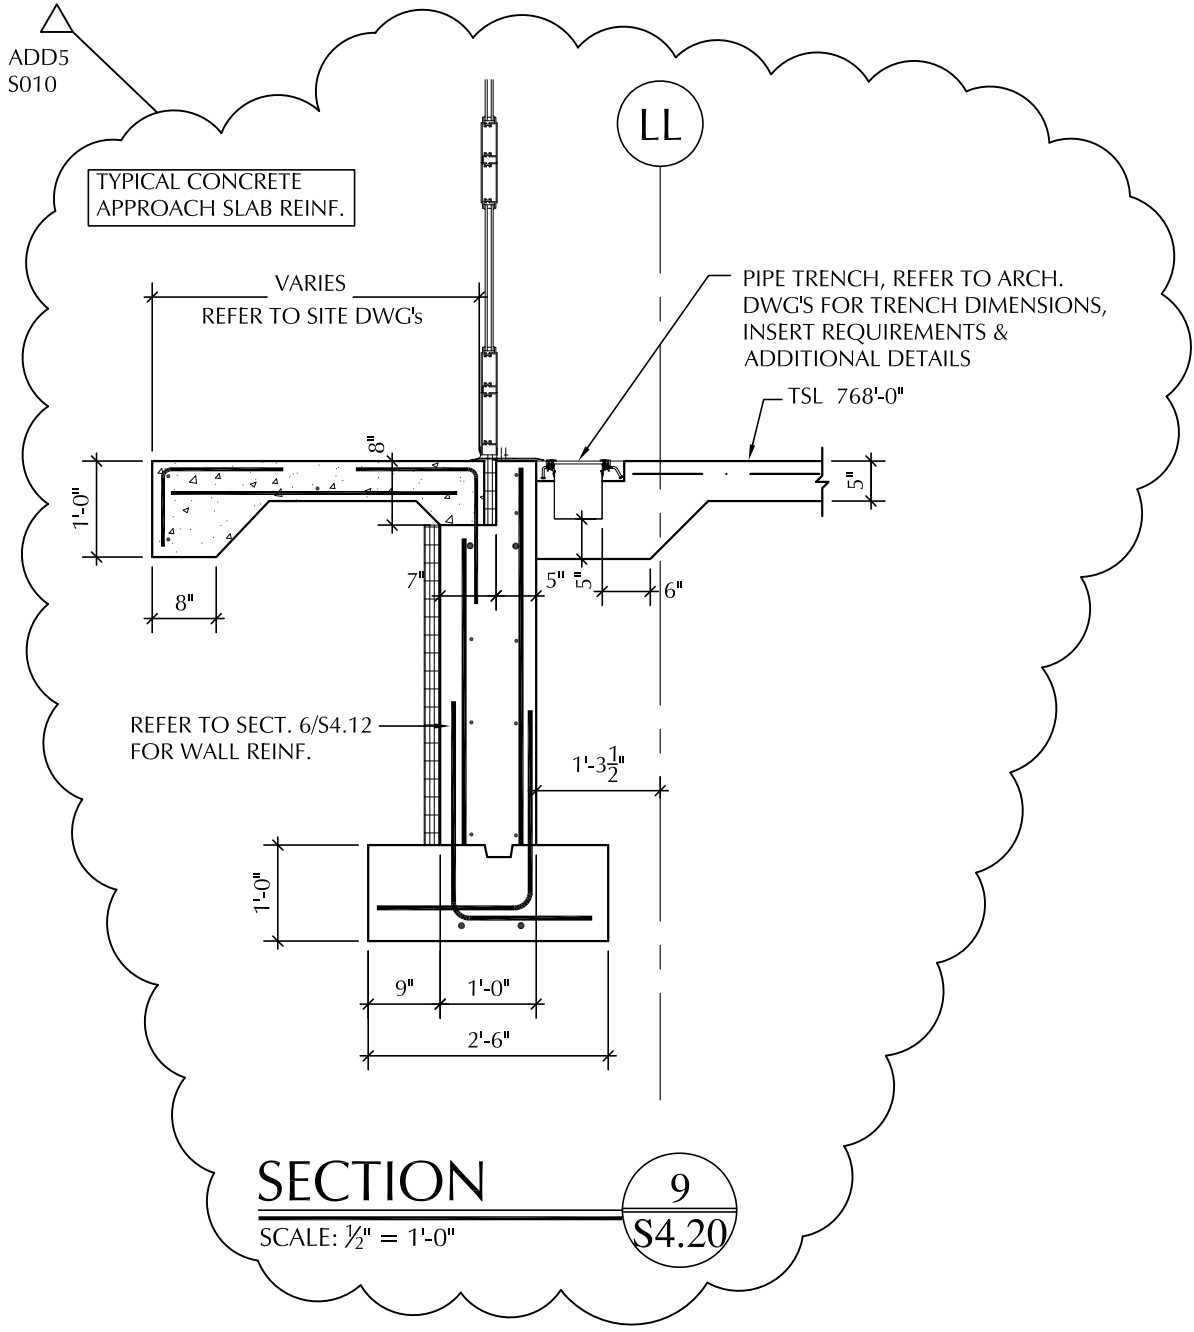

SECTION 9
 SCALE: 1/2" = 1'-0"
S4.20



CLIENT INFORMATION:
 Worcester Public Schools

City of Worcester
 Massachusetts, 01605

PROJECT TITLE:
 EARLY STRUCTURAL BID
 PACKAGE #3

**South High
 Community School**

170 Apricot Street, Worcester, MA 01603

DRAWING NAME:
 Pipe Trench
 Coordination




DATE:
 12/27/2018

SCALE:
 1/2" = 1'-0"


REFERENCE:

SHEET REF. NO.
 S4.20

DRAWING NUMBER:
ADD-5
S010

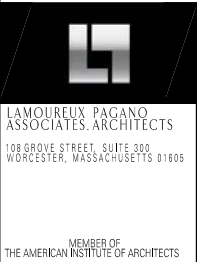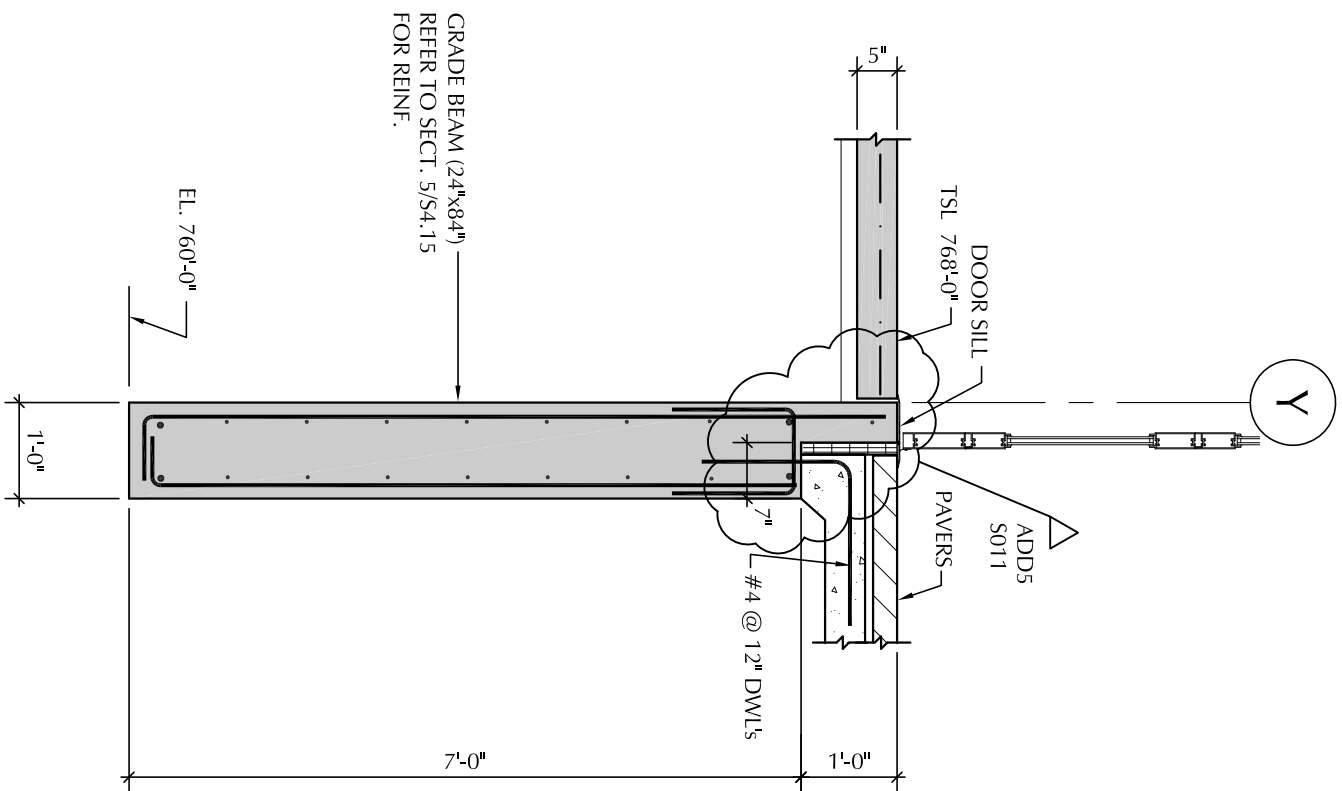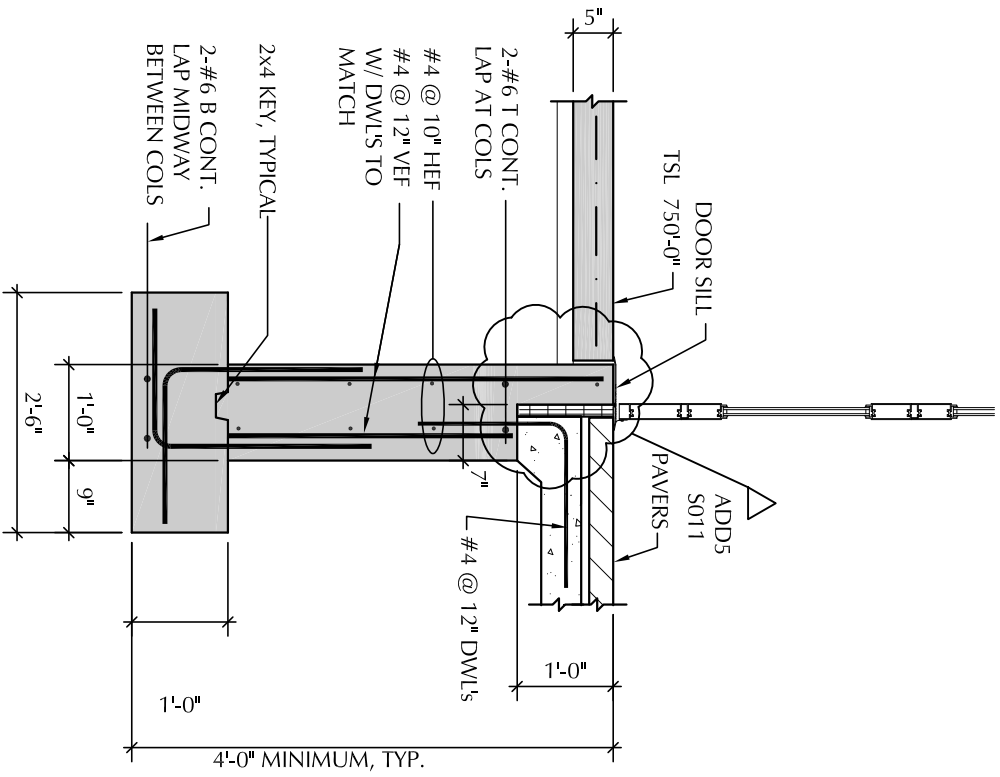

CLIENT INFORMATION:
Worcester Public Schools



City of Worcester
Massachusetts, 01605

PROJECT TITLE:
EARLY STRUCTURAL BID PACKAGE #3
South High Community School
170 Apricot Street, Worcester, MA 01603


DRAWING NAME:
Foundation Wall Detail
Coordination

DATE:
12/27/2018

SCALE:
AS NOTED

SHEET REF. NO.
S4.14 & S4.15

DRAWING NUMBER:
ADD-5
S011

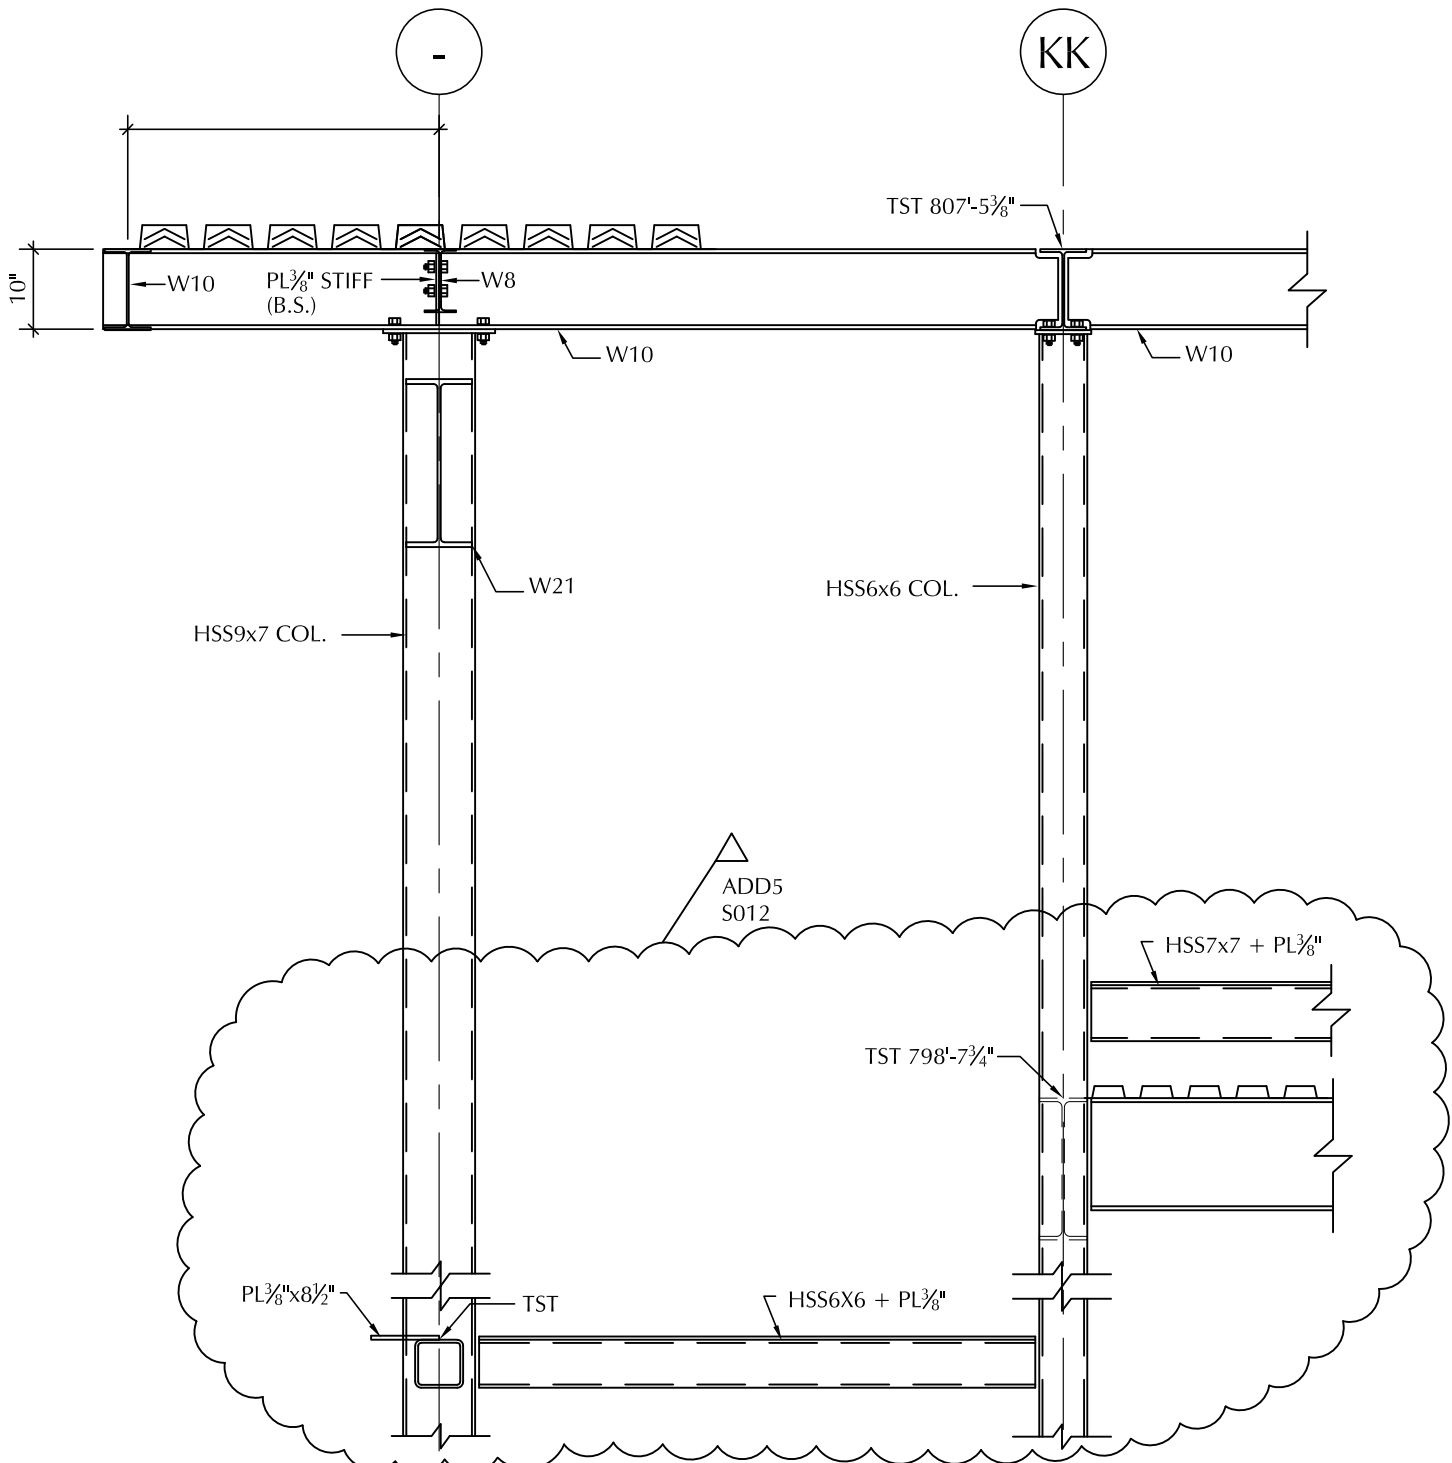

SECTION

16
S4.22


SCALE: 1/2" = 1'-0"



LAMOUREUX PAGANO
ASSOCIATES, ARCHITECTS
108 GROVE STREET, SUITE 300
WORCESTER, MASSACHUSETTS 01605

MEMBER OF
THE AMERICAN INSTITUTE OF ARCHITECTS

CLIENT INFORMATION:
Worcester Public Schools



City of Worcester
Massachusetts, 01605

PROJECT TITLE:
EARLY STRUCTURAL BID
PACKAGE #3

**South High
Community School**

170 Apricot Street, Worcester, MA 01603

DRAWING NAME:
Girt Elevation
Coordination

DATE:
12/27/2018


SCALE:
1/2" = 1'-0"

REFERENCE:

SHEET REF. NO.
S4.22

DRAWING NUMBER:
ADD-5
S012

NOTE: REFER TO ARCHITECTURAL, LANDSCAPE AND ELECTRICAL DRAWINGS FOR LOCATIONS AND GEOMETRY OF NEW CONCRETE BLAST WALLS, GENERATOR PADS, & TRANSFORMER PADS. C.C. TO COORDINATE SUPPORTED EXCAVATION AT NEW CONCRETE BLAST WALLS ADJACENT TO EXISTING TRANSFORMER & GENERATOR PADS, TYPICAL.

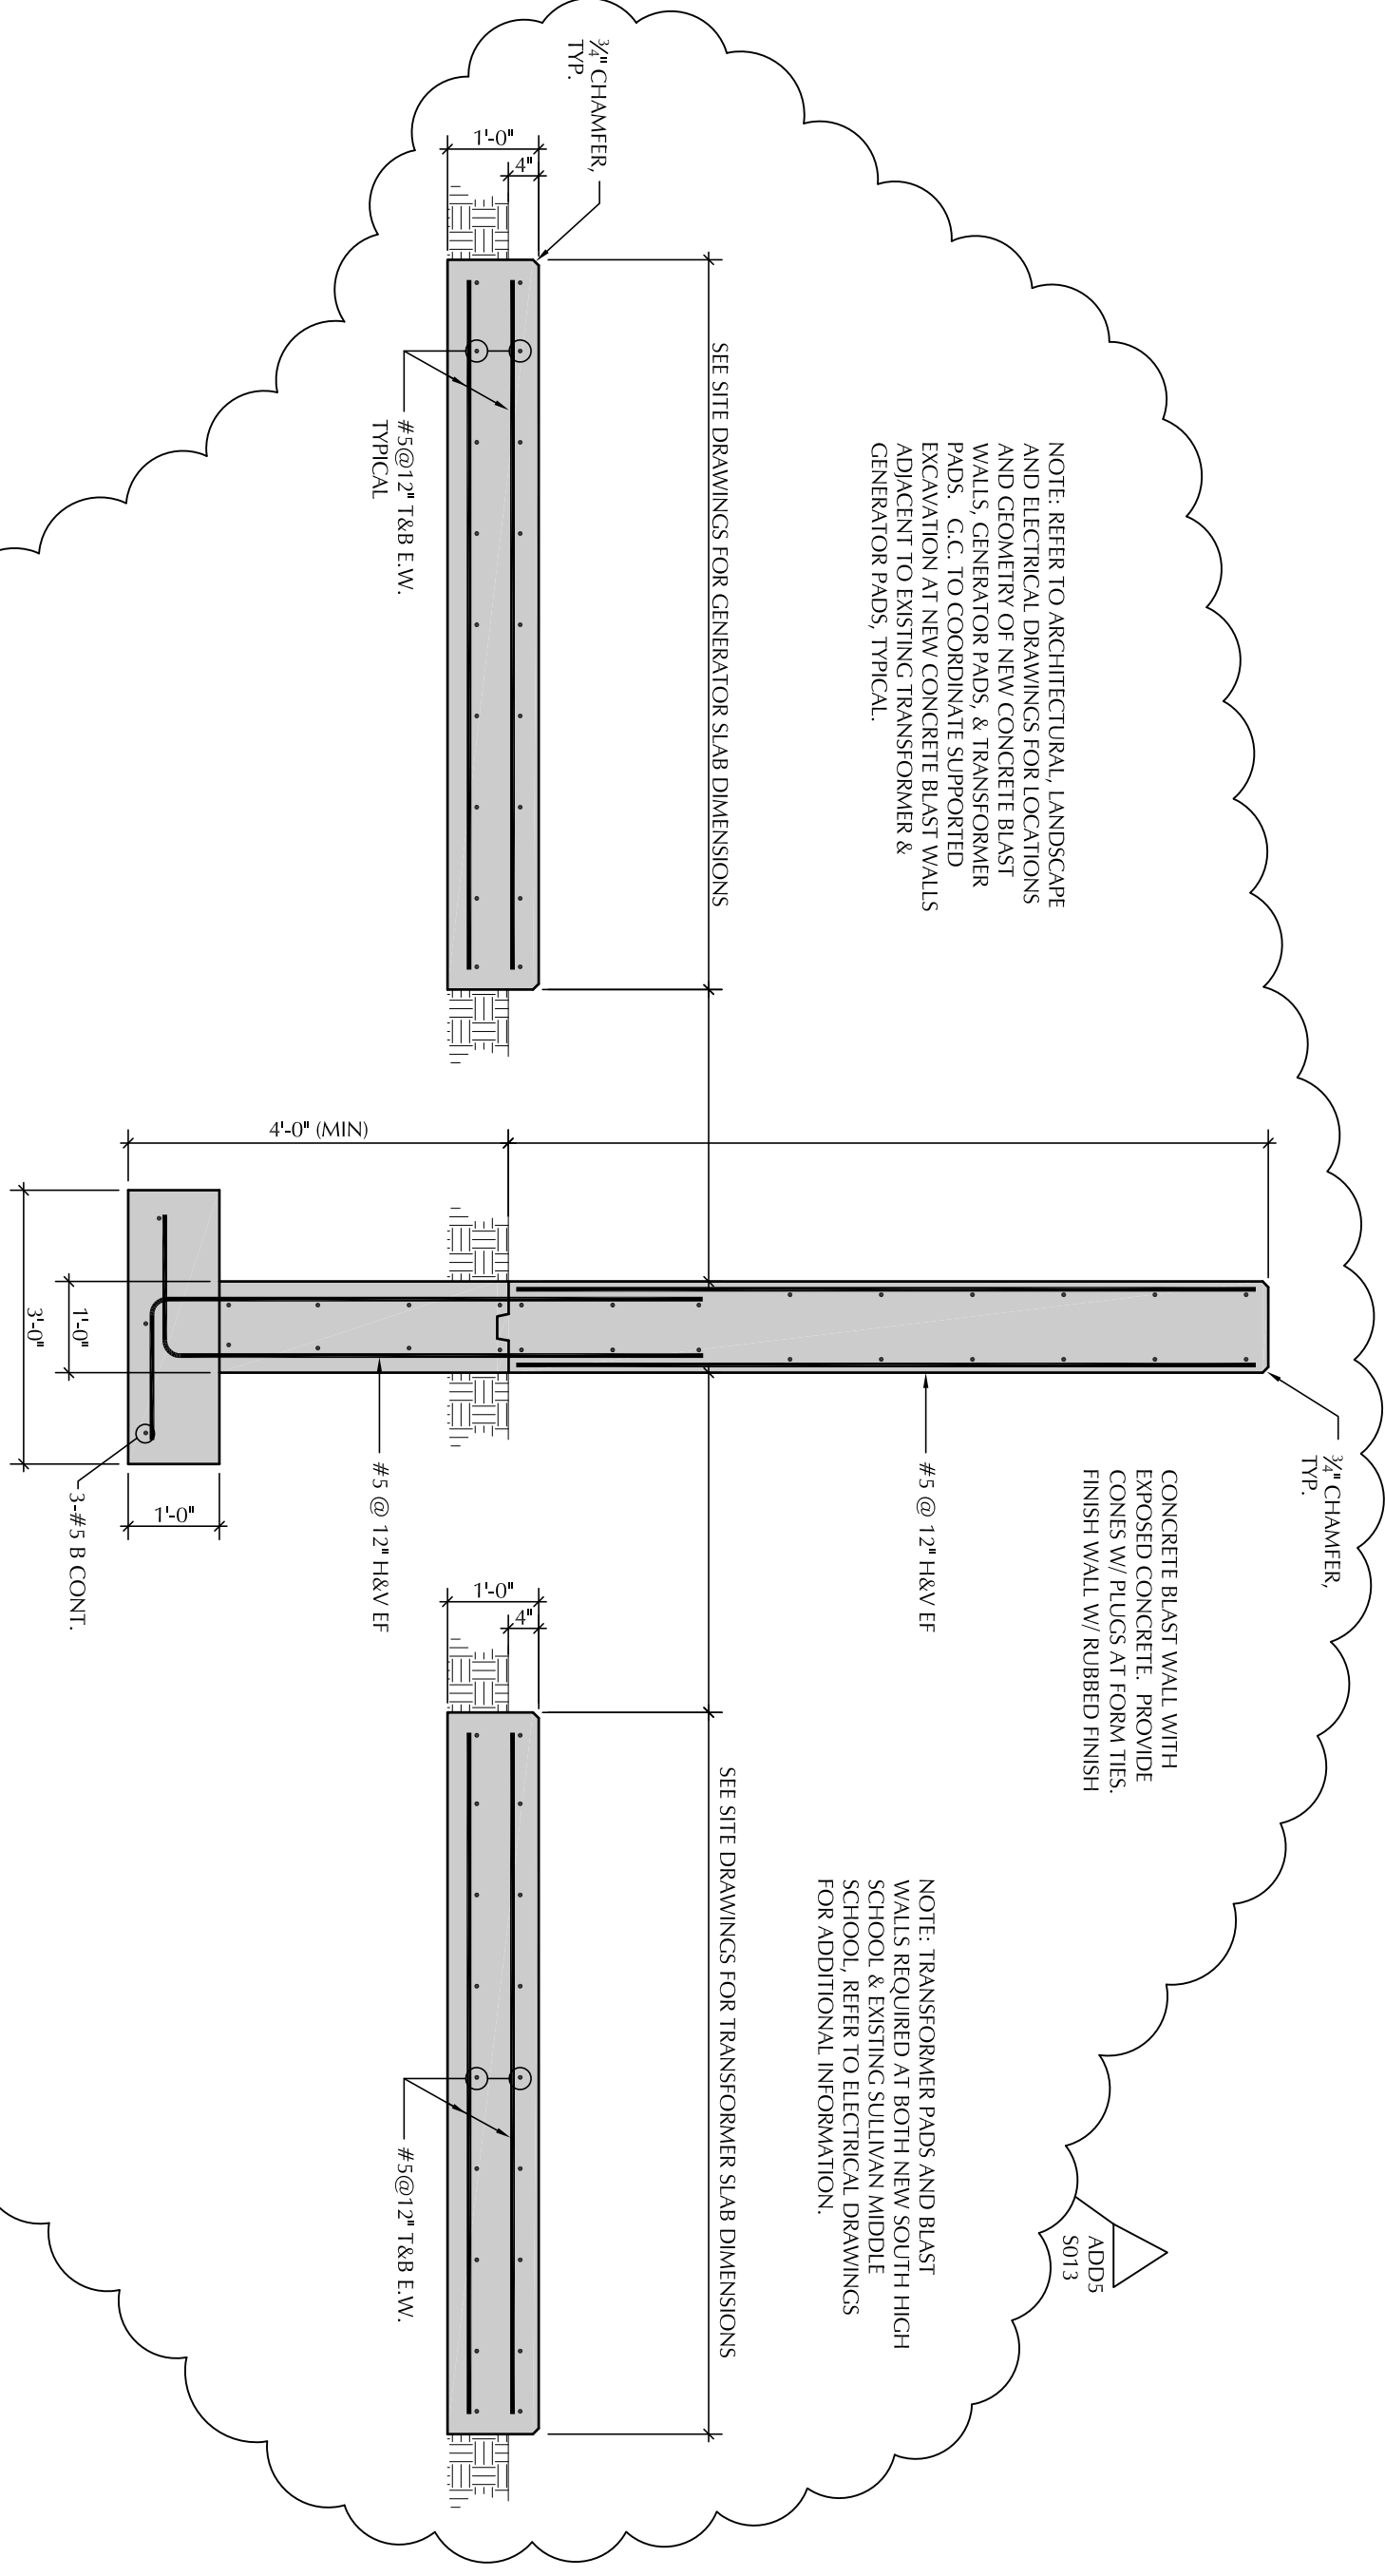


CONCRETE BLAST WALL WITH EXPOSED CONCRETE. PROVIDE CONES W/ PLUGS AT FORM TIES. FINISH WALL W/ RUBBED FINISH

NOTE: TRANSFORMER PADS AND BLAST WALLS REQUIRED AT BOTH NEW SOUTH HIGH SCHOOL & EXISTING SULLIVAN MIDDLE SCHOOL, REFER TO ELECTRICAL DRAWINGS FOR ADDITIONAL INFORMATION.

SECTION THRU GENERATOR & TRANSFORMER PADS WITH CONCRETE BLAST WALL

SCALE: 1/2" = 1'-0"

 108 GROVE STREET, SUITE 300 WORCESTER, MASSACHUSETTS 01605 MEMBER OF THE AMERICAN INSTITUTE OF ARCHITECTS	CLIENT INFORMATION: Worcester Public Schools  City of Worcester Massachusetts, 01605	PROJECT TITLE: EARLY STRUCTURAL BID PACKAGE #3 South High Community School 170 Apricot Street, Worcester, MA 01603	DRAWING NAME: Concrete Blast Wall & Transformer/ Generator Pad Coordination	SHEET REF. NO. S7.3
	DATE: 12/27/2018	DRAWING NUMBER: ADD-5 S013		
	SCALE: AS NOTED			

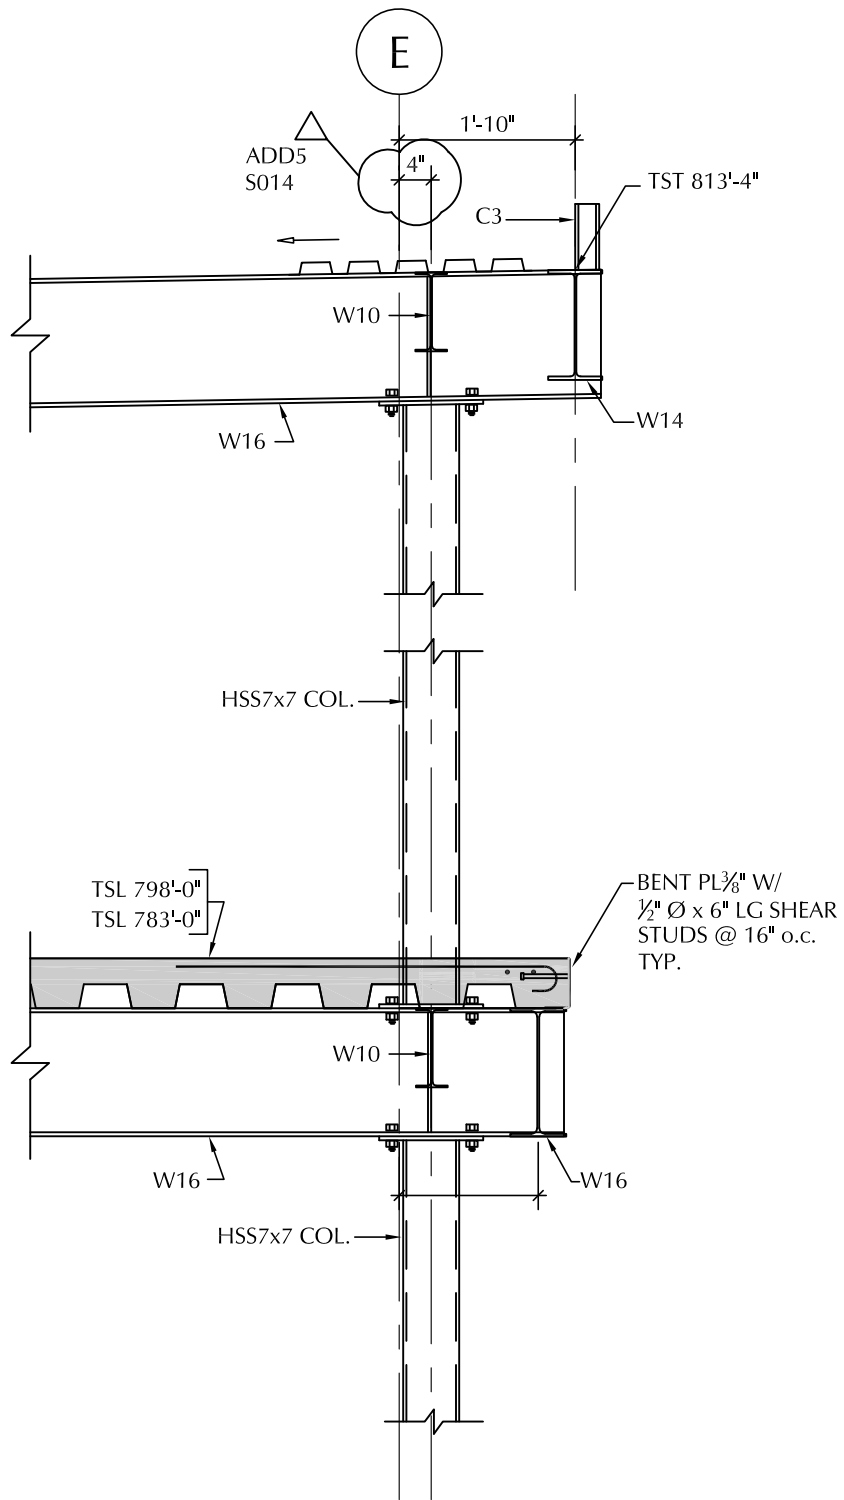

SECTION

SCALE: 1/2" = 1'-0"

8
S4.22

LAMOUREUX PAGANO
ASSOCIATES, ARCHITECTS
108 GROVE STREET, SUITE 300
WORCESTER, MASSACHUSETTS 01605

MEMBER OF
THE AMERICAN INSTITUTE OF ARCHITECTS

CLIENT INFORMATION:
Worcester Public Schools

City of Worcester
Massachusetts, 01605

PROJECT TITLE:
EARLY STRUCTURAL BID
PACKAGE #3

**South High
Community School**

170 Apricot Street, Worcester, MA 01603

DRAWING NAME:
Curtainwall Dimension
Coordination


DATE:
12/27/2018

SCALE:
As Noted

REFERENCE:

SHEET REF. NO.
S4.22

DRAWING NUMBER:
ADD-5
S014

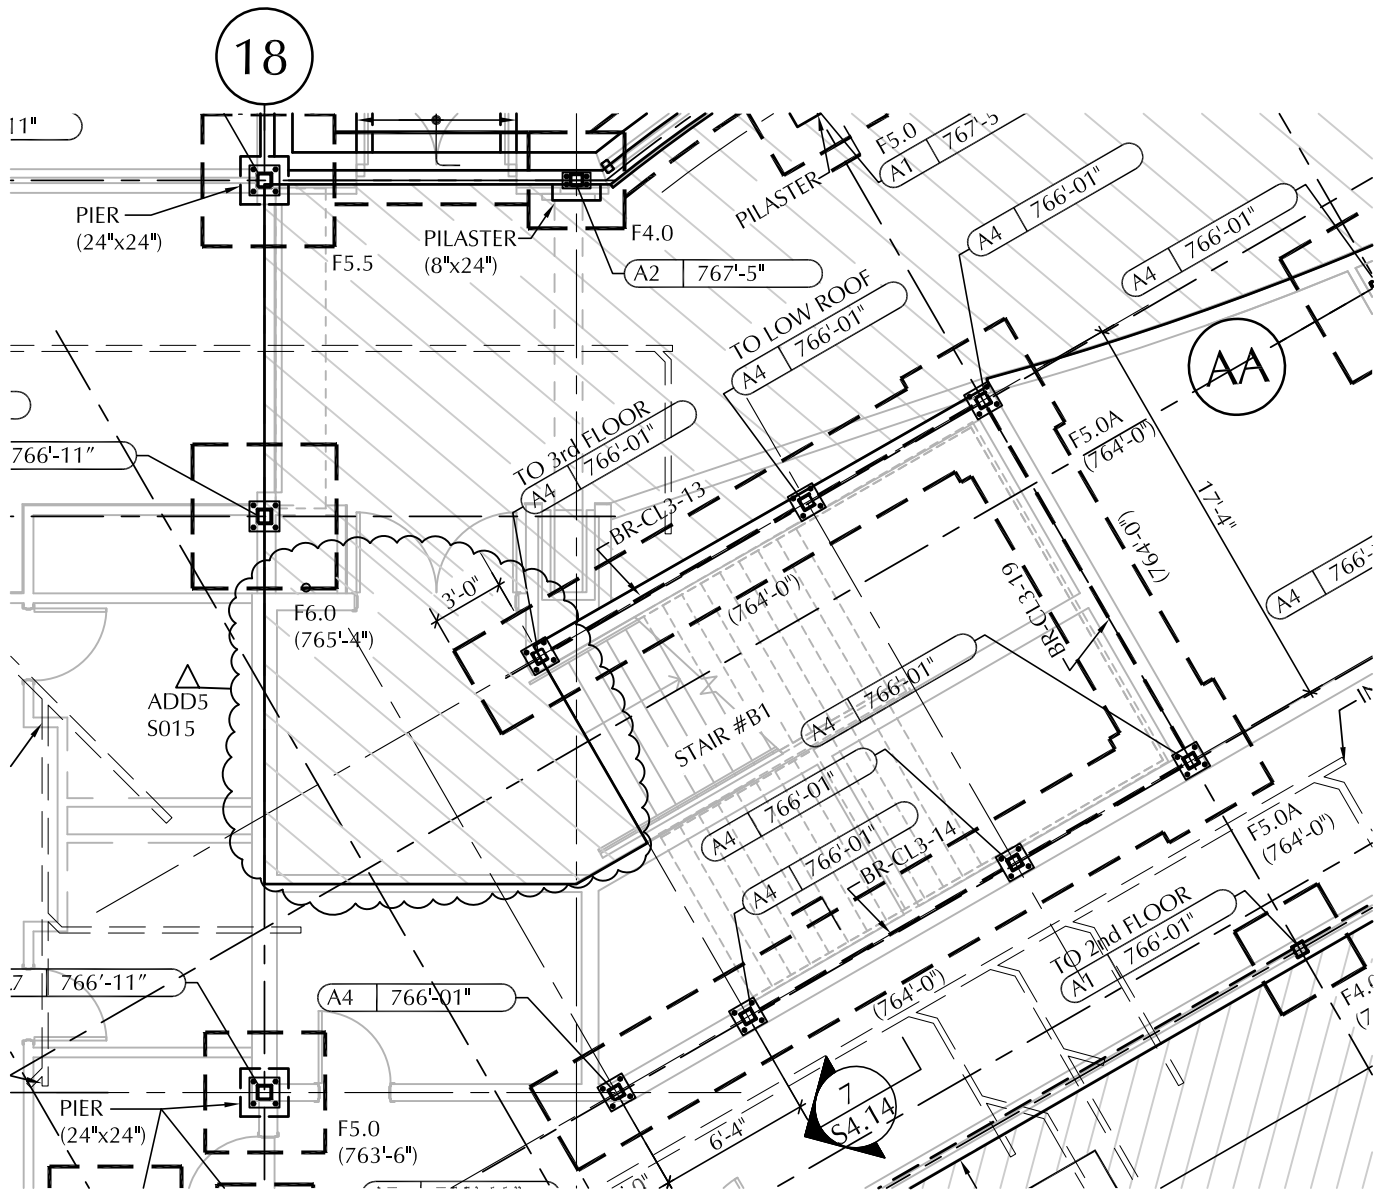

CLIENT INFORMATION:
Worcester Public Schools

City of Worcester
Massachusetts, 01605

PROJECT TITLE:
EARLY STRUCTURAL BID
PACKAGE #3

South High Community School

170 Apricot Street, Worcester, MA 01603

DRAWING NAME:
Slab-on-Grade Depression
Coordination


DATE:
12/27/2018

SCALE:
1/8" = 1'-0"



REFERENCE:

SHEET REF. NO.
S3.4

DRAWING NUMBER:
ADD-5
S015

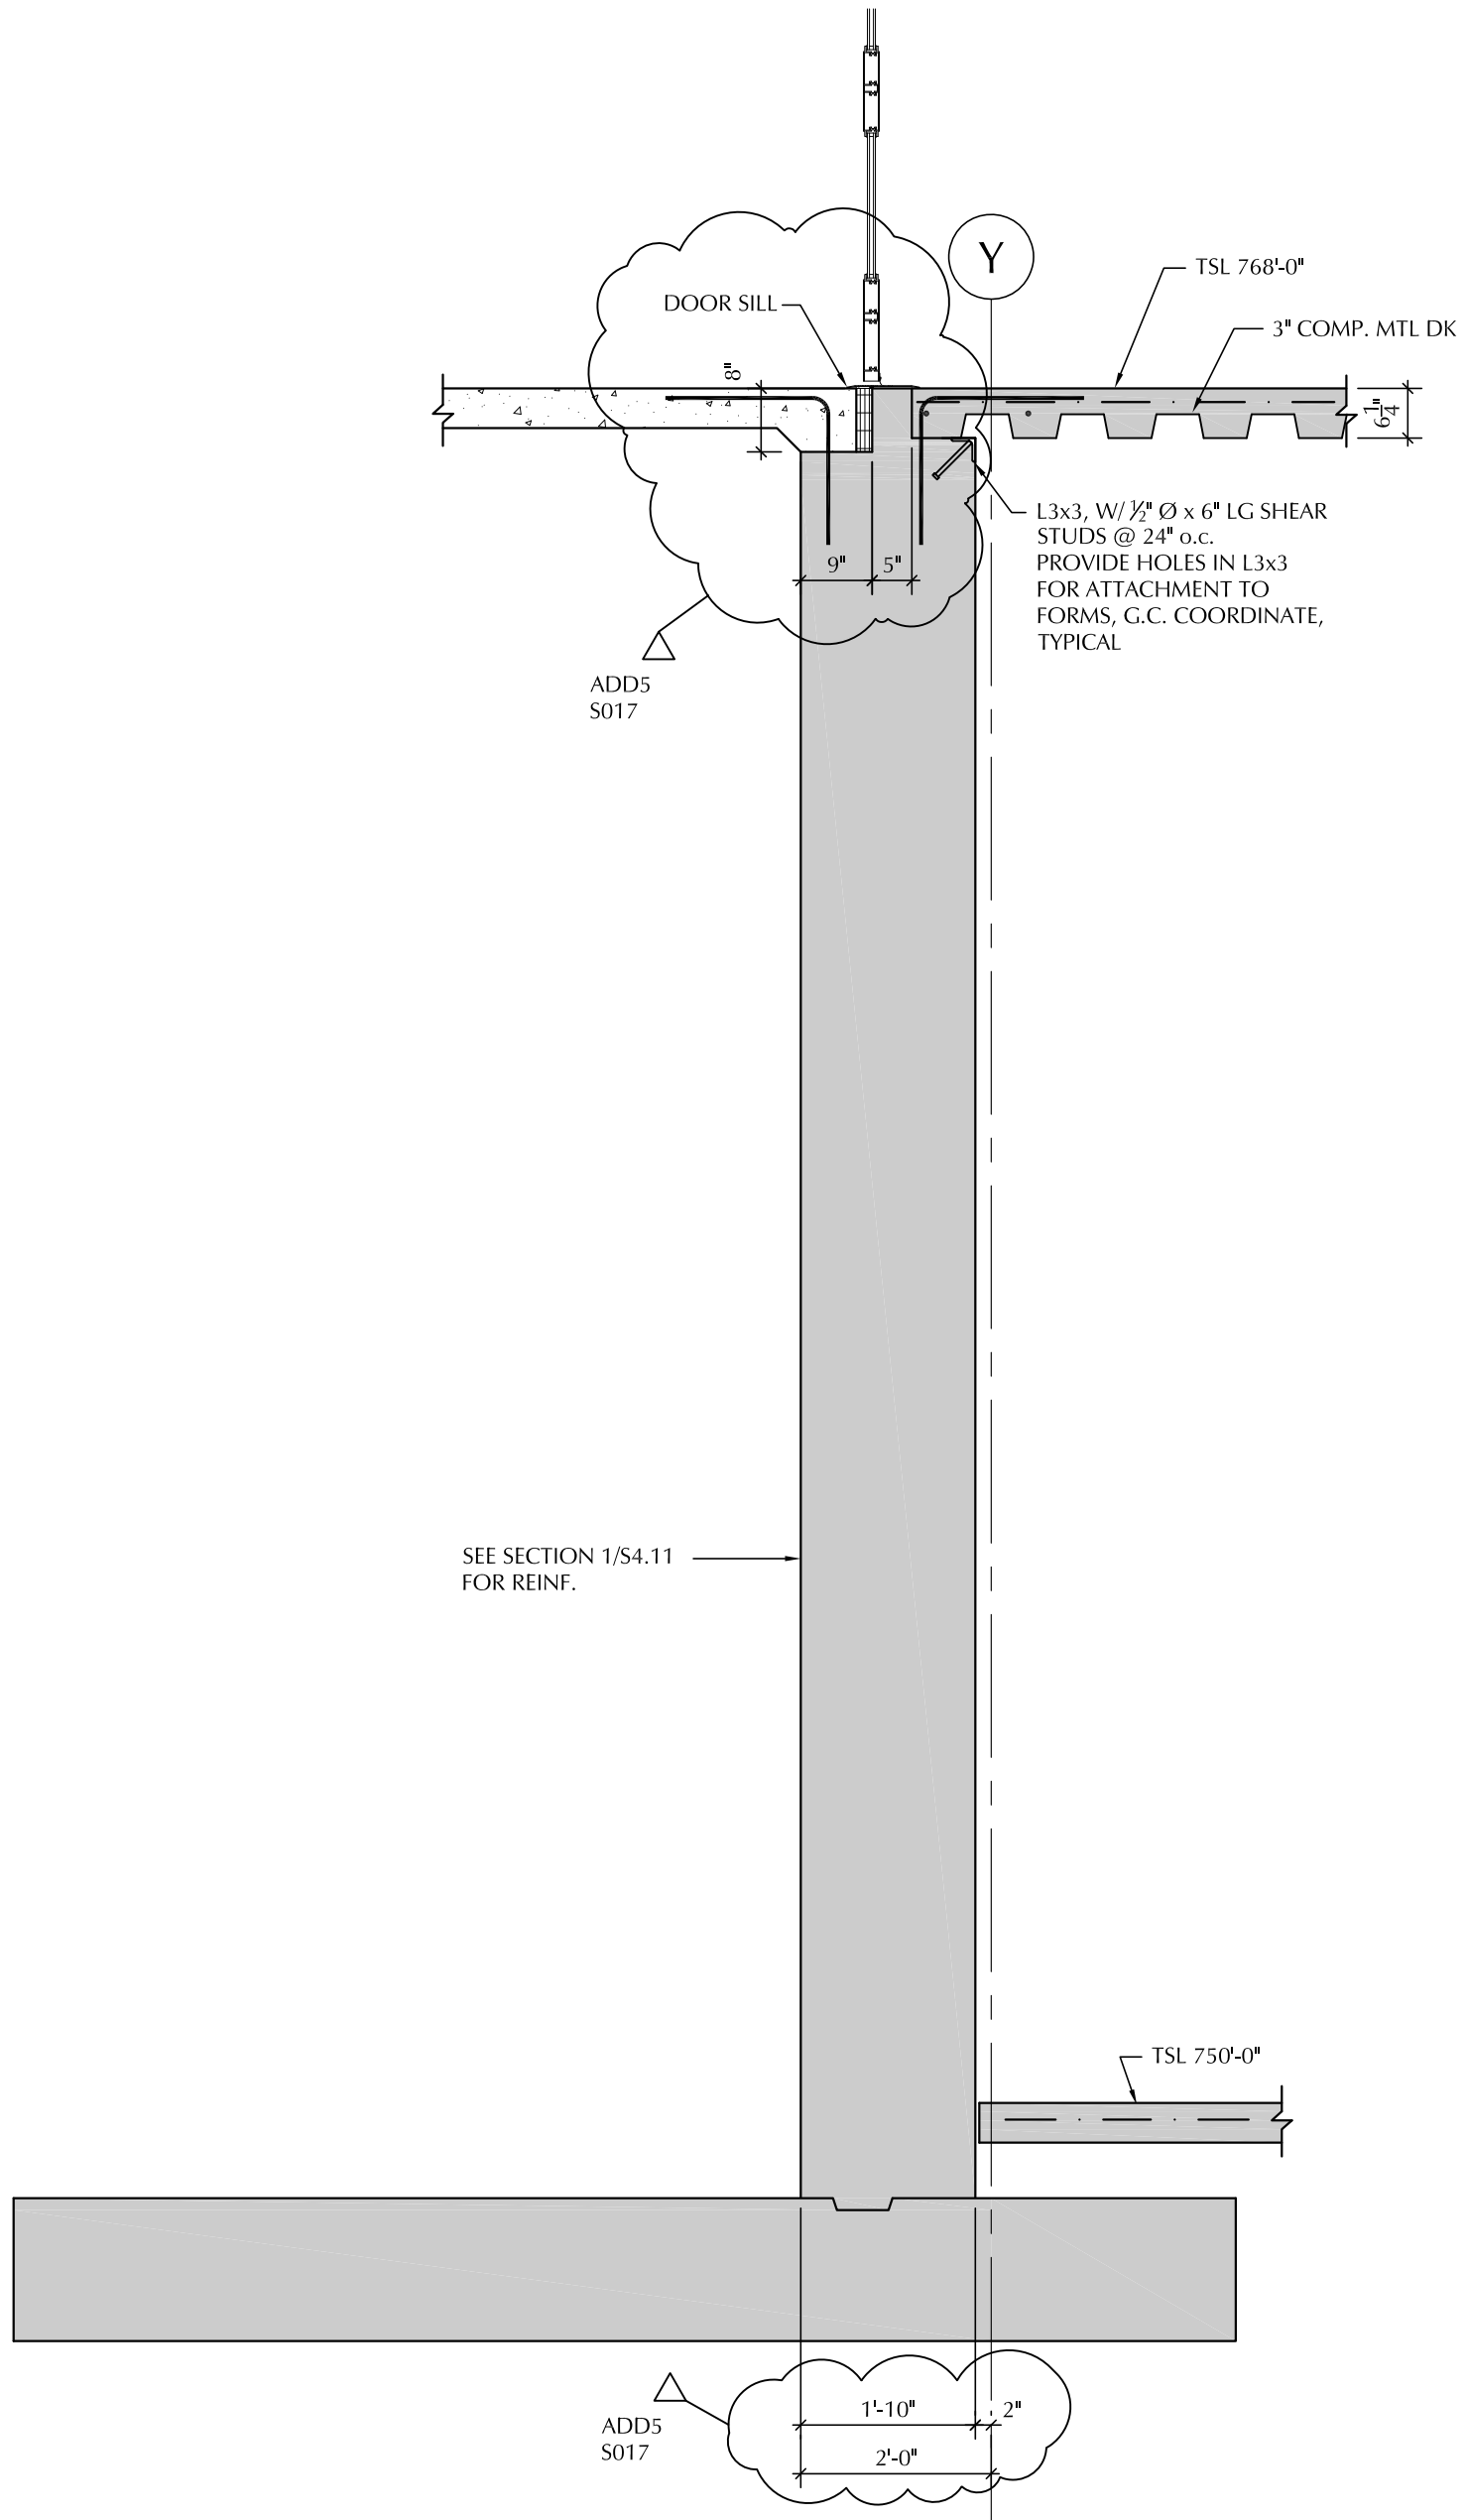

SECTION 11
 SCALE: 1/2" = 1'-0" S4.15

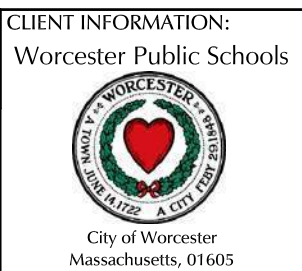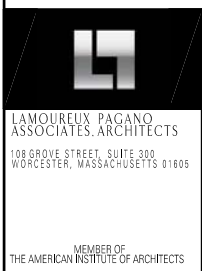


PROJECT TITLE:
EARLY STRUCTURAL BID PACKAGE #3

South High Community School


170 Apricot Street, Worcester, MA 01603

DRAWING NAME: Curtainwall Dimension Coordination		SHEET REF. NO. S4.15
DATE: 12/27/2018	DRAWING NUMBER: ADD-5	
SCALE: AS NOTED	S017	

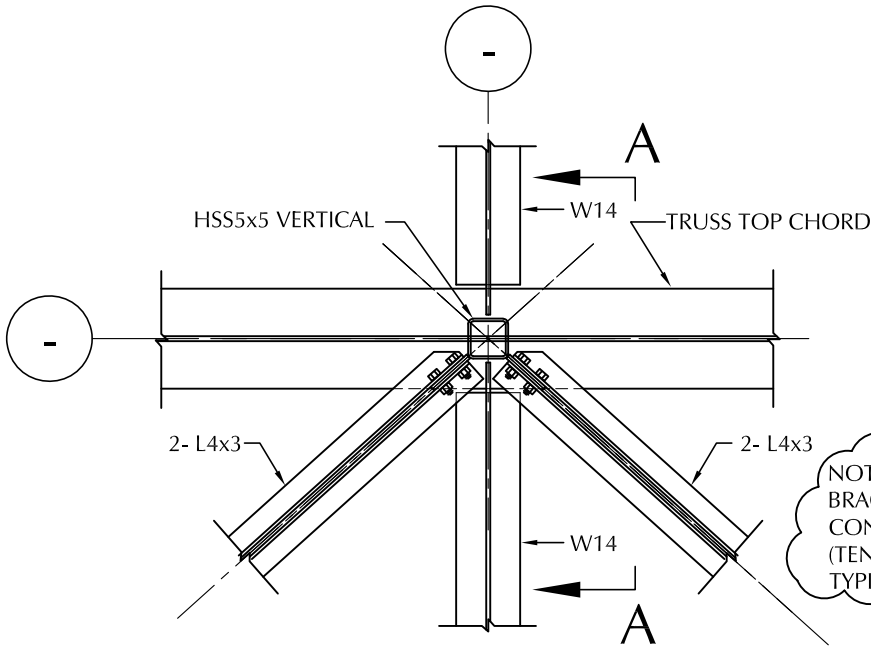

ADD5
S018

NOTE: DESIGN HORIZONTAL BRACING (2-L4x3) END CONNECTIONS FOR 30 kips (TENSION & COMPRESSION) TYPICAL

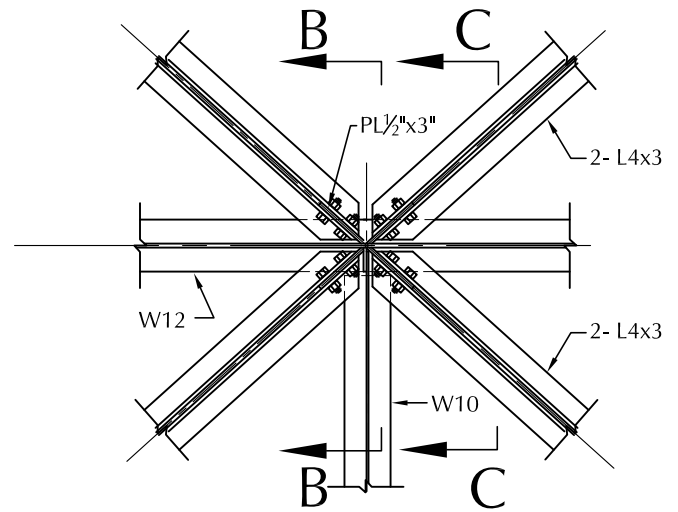

(REFLECTED PLAN)

PLAN A/S6.1

1/2" = 1'-0"

LAMOUREUX PAGANO ASSOCIATES, ARCHITECTS
108 GROVE STREET, SUITE 300
WORCESTER, MASSACHUSETTS 01605

MEMBER OF THE AMERICAN INSTITUTE OF ARCHITECTS

CLIENT INFORMATION:
Worcester Public Schools

City of Worcester
Massachusetts, 01605

PROJECT TITLE:
EARLY STRUCTURAL BID PACKAGE #3

South High Community School

170 Apricot Street, Worcester, MA 01603

DRAWING NAME:
Horizontal Bracing Connection Coordination

DATE:
12/27/2018

SCALE:
As Noted

REFERENCE:

SHEET REF. NO.
S6.1

DRAWING NUMBER:
ADD-5
S018